



Raster

PARENT PARCEL: 06-24-060-102-002, -003

CHILD PARCEL: _____

STARTING POINT: S/L 15 IN BESTY AUSTIN'S ADD. (VOL.2 PG.20)

11-02333-C

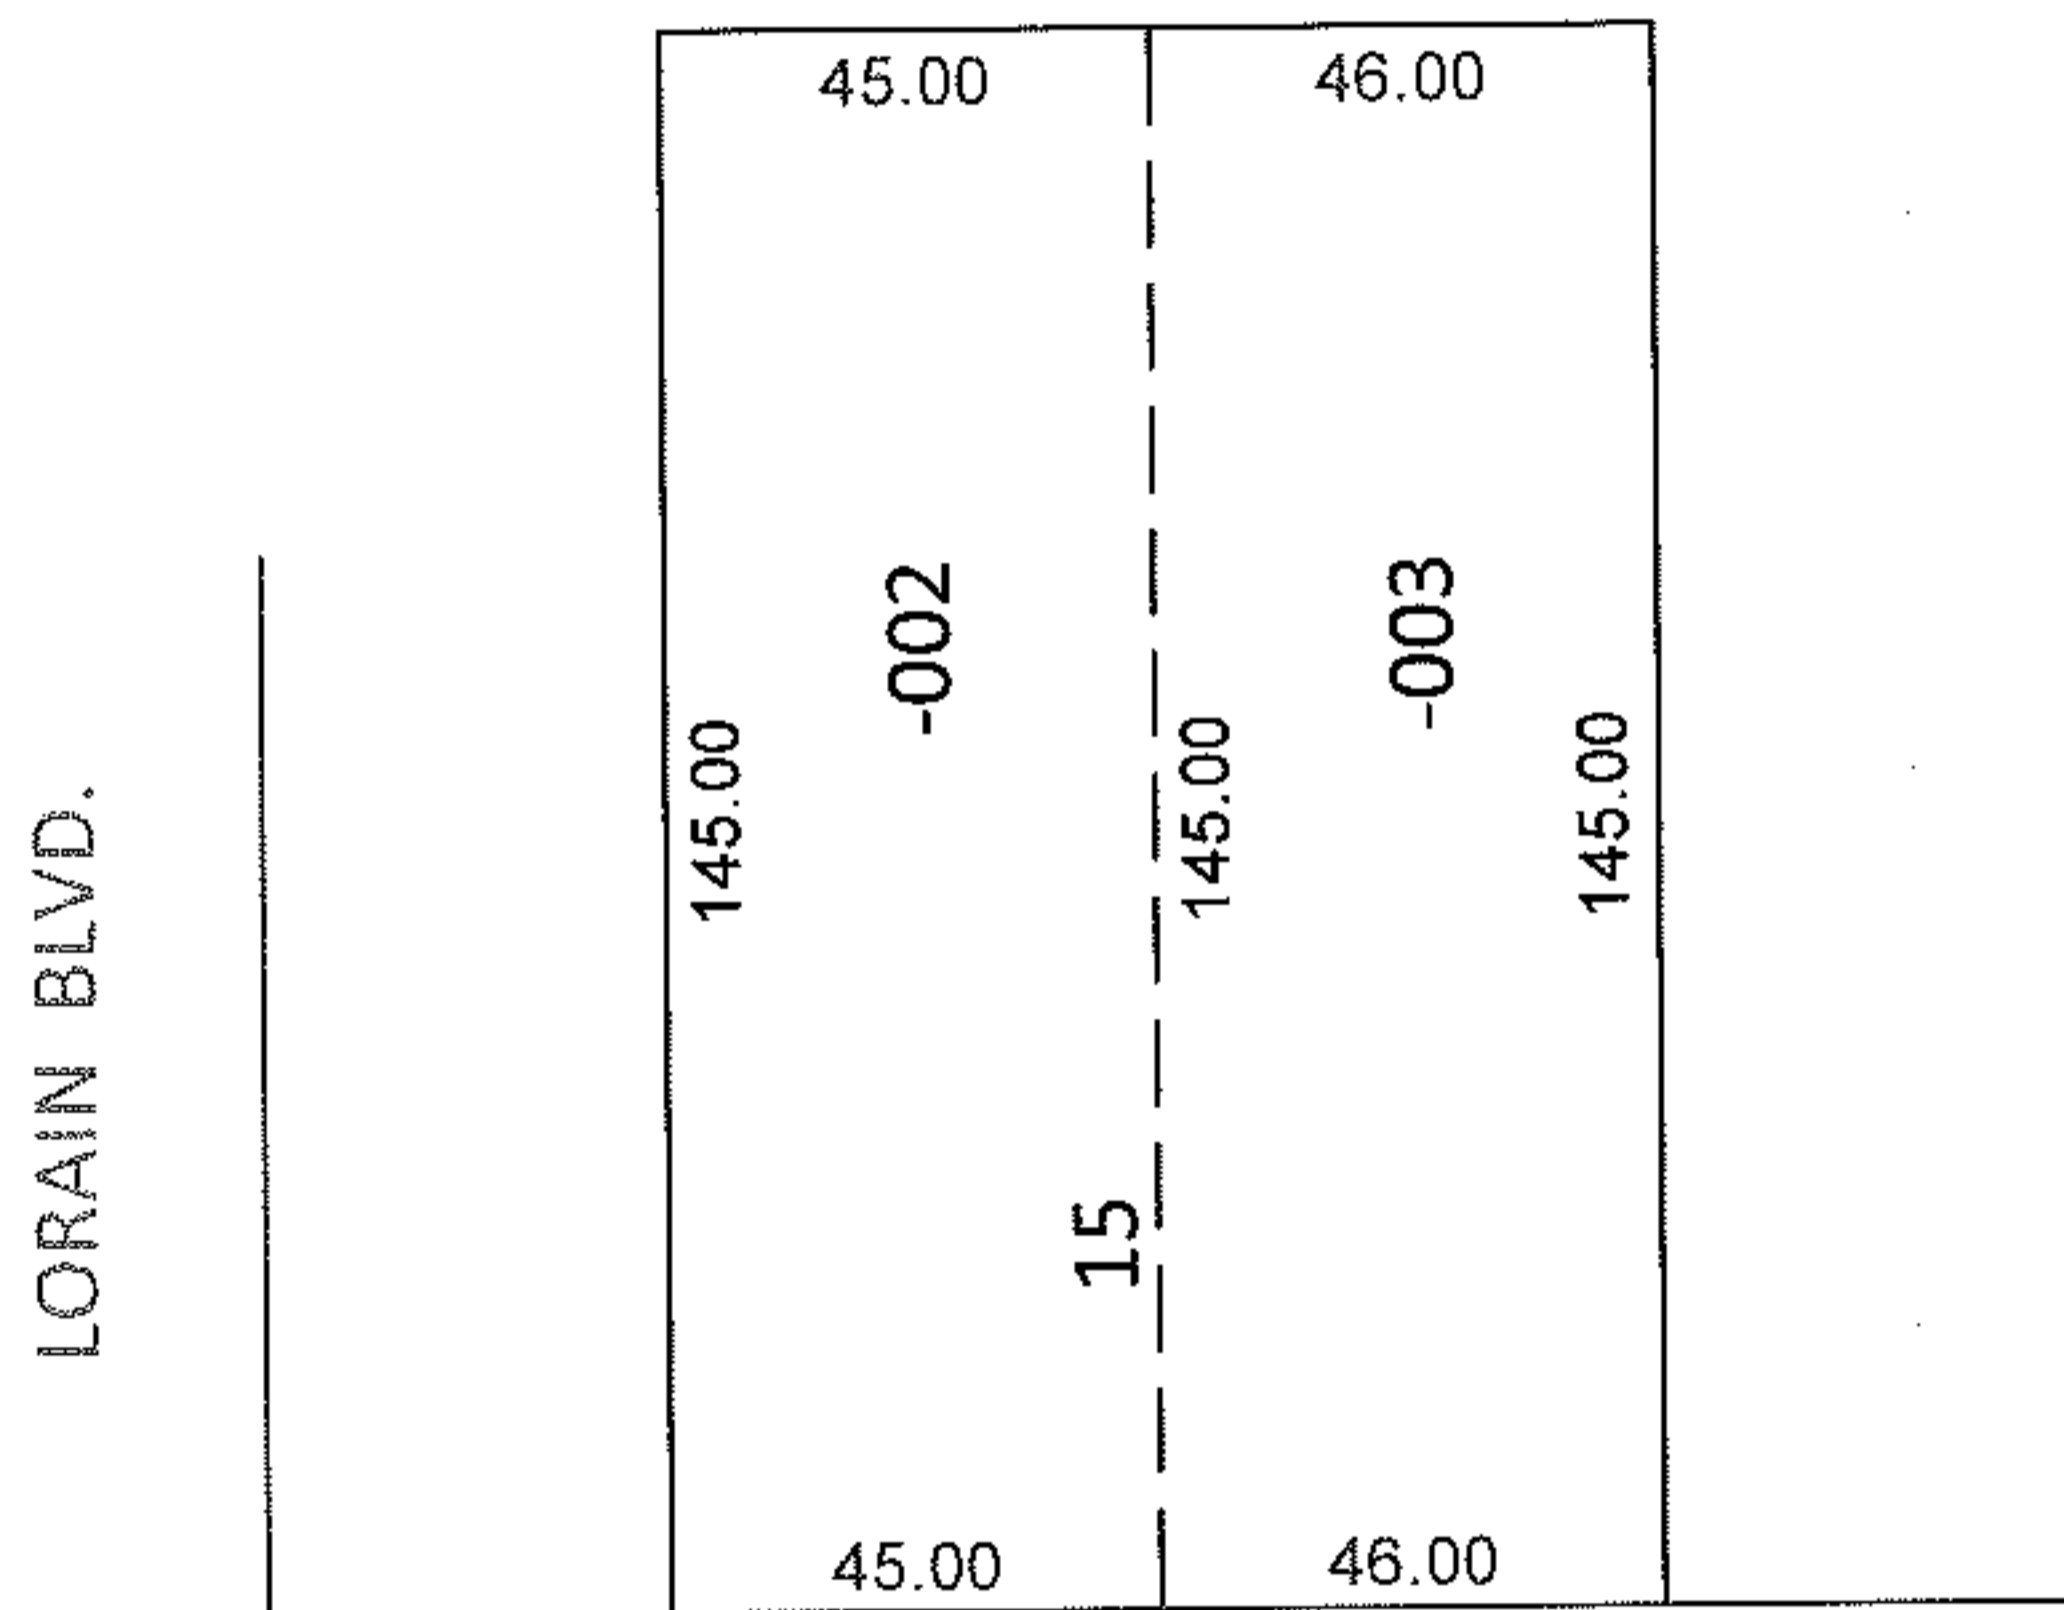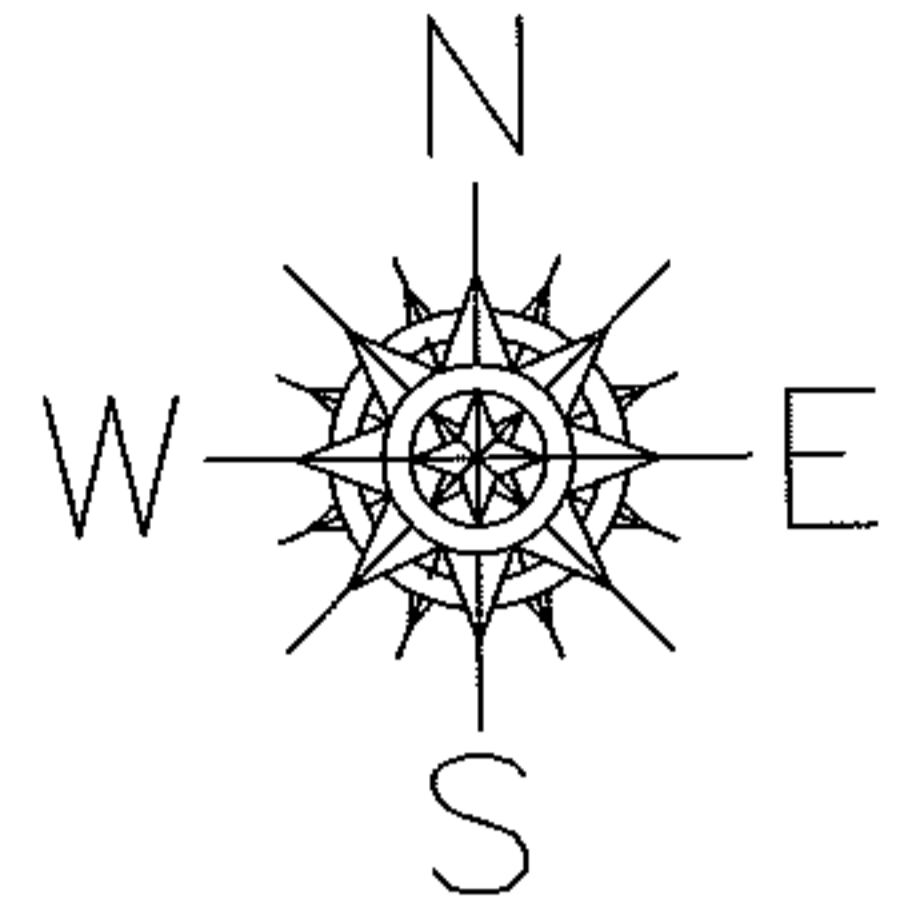

FRONTAGE CORRECTION

06-24-060-102-002


06-24-060-102-003

45
~~48~~ X 145

46
~~43~~ X 145

PER PRIOR DEEDS

*DV 78/586
20090307443

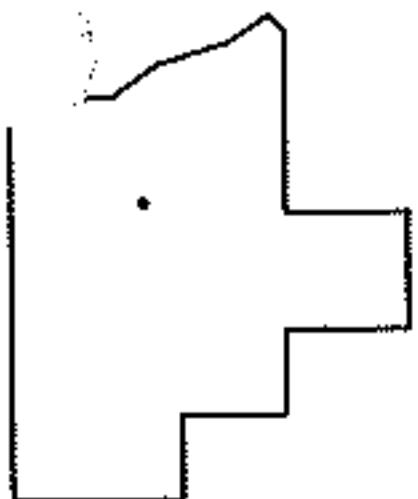

SPLITS/DEEDS PROCESSED

LORAIN COUNTY TAX MAP DEPARTMENT
226 MIDDLE AVE. ELYRIA, OHIO

SURVEYED BY: N/A

CLOSURE: N/A

MAP PAGE(S): 6-100

APPROVED BY: RRM DATE: 8-9-11

SCALE: 1" = 50' PRIOR INST.: *SEE ABOVE