
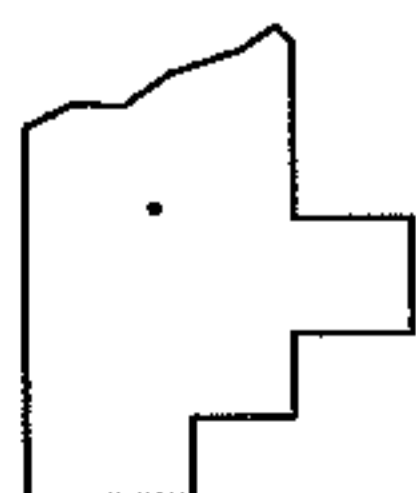
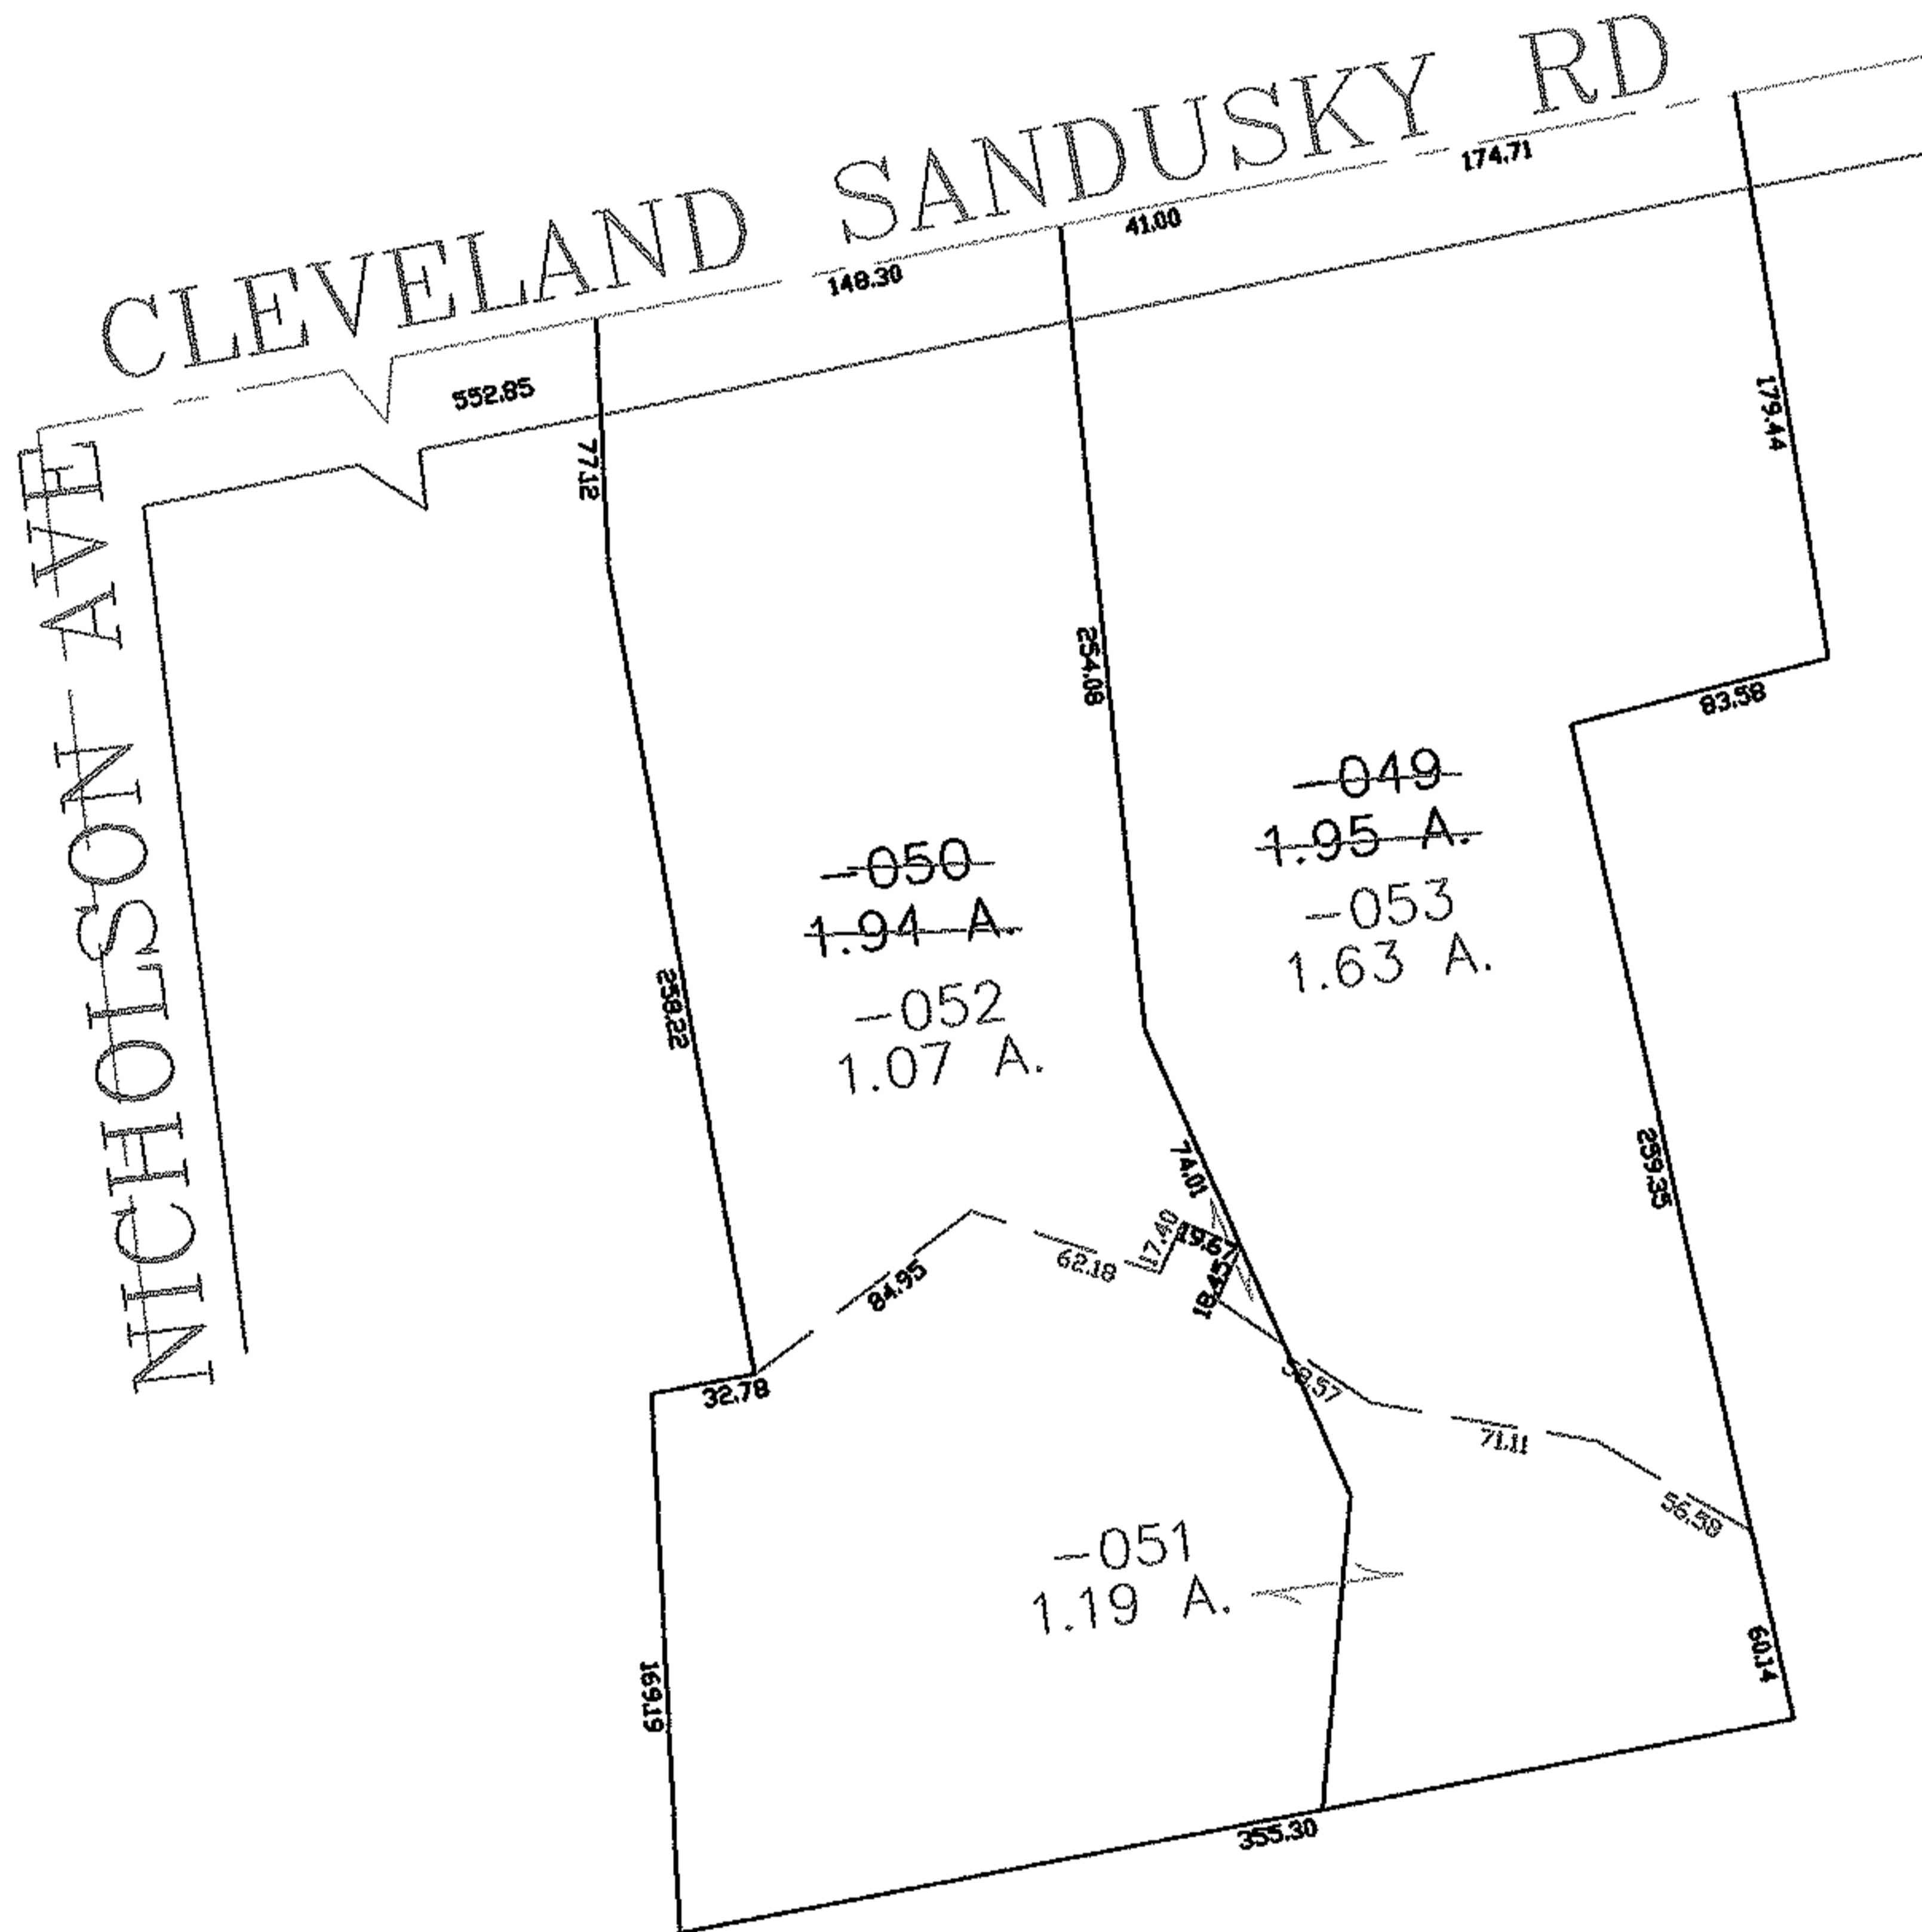


PARENT PARCEL: 01-00-006-102-049, -050

CHILD PARCEL: 01-00-006-102-051 THRU -053

STARTING POINT: CENTERLINE OF CLEVELAND SANDUSKY RD & NICHOLSON AVE

07-02337

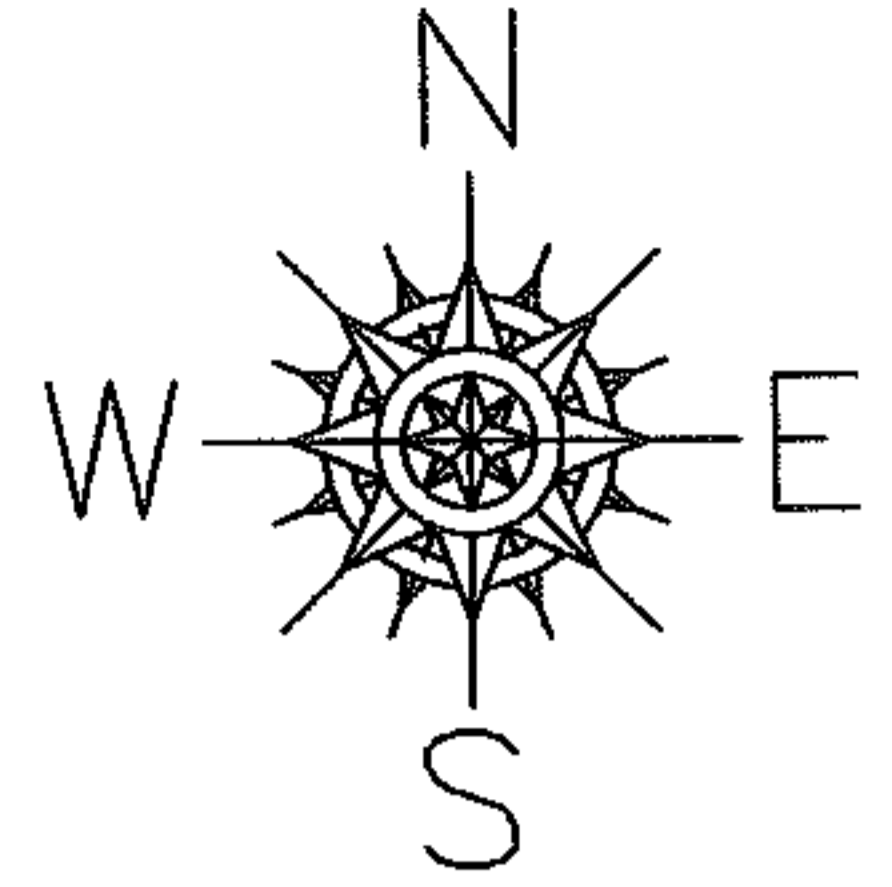

SPLITS/DEEDS PROCESSED

LORAIN COUNTY TAX MAP DEPARTMENT
226 MIDDLE AVE. ELYRIA, OHIO

SURVEYED BY: THOMAS SNEZEK
 CLOSURE: 0.00 : 10.000
 MAP PAGE(S): 01-00-006-B
 APPROVED BY: JAH DATE: 3-9-07
 SCALE: 1" = 100 PRIOR INSTRUMENT: 19990656640