



RASTER

PARENT PARCEL: 05-00-021-103-045

CHILD PARCEL: 05-00-021-103-046, -047

STARTING POINT: CENTERLINE OF COOPER FOSTER PARK RD & KOLBE RD


07-02338

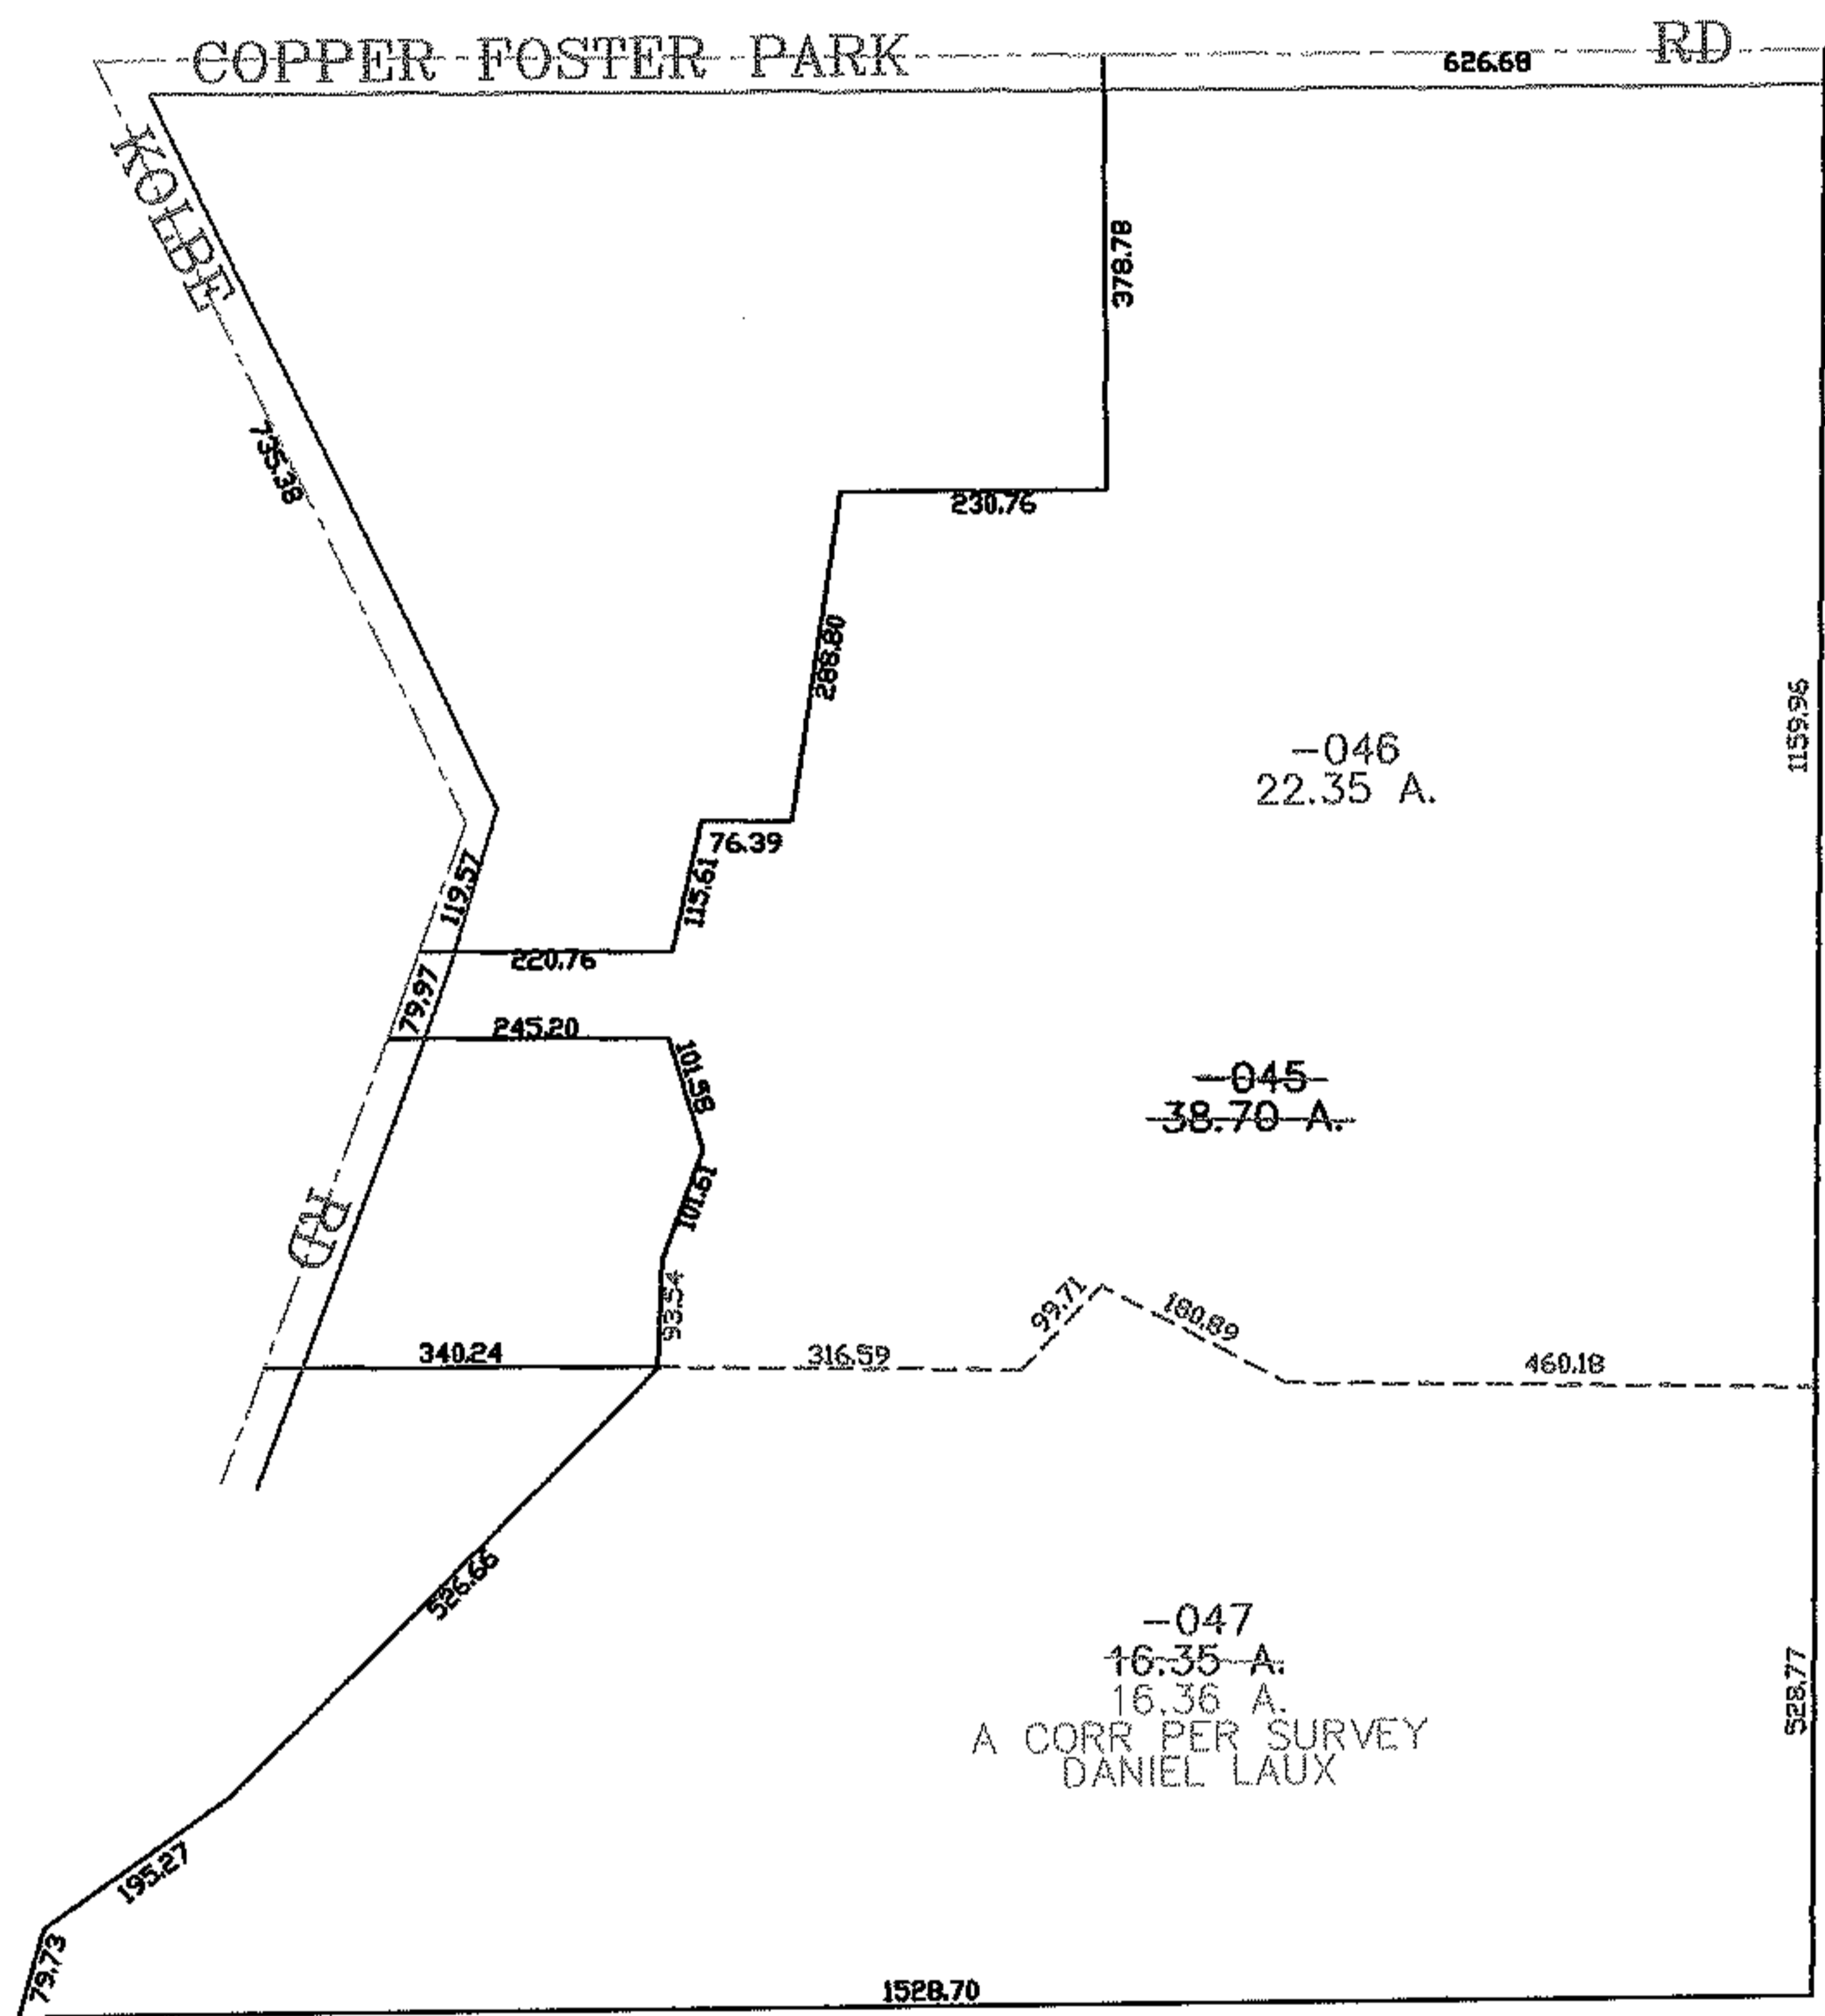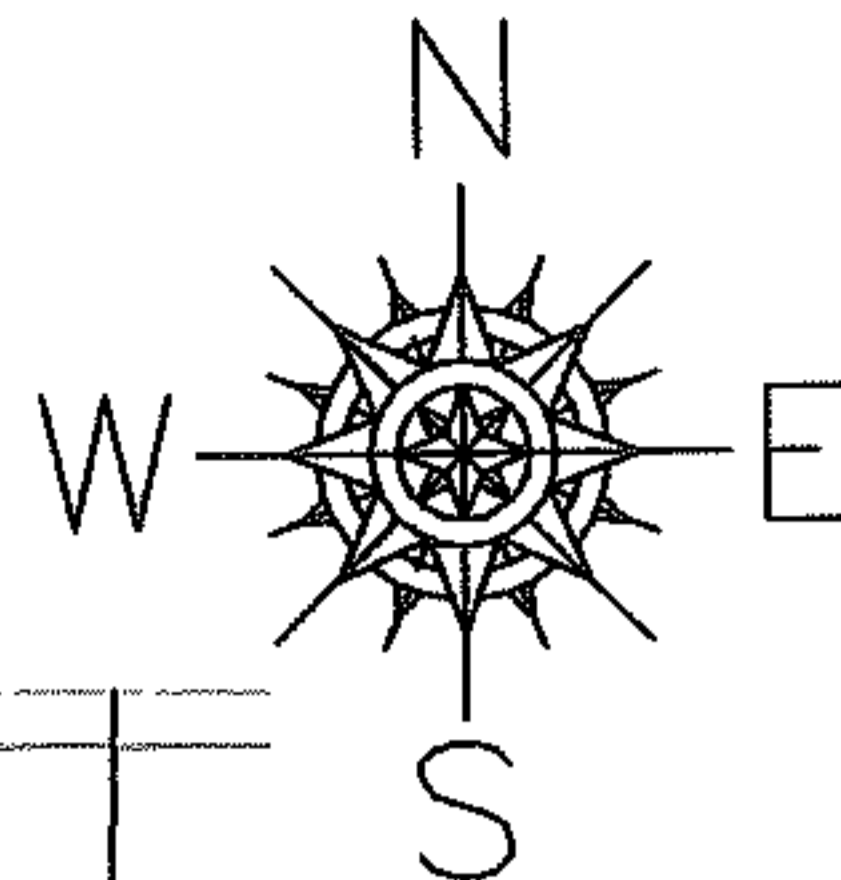

-046
22.35 A.

-045-
38.70 A.

-047
16.35 A.
16.36 A.
A CORR PER SURVEY
DANIEL LAUX

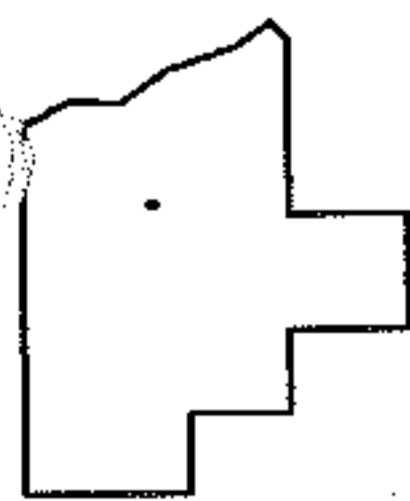

SPLITS/DEEDS PROCESSED
LORAIN COUNTY TAX MAP DEPARTMENT
226 MIDDLE AVE. ELYRIA, OHIO

SURVEYED BY: DANIEL LAUX
CLOSURE: 0.00 : 10.000
MAP PAGE(S): 05-00-021-B
APPROVED BY: JAH DATE: 3-12-07
SCALE: 1" = 300 PRIOR INSTRUMENT: 20060121418