
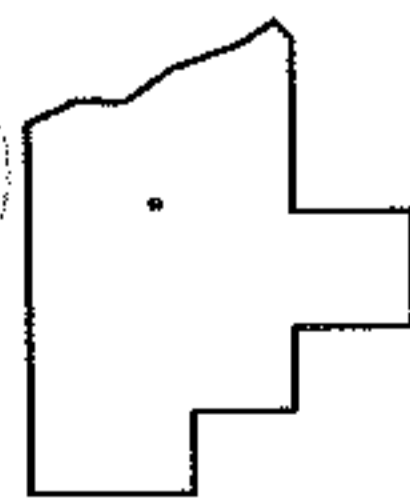
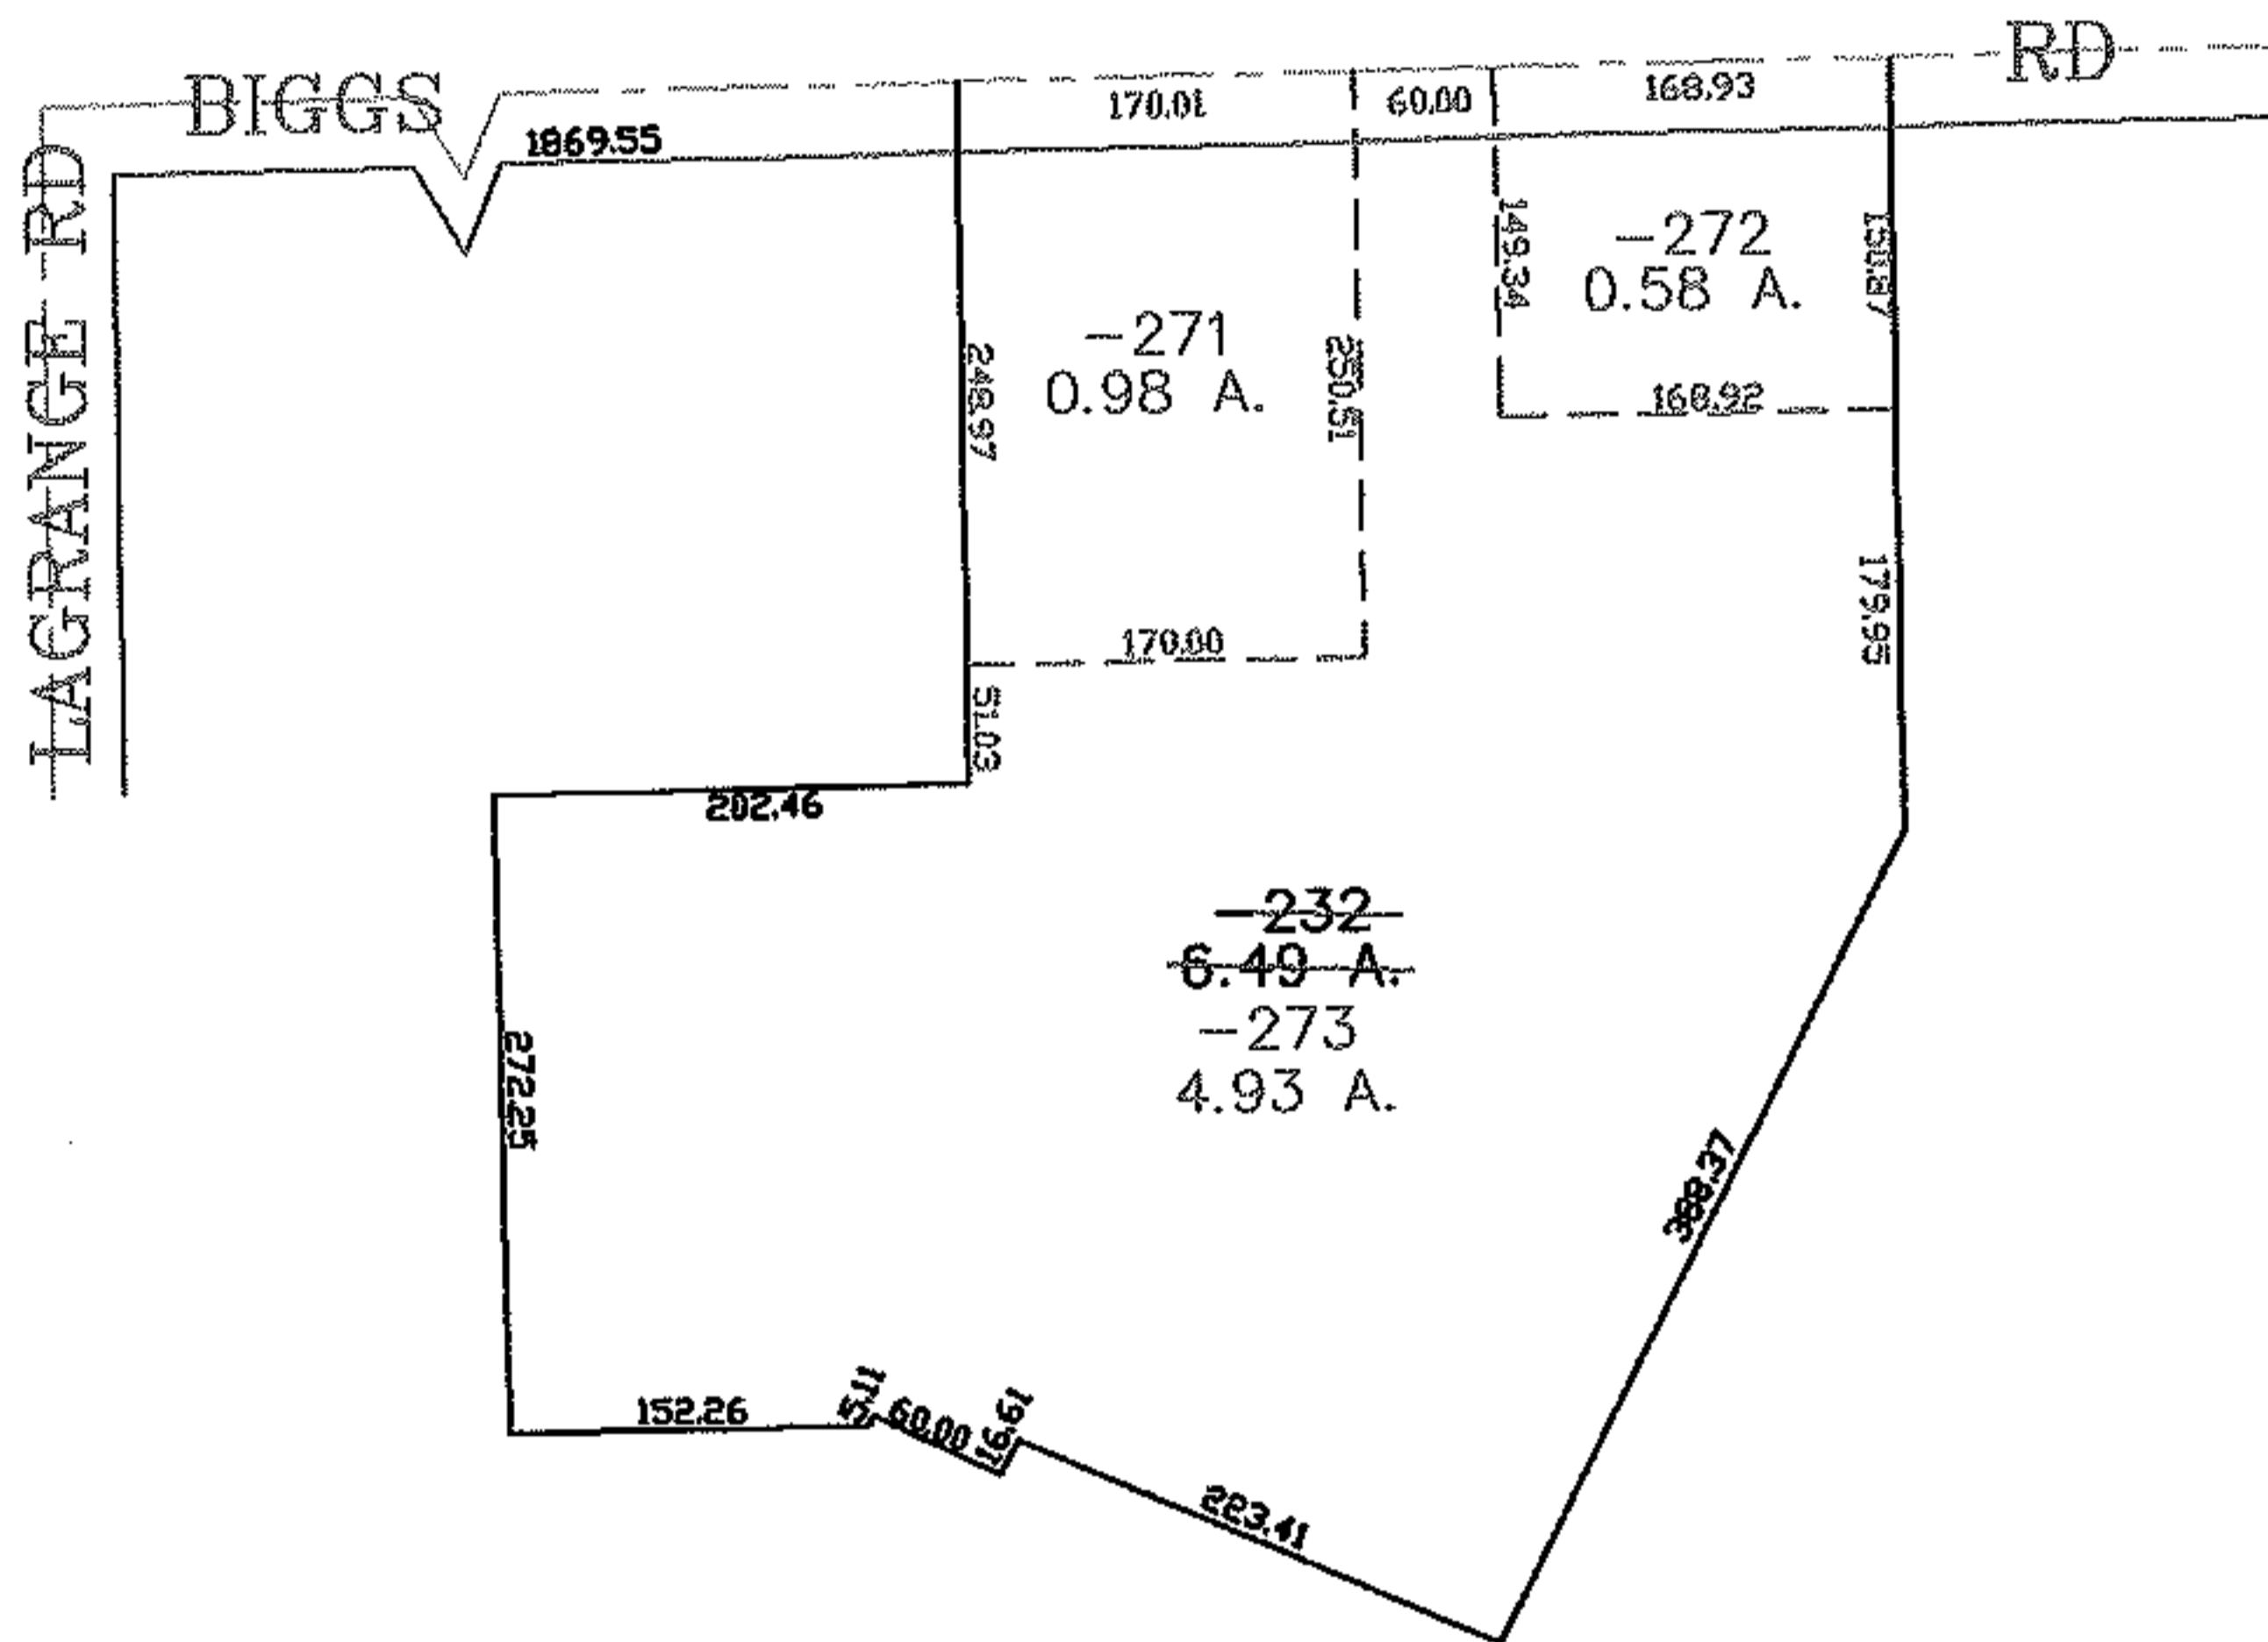


PARENT PARCEL: 15-00-035-000-232

CHILD PARCEL: 15-00-035-000-271 THRU -273

STARTING POINT: CENTERLINE OF BIGGS RD & LAGRANGE RD

07-02339

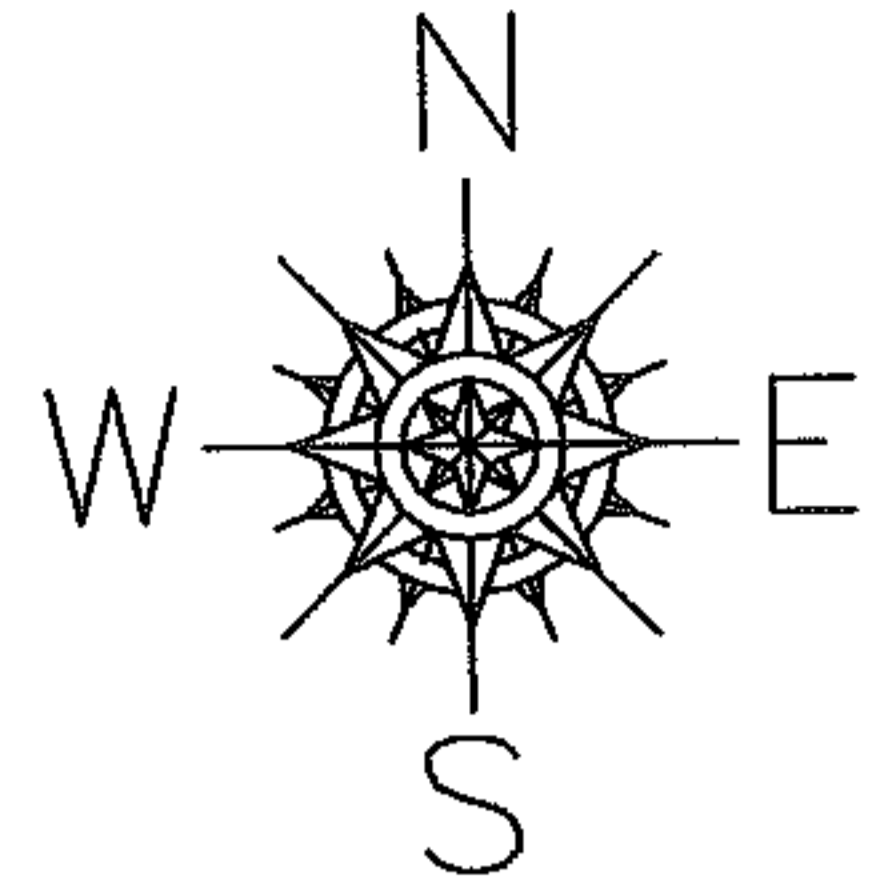

SPLITS/DEEDS PROCESSED
LORAIN COUNTY TAX MAP DEPARTMENT
226 MIDDLE AVE. ELYRIA, OHIO

SURVEYED BY: CHRISTOPHER HIRZEL
CLOSURE: 0.00 ; 10.000
MAP PAGE(S): 15-00-035-B
APPROVED BY: JAH DATE: 3-12-07
SCALE: 1" = 200 PRIOR INSTRUMENT: 20020833942