


PARENT PARCEL: 02-02-012-101-030



CHILD PARCEL: 02-02-012-101-091, -092

STARTING POINT: SIDELINE OF PARKSIDE CIRCLE & S/L 5 OF PARKSIDE AT MARTINS RUN

07-02340

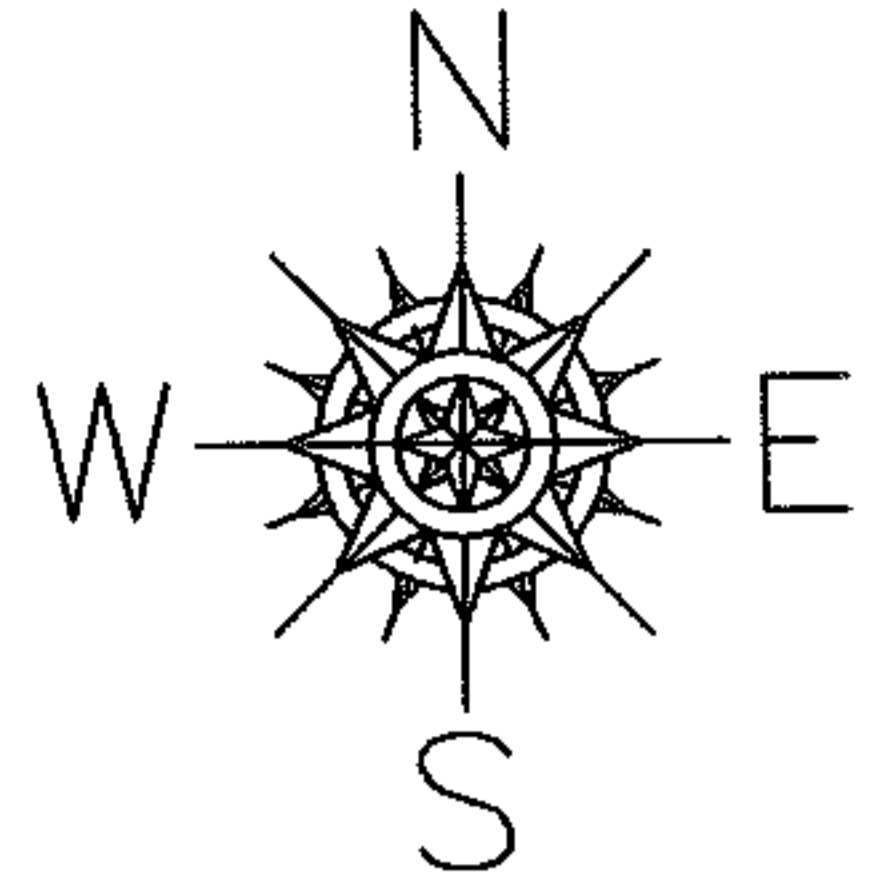

PARKSIDE AT MARTIN'S RUN  
VOL 91/17, 18

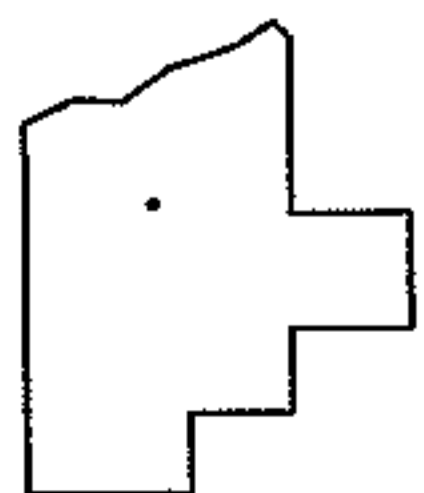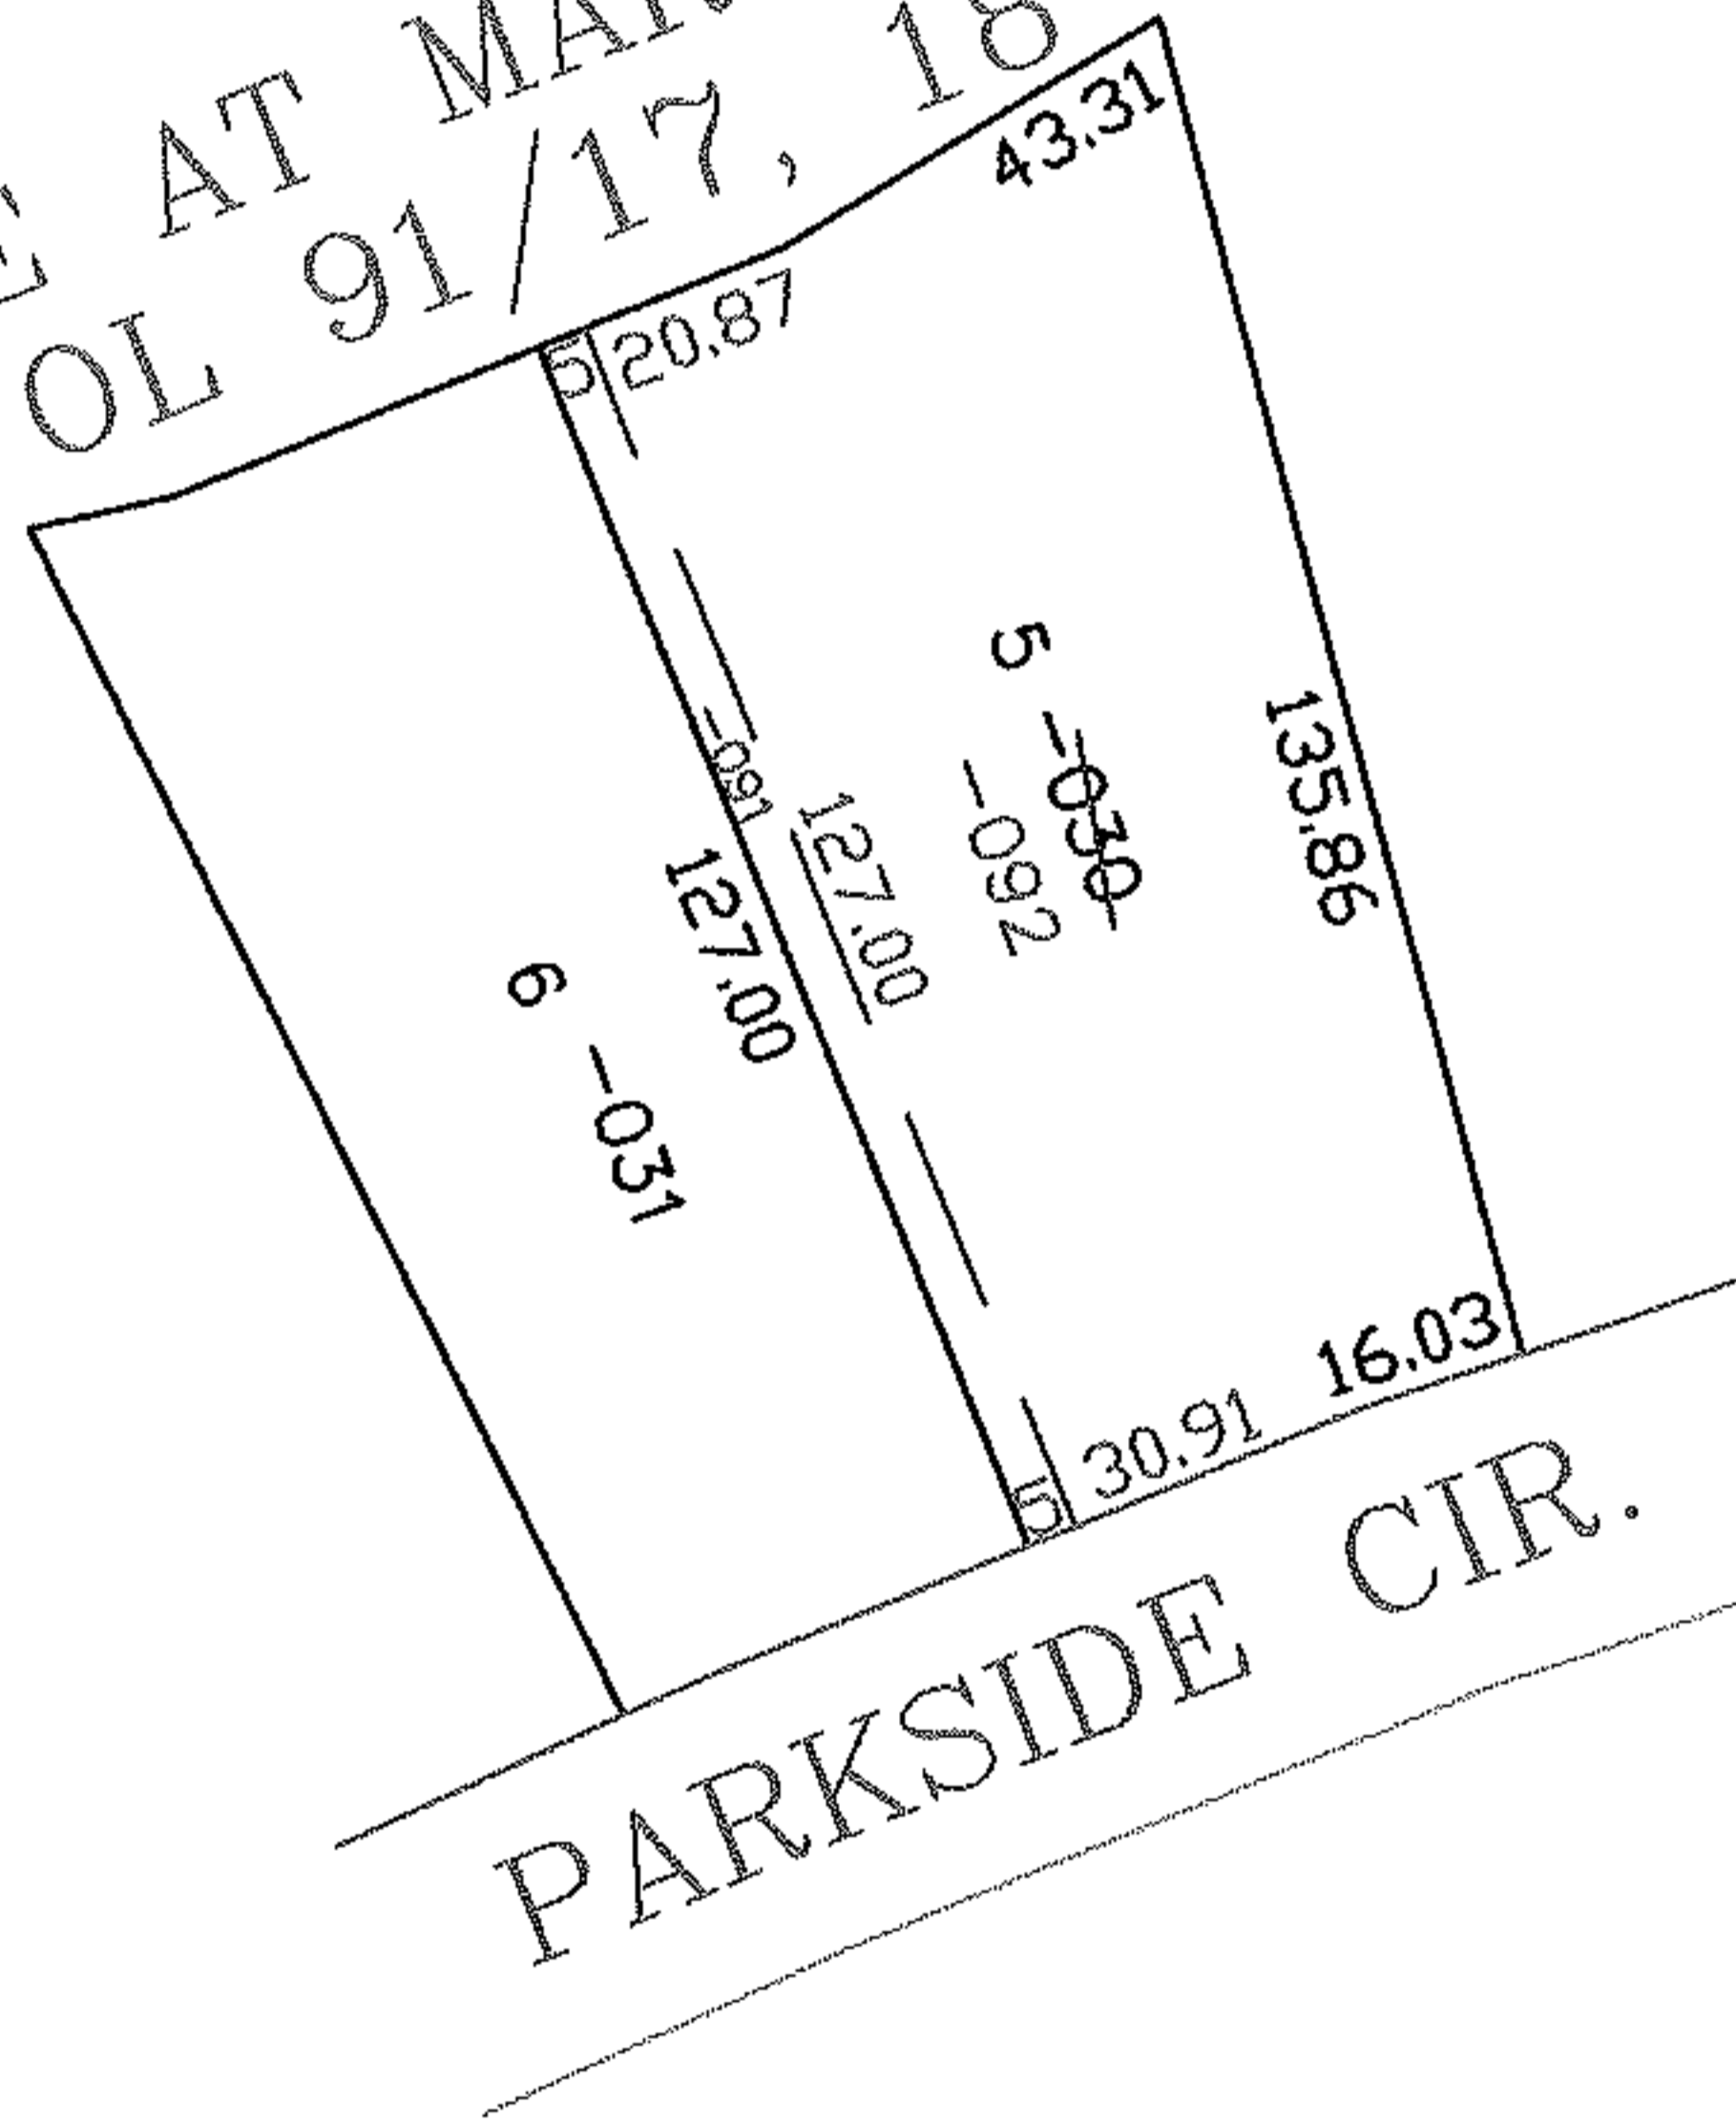

**SPLITS/DEEDS PROCESSED**  
LORAIN COUNTY TAX MAP DEPARTMENT  
226 MIDDLE AVE. ELYRIA, OHIO

SURVEYED BY: DAVE ELWELL  
CLOSURE: 0.00 : 10.000  
MAP PAGE(S): 02-02-012-A  
APPROVED BY: JAH DATE: 3-12-07  
SCALE: 1" = 100 PRIOR INSTRUMENT: 20050073955