
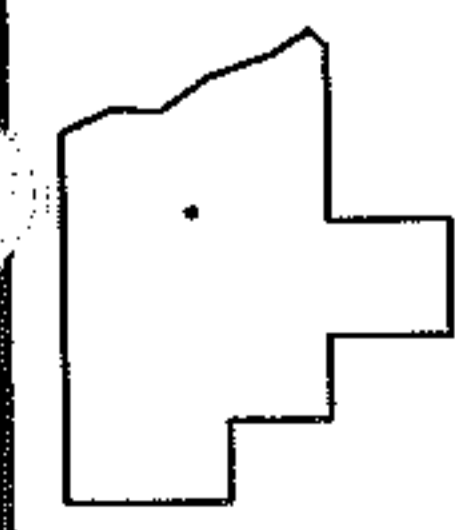
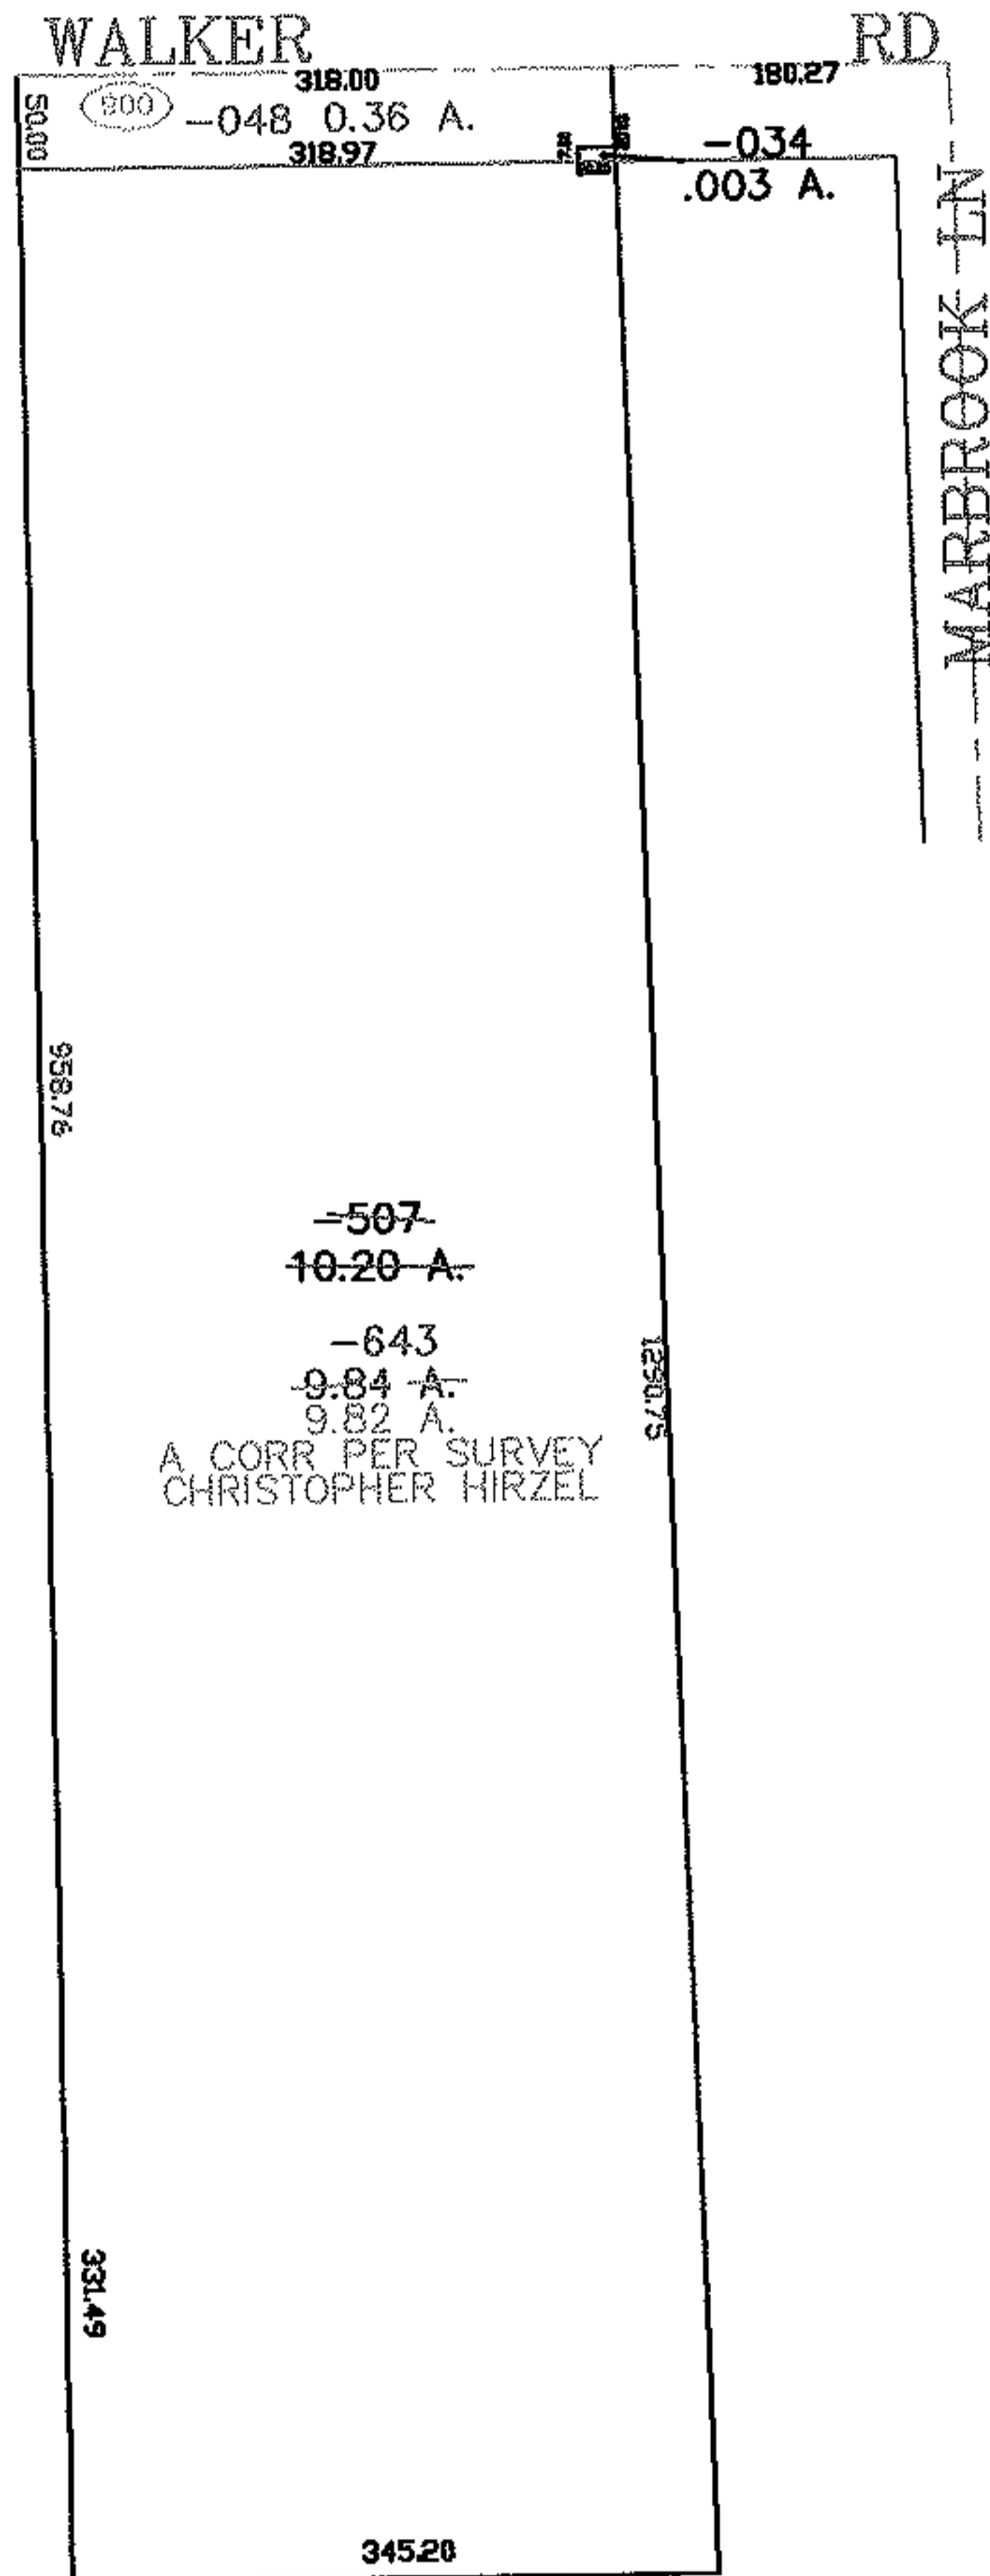


PARENT PARCEL: 04-00-020-104-507

07-02341

CHILD PARCEL: 04-00-020-900-048, 04-00-020-104-643

STARTING POINT: CENTERLINE OF WALKER RD & MARBROOK LN

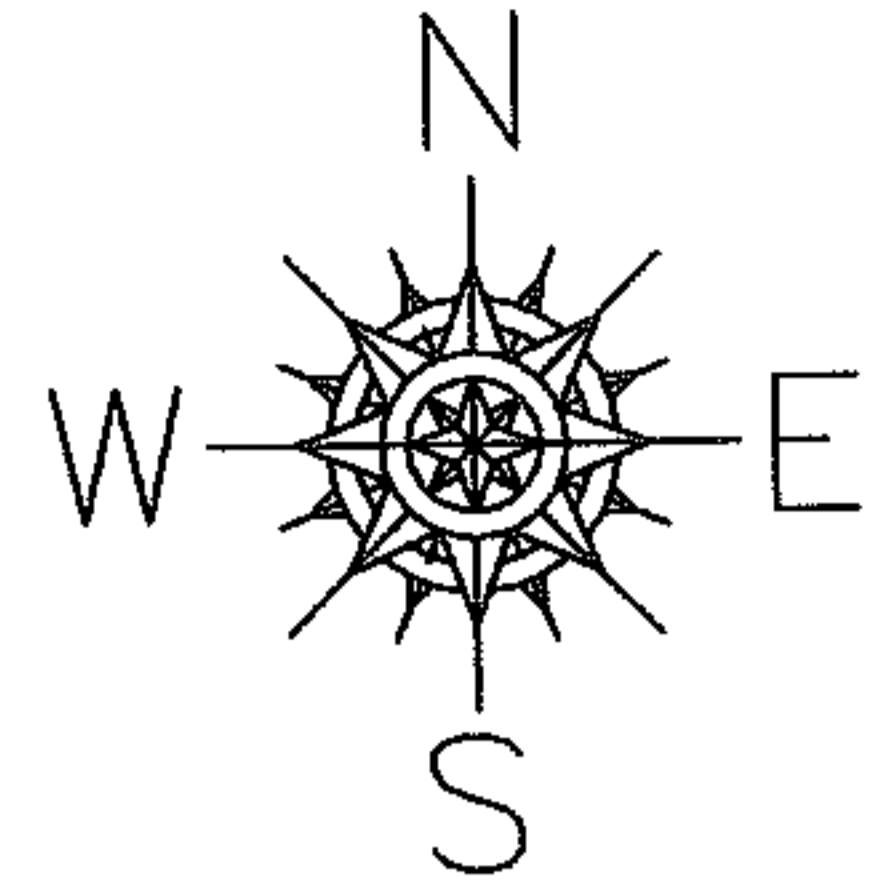

**SPLITS/DEEDS PROCESSED**

LORAIN COUNTY TAX MAP DEPARTMENT  
226 MIDDLE AVE. ELYRIA, OHIO

SURVEYED BY: CHRISTOPHER HIRZEL

CLOSURE: 0.00 : 10.000

MAP PAGE(S): 04-00-020-D

APPROVED BY: JAH DATE: 3-16-07

SCALE: 1" = 200 PRIOR INSTRUMENT: OR 934/462