




RASTER

PARENT PARCEL: 04-00-030-139-056

CHILD PARCEL: 04-00-030-139-077, -078

STARTING POINT: CENTERLINE OF HIGHLAND AVE & ELECTRIC BLVD

07-02342

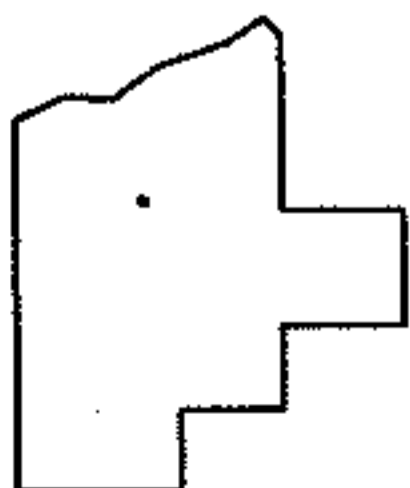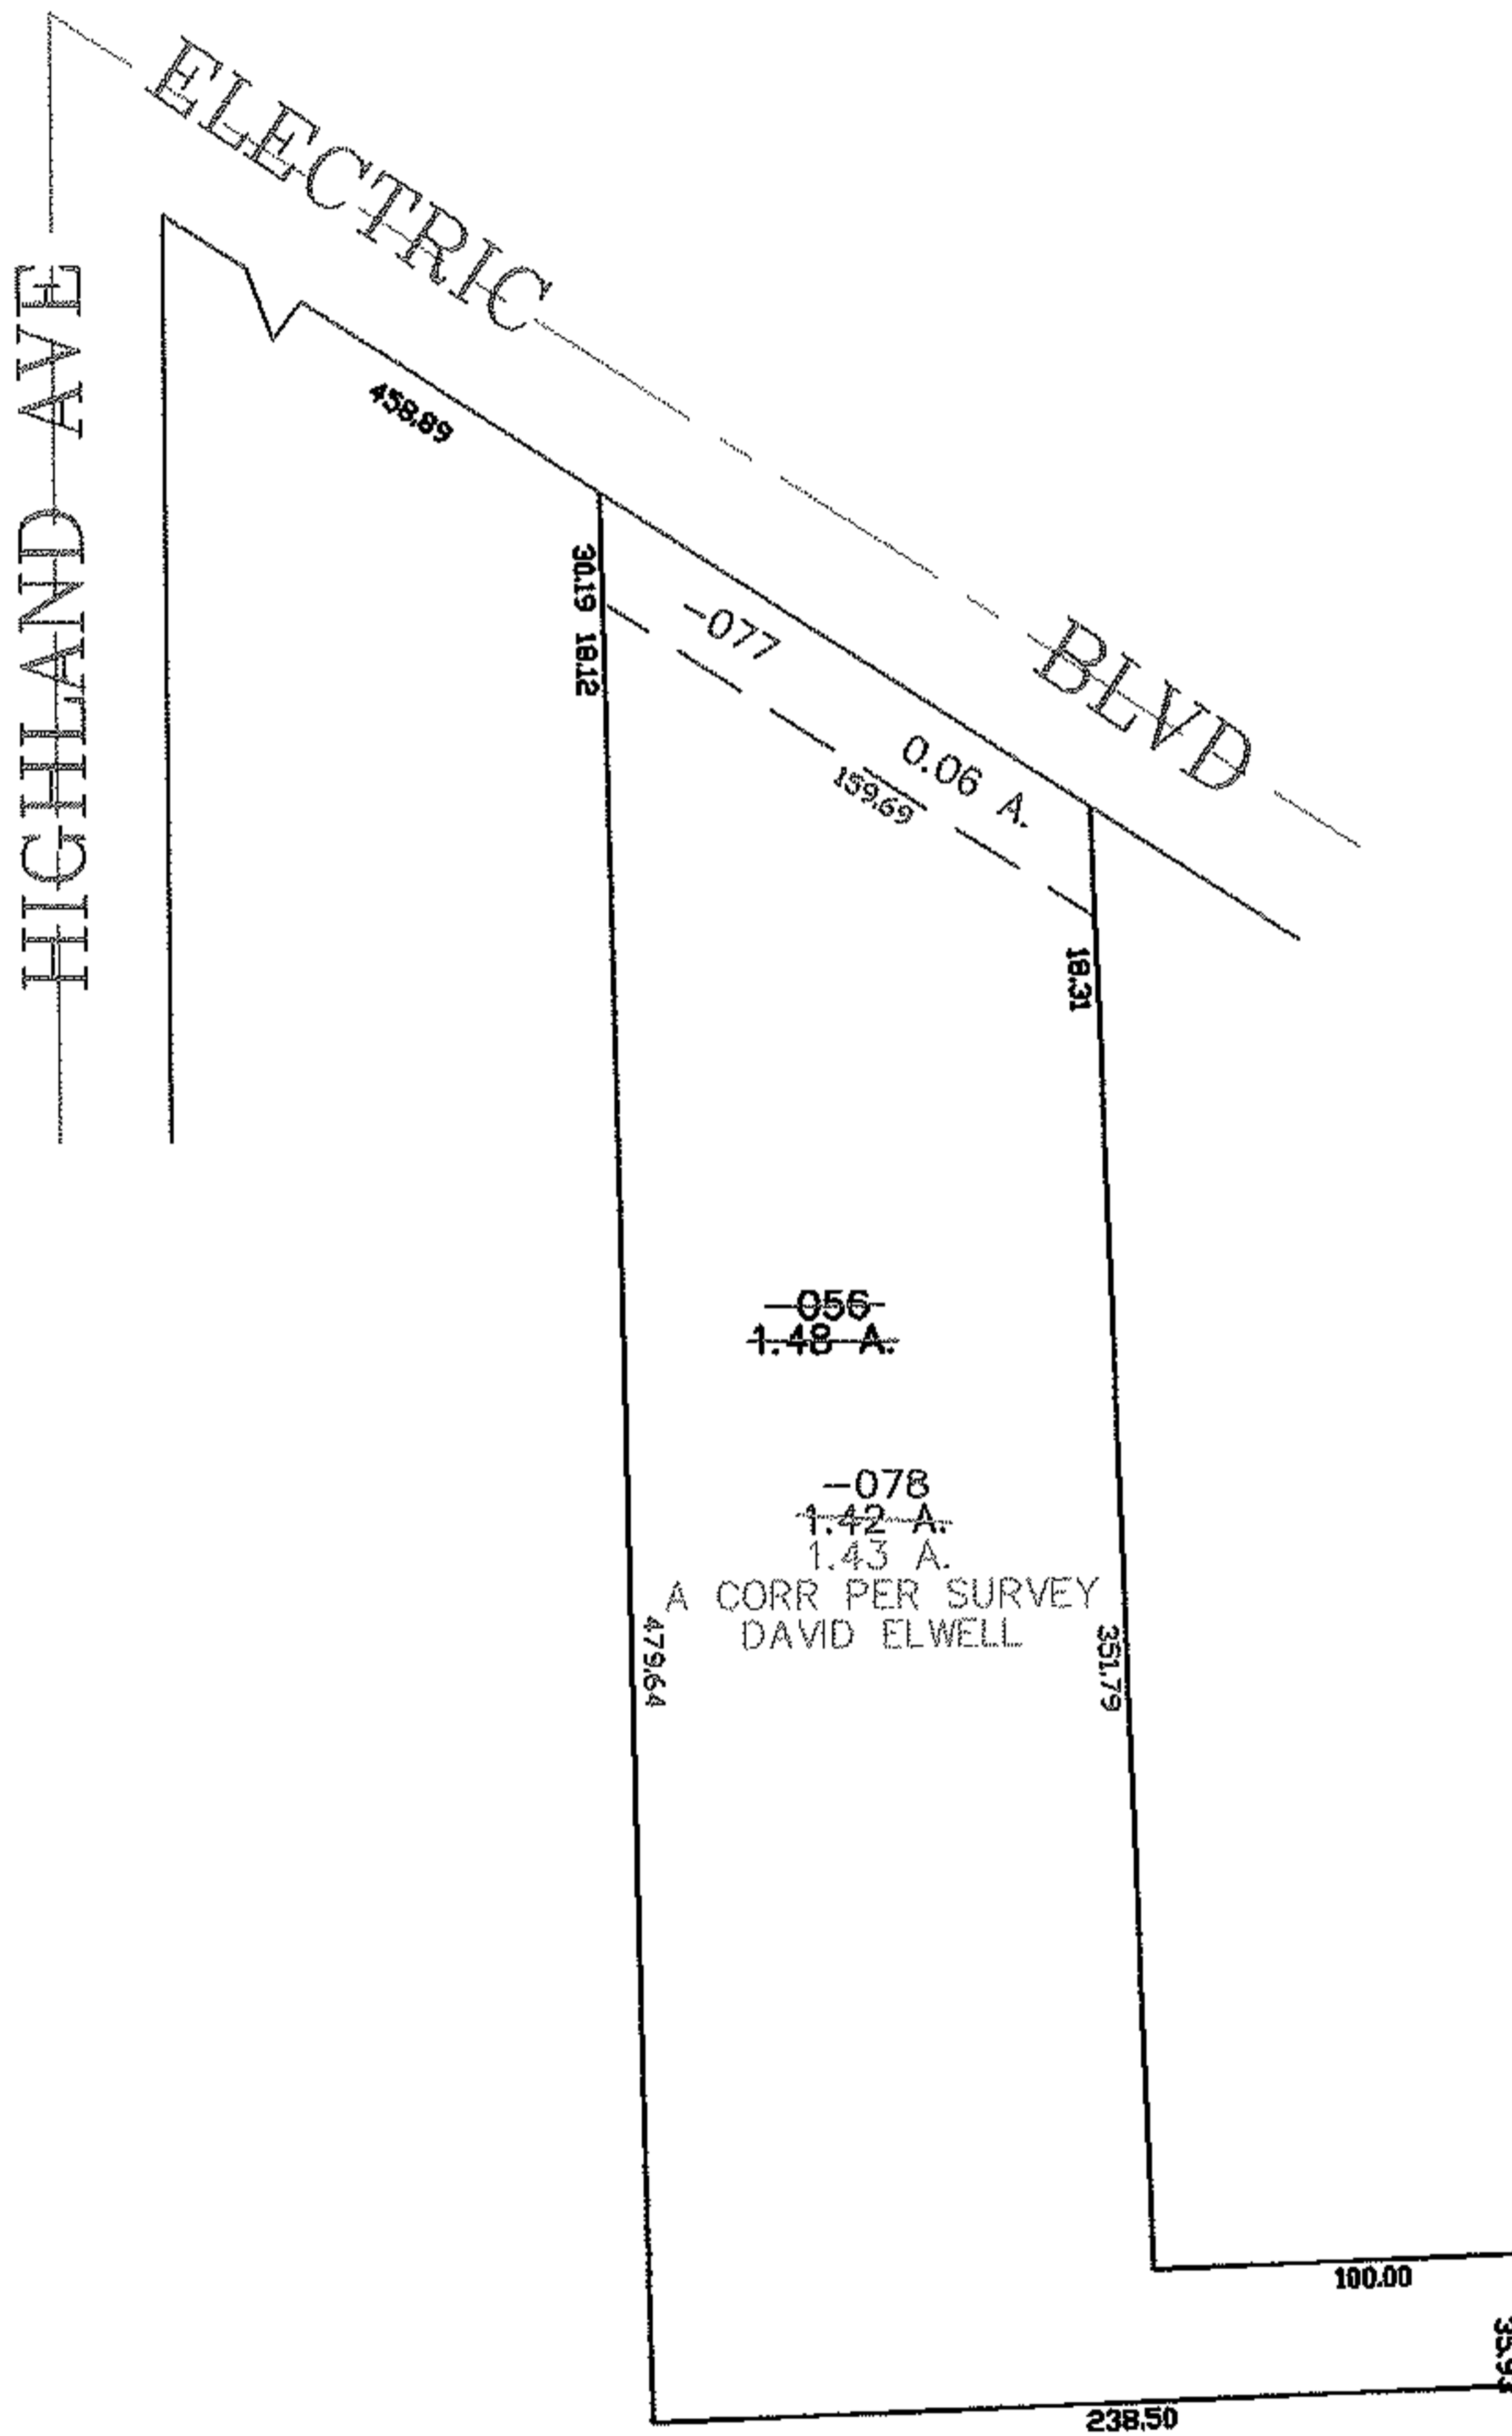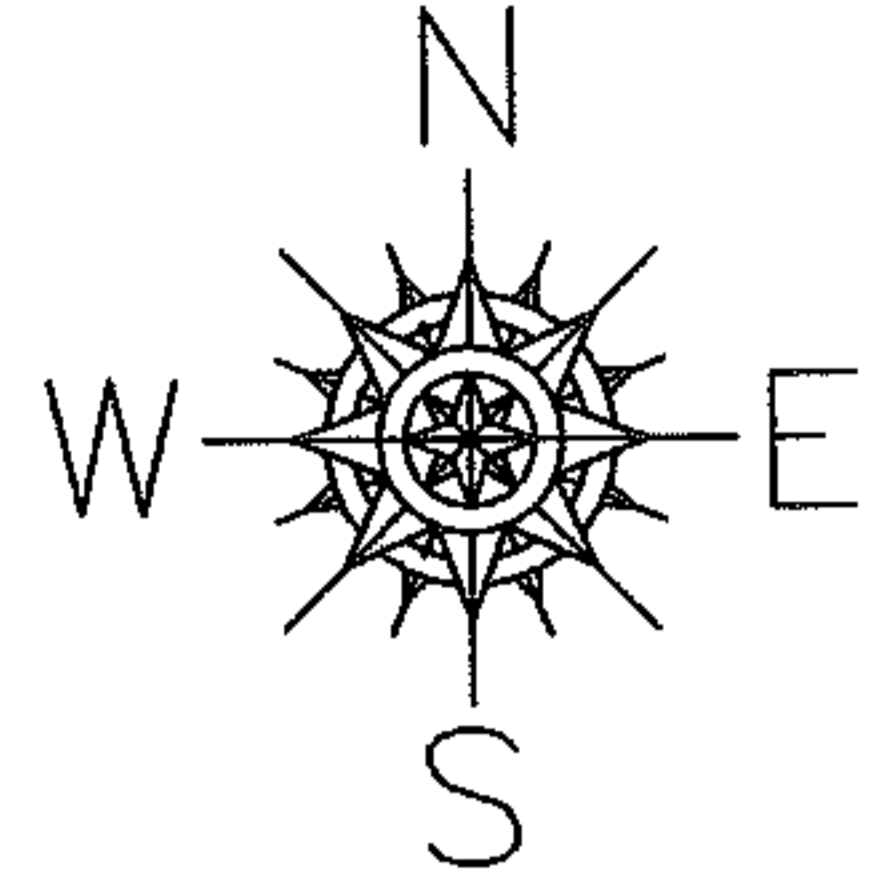

SPLITS/DEEDS PROCESSED

LORAIN COUNTY TAX MAP DEPARTMENT
226 MIDDLE AVE. ELYRIA, OHIO

SURVEYED BY: DAVID ELWELL
 CLOSURE: 0.00 : 10.000
 MAP PAGE(S): 04-00-030-D
 APPROVED BY: JAH DATE: 3-16-07
 SCALE: 1" = 100 PRIOR INSTRUMENT: 20020810816