




RASTER

PARENT PARCEL: 07-00-010-107-056

11-02343-A

CHILD PARCEL:

STARTING POINT: INTERSECTION OF C/L OF CHESTNUT RIDGE RD. AND MOST EASTERLY CORNER OF LAND CONVEYED TO RUTH BAINBRIDGE PEAK (DV 997/229)

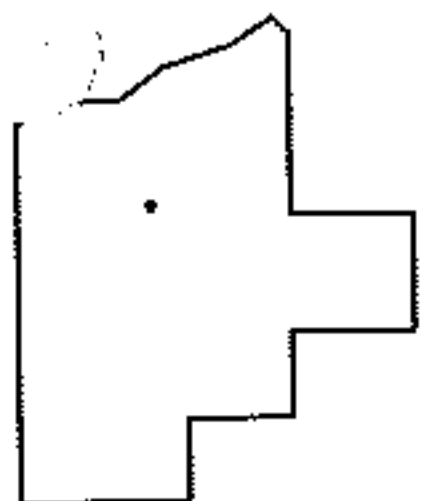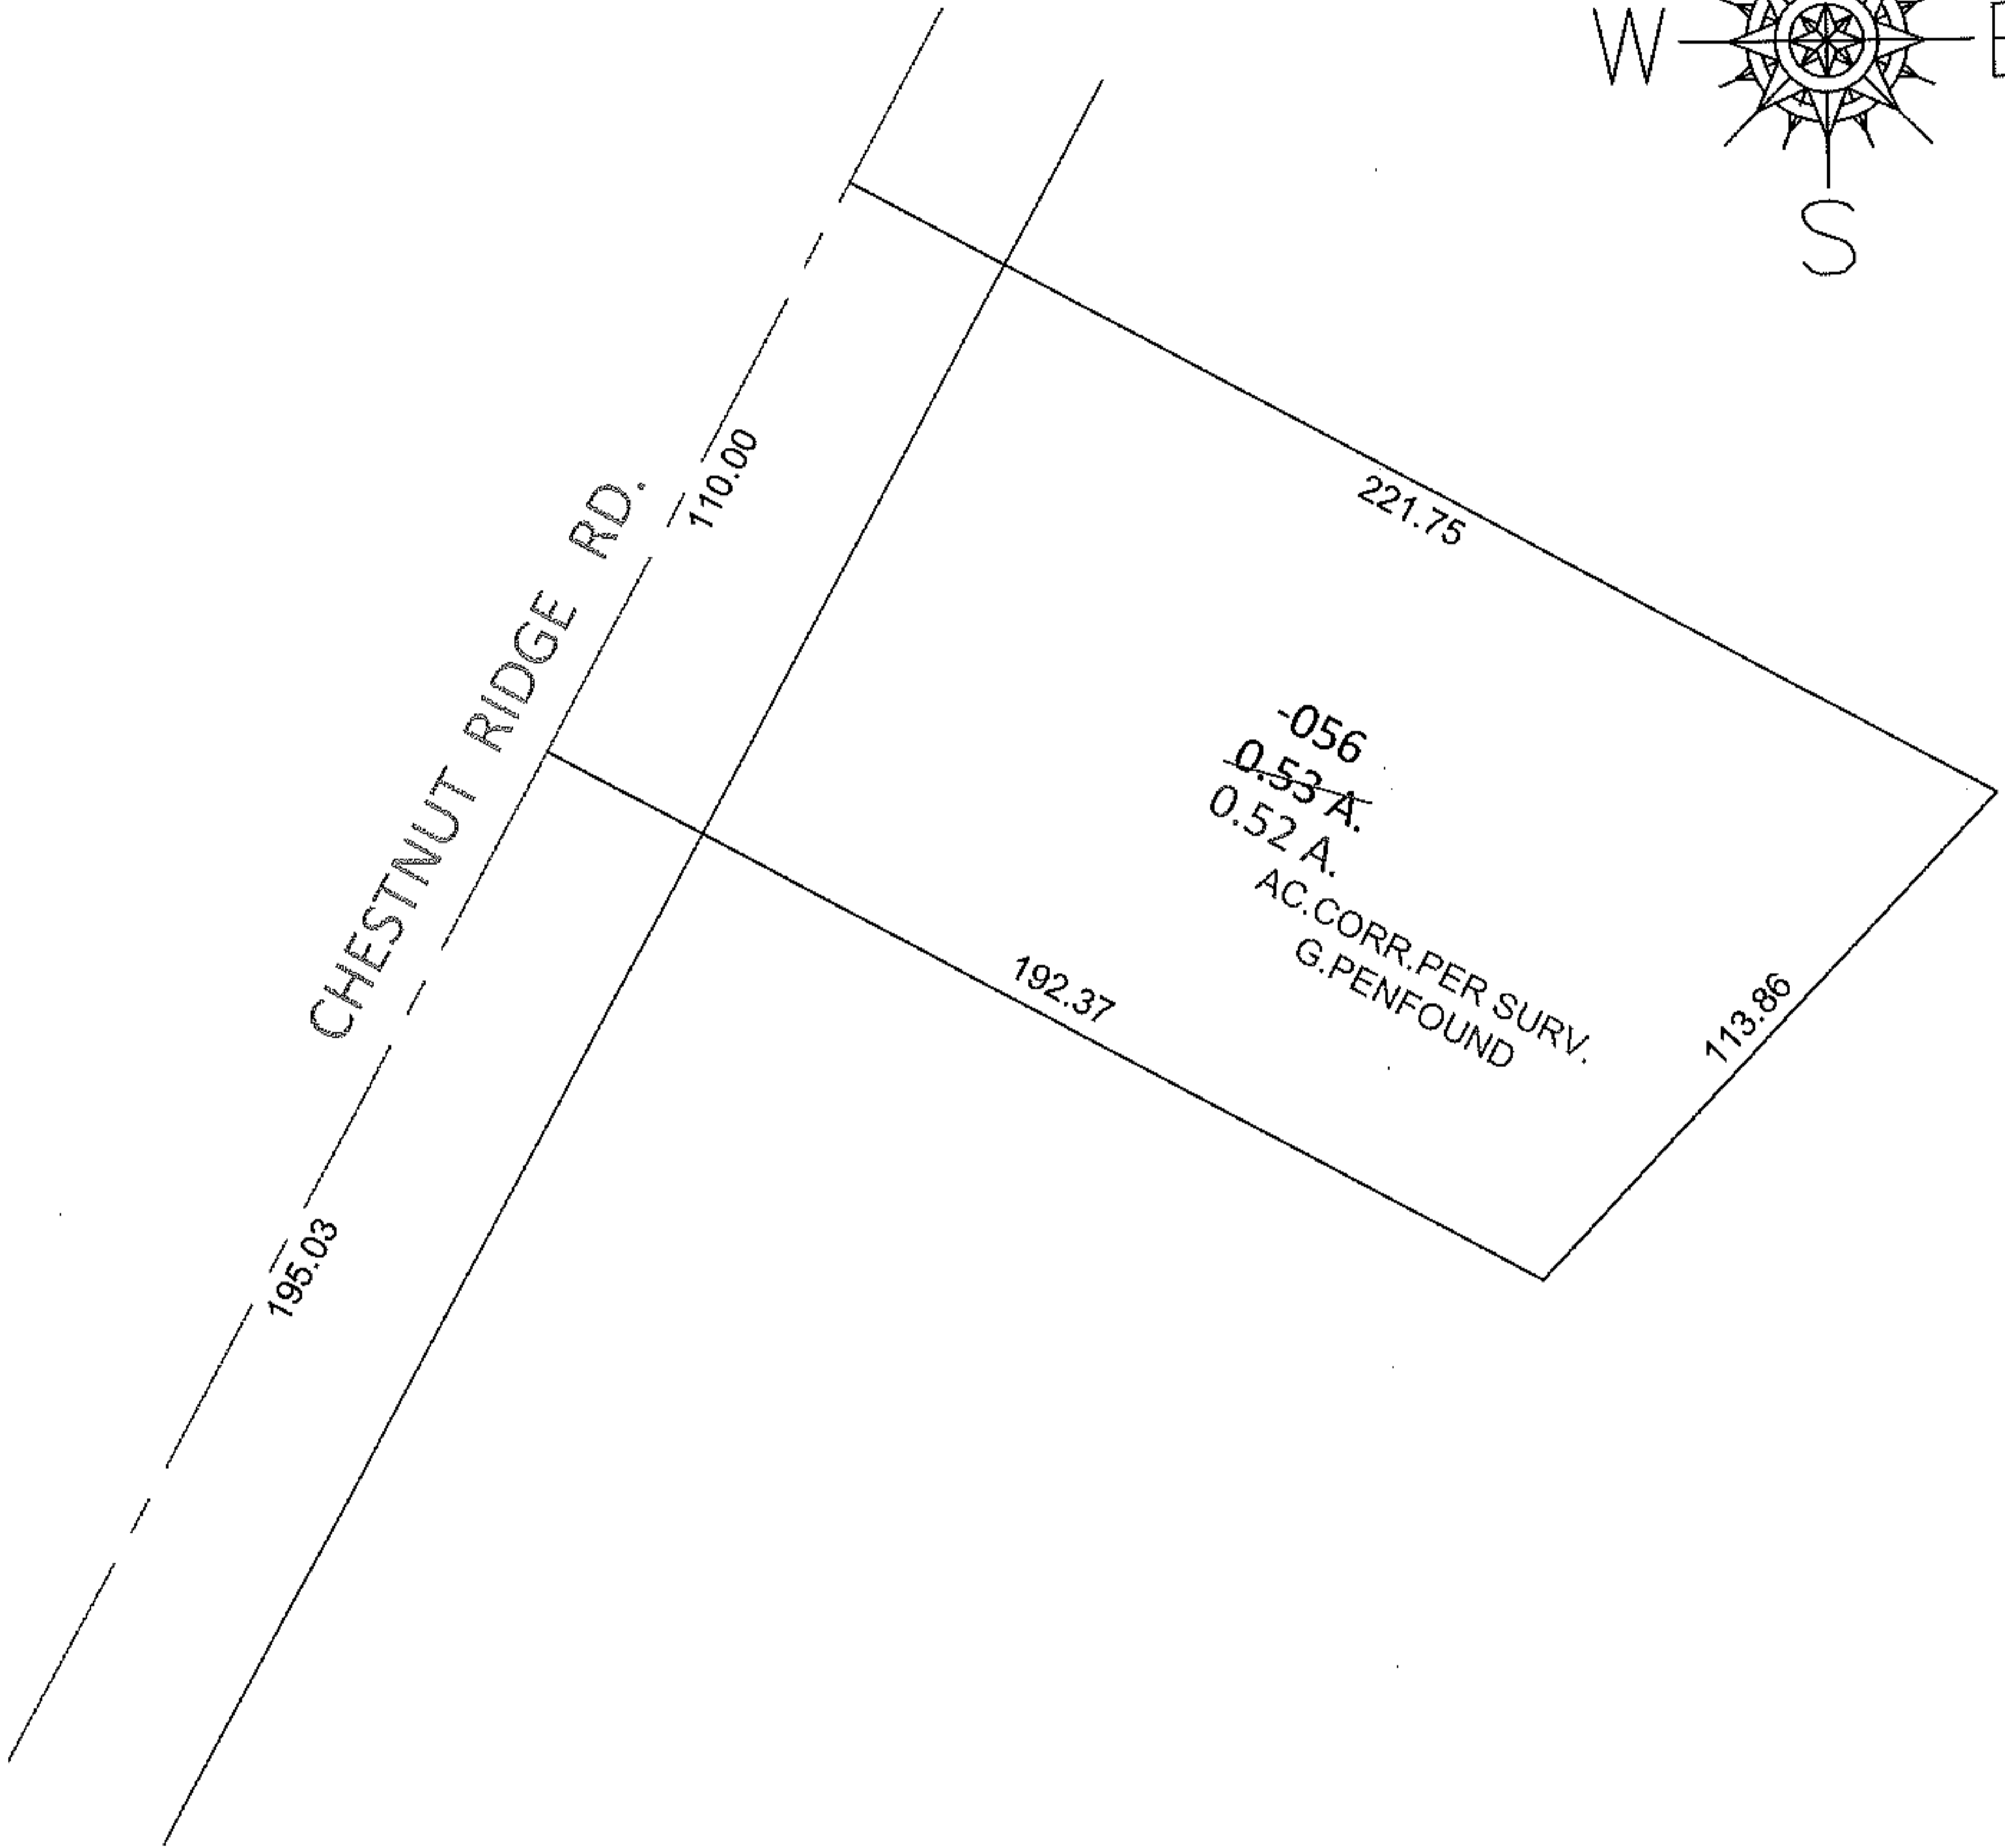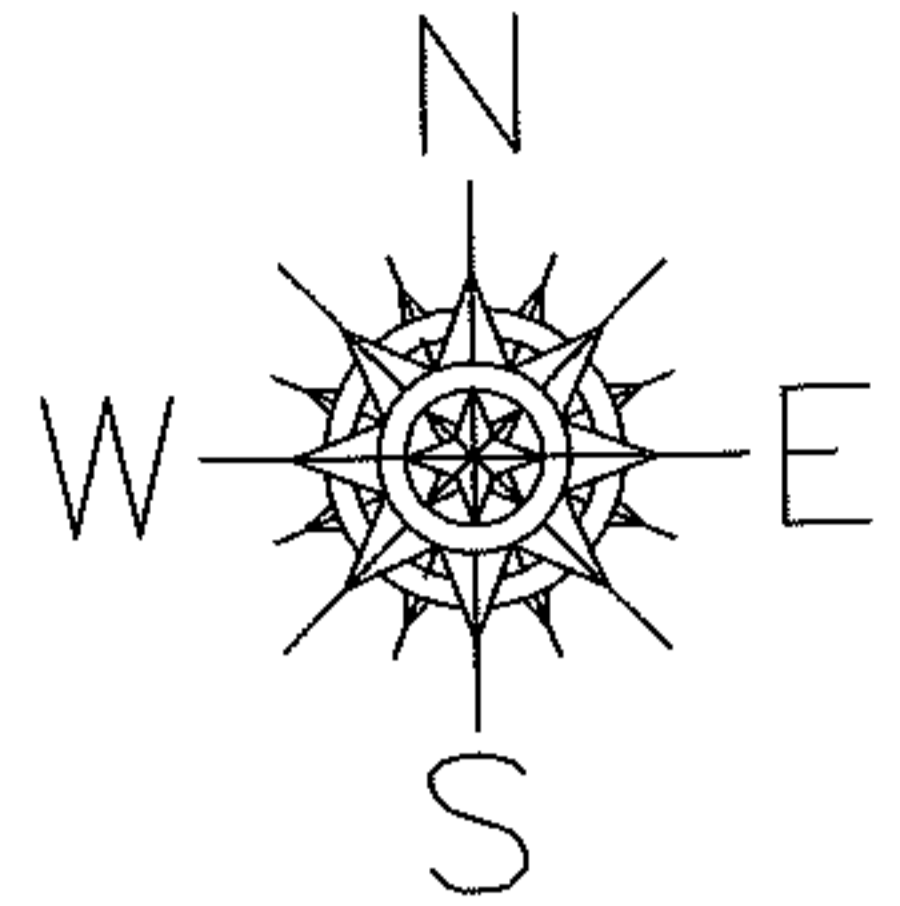

**SPLITS/DEEDS PROCESSED**

LORAIN COUNTY TAX MAP DEPARTMENT  
226 MIDDLE AVE. ELYRIA, OHIO

SURVEYED BY: GARY E. PENFOUND

CLOSURE: .01:10,000

MAP PAGE(S): 7-00-010-A

APPROVED BY: RRM DATE: 8-29-11

SCALE: 1"= 50' PRIOR INST.: DV 1310/443