
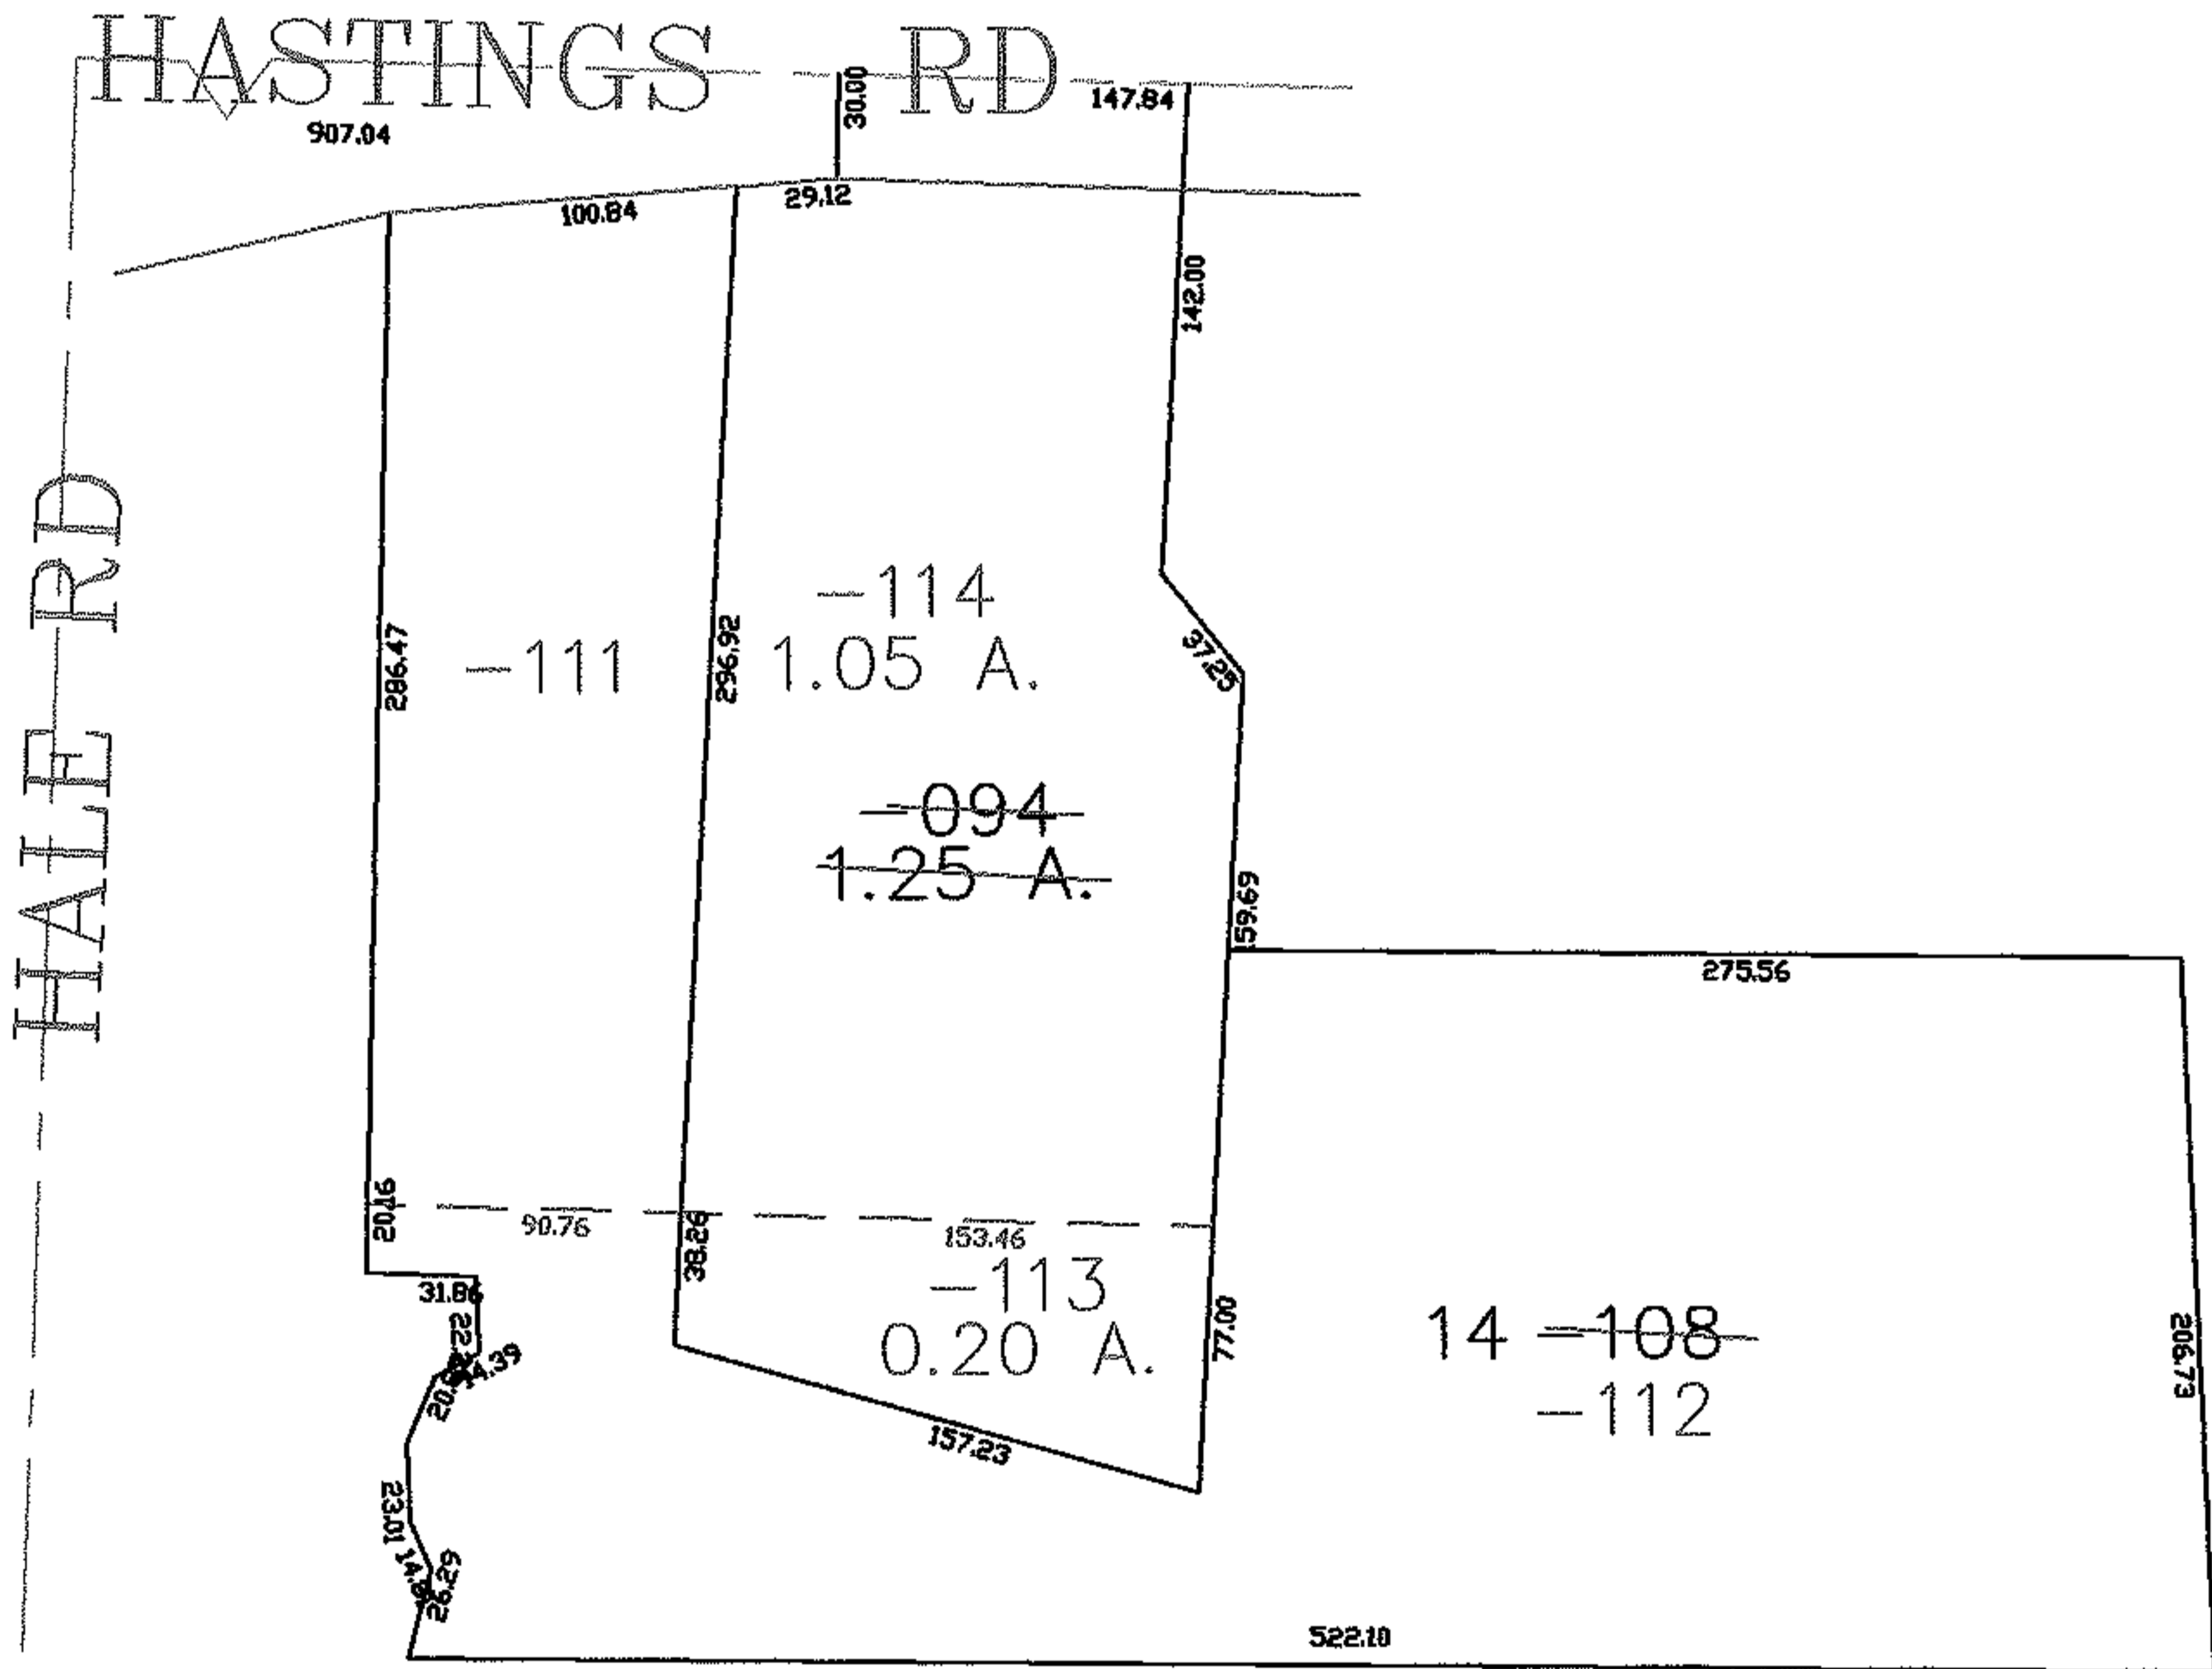


PARENT PARCEL: 10-00-020-103-108, -094

CHILD PARCEL: 10-00-020-103-111 THRU -114

STARTING POINT: CENTERLINE OF HASTINGS RD & HALE RD

07-02344

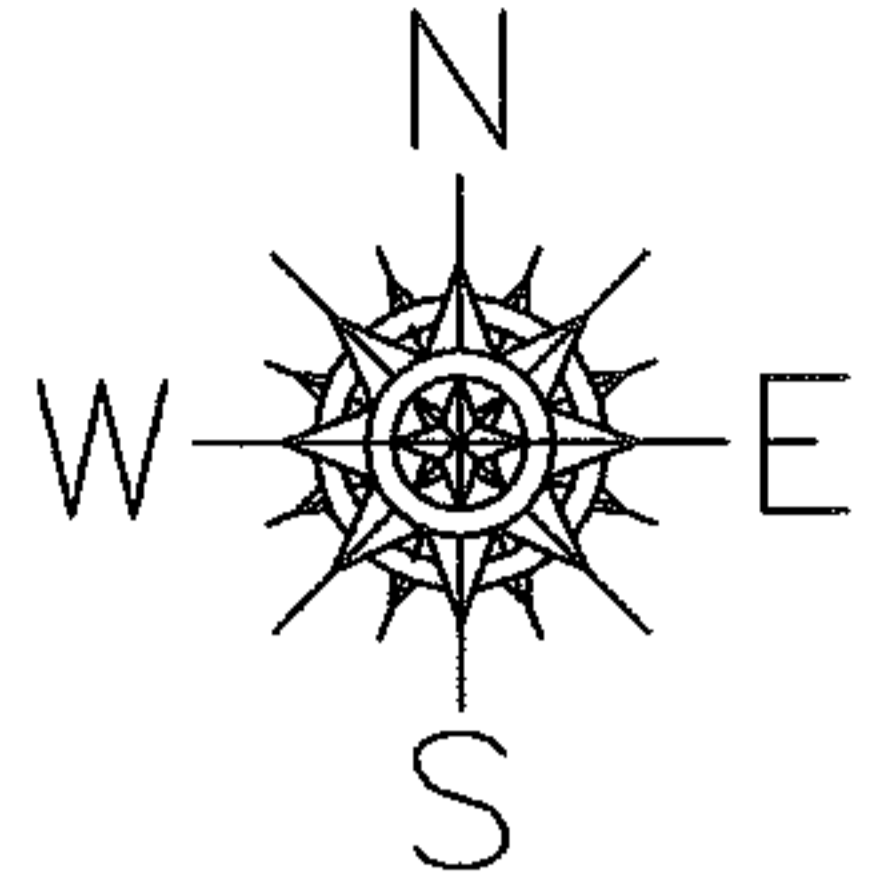

SPLITS/DEEDS PROCESSED

LORAIN COUNTY TAX MAP DEPARTMENT
226 MIDDLE AVE. ELYRIA, OHIO

SURVEYED BY: PHILLIP ROSEBECK

CLOSURE: 0.00 ; 10.000

MAP PAGE(S): 10-00-020-E

APPROVED BY: JAH DATE: 3-19-07

SCALE: 1" = 100 PRIOR INSTRUMENT: PL VOL 82/71