
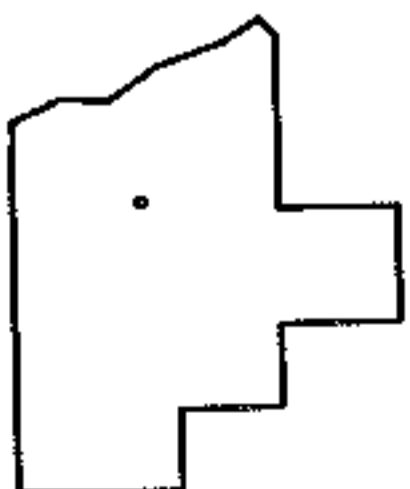
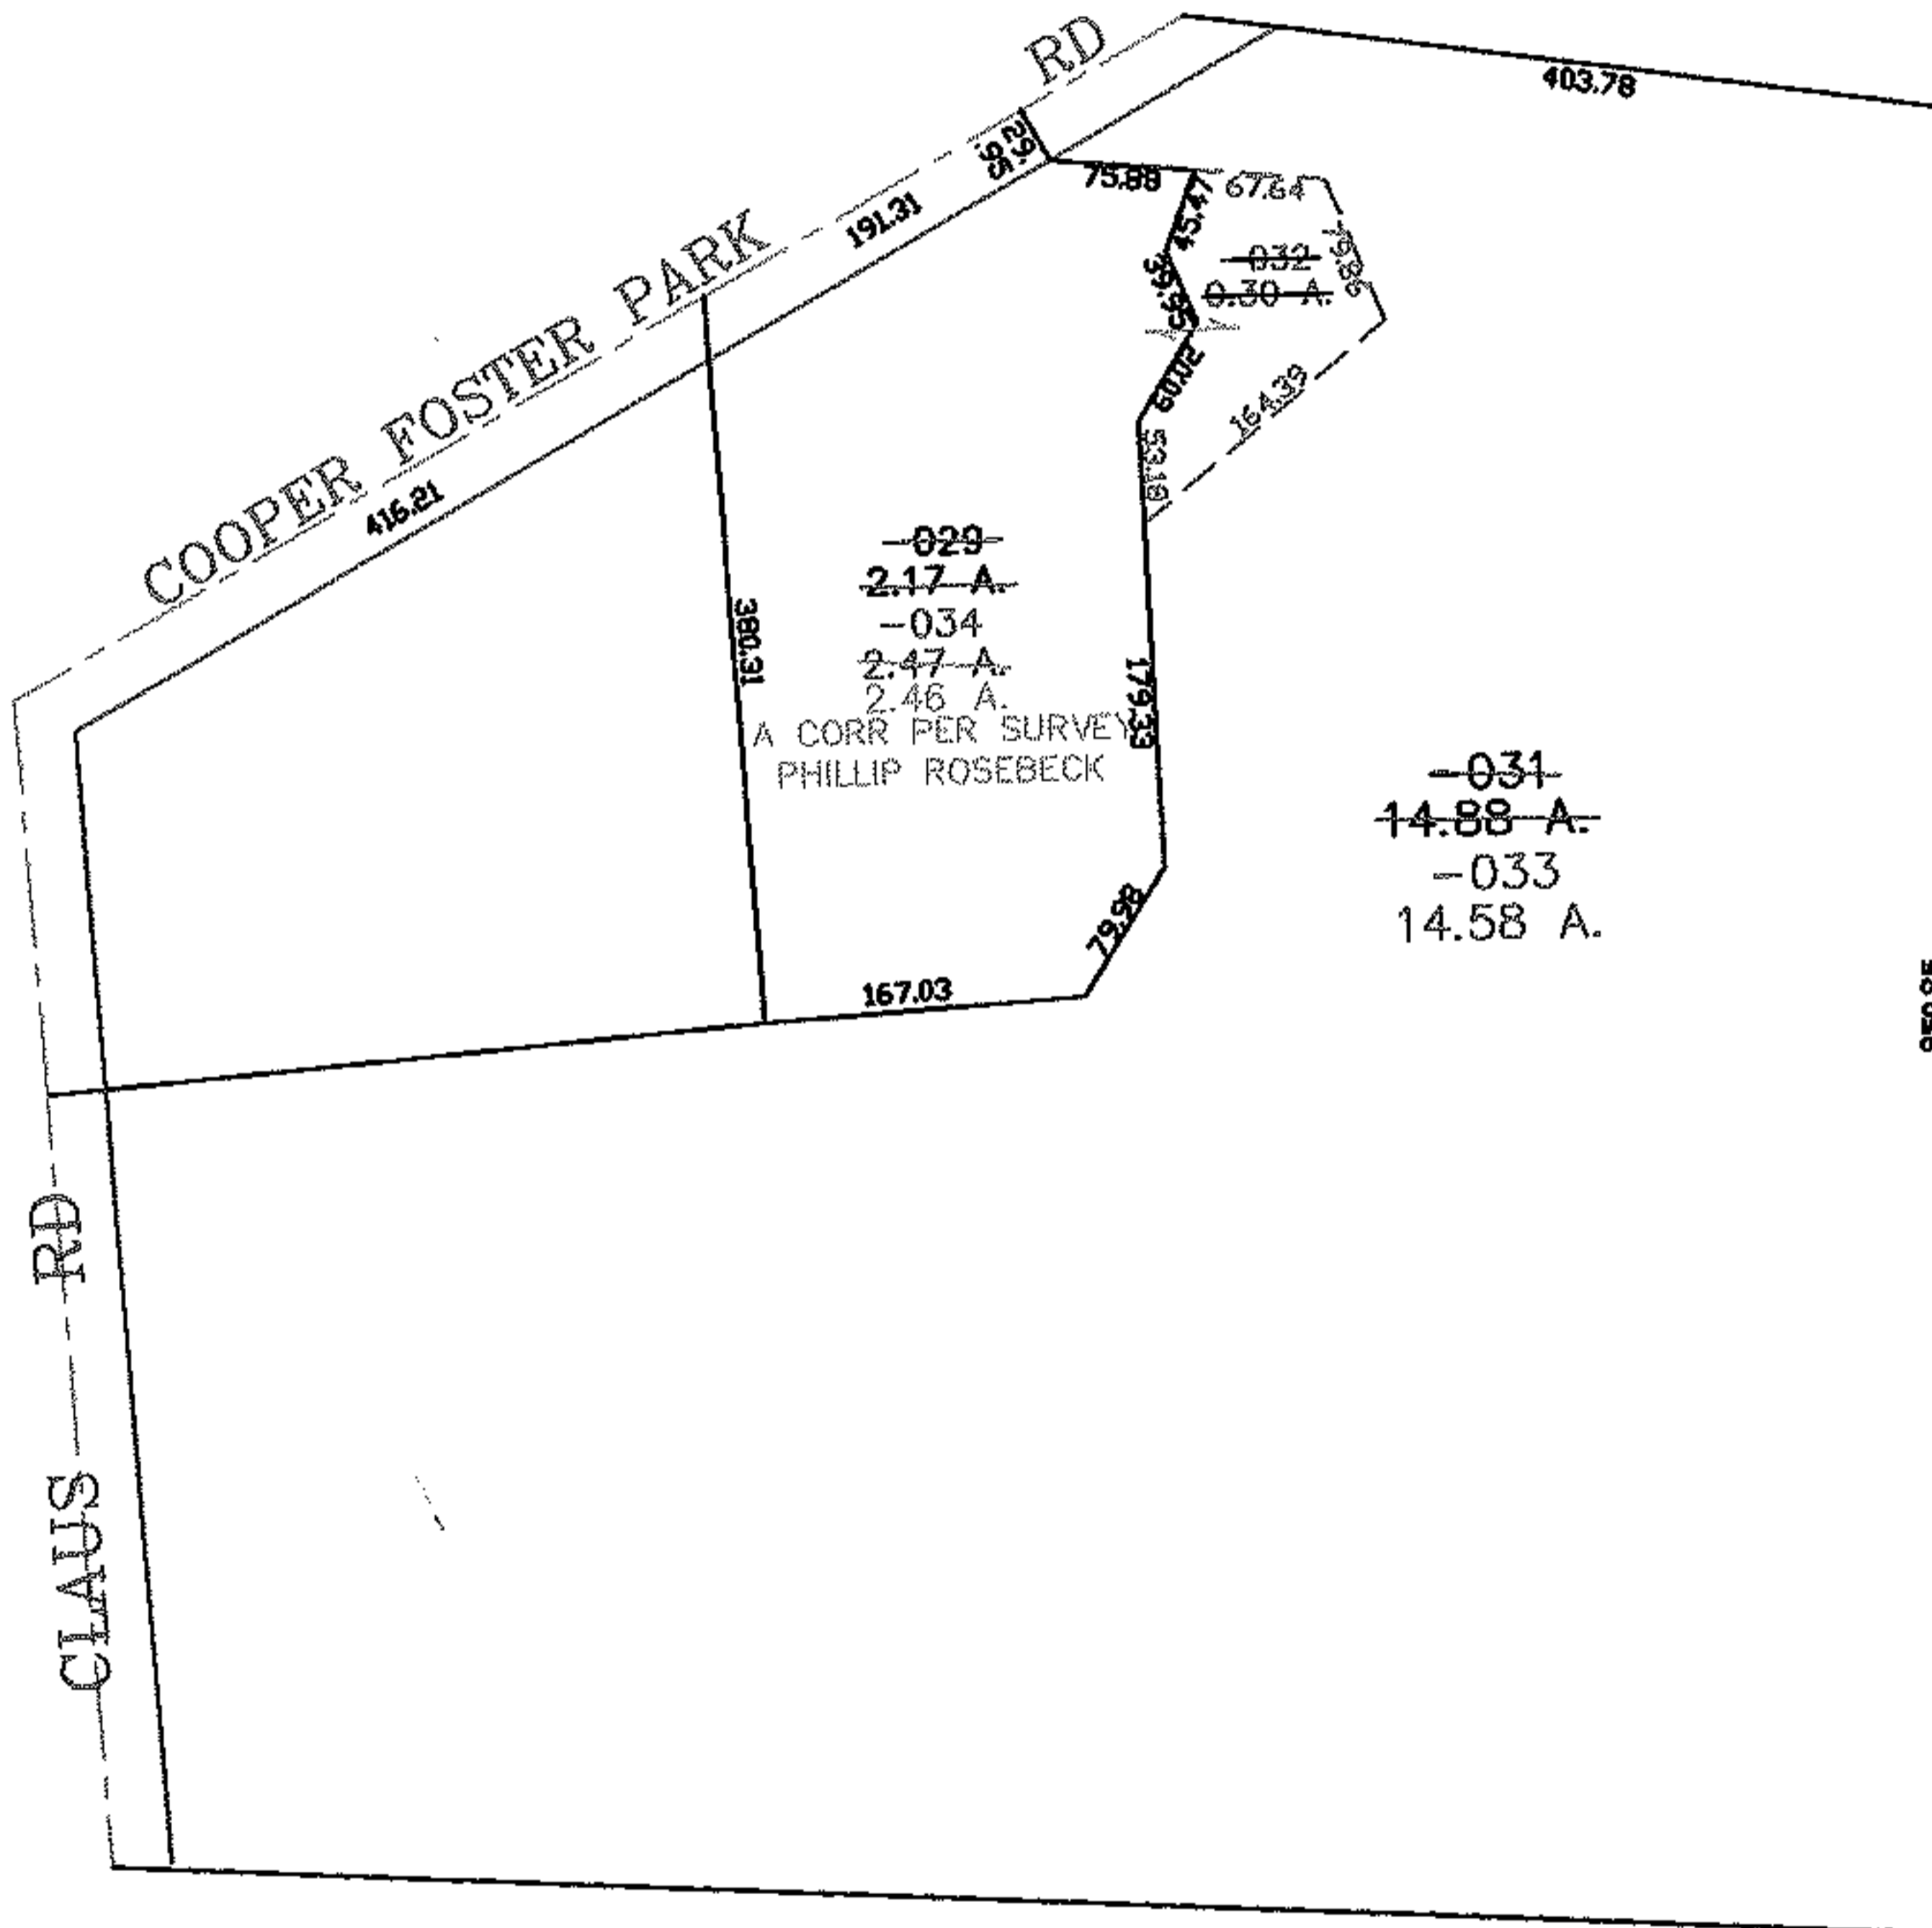


PARENT PARCEL: 01-00-037-103-029, -031

CHILD PARCEL: 01-00-037-103-032 THRU -034

STARTING POINT: CENTERLINE OF CLAUS RD & COOPER FOSTER PARK RD

07-02345

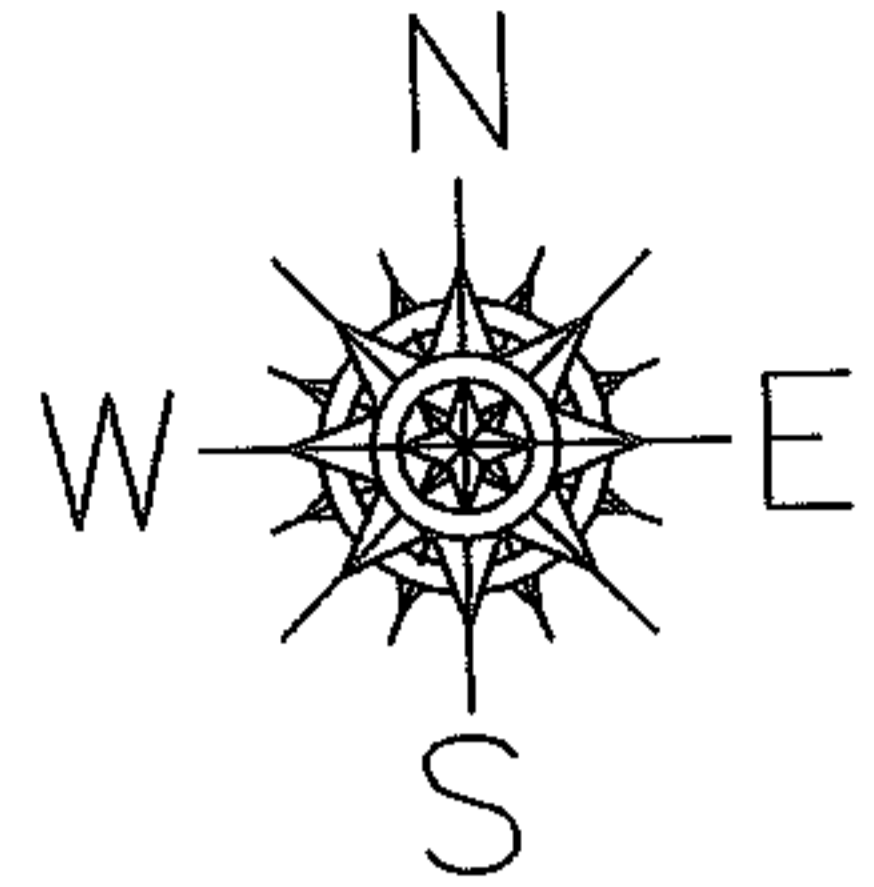

SPLITS/DEEDS PROCESSED

LORAIN COUNTY TAX MAP DEPARTMENT
226 MIDDLE AVE. ELYRIA, OHIO

SURVEYED BY: PHILLIP ROSEBECK

CLOSURE: 0.00 : 10.000

MAP PAGE(S): 01-00-037-B

APPROVED BY: JAH DATE: 3-27-07

SCALE: 1" = 200 PRIOR INSTRUMENT: 19980560486