
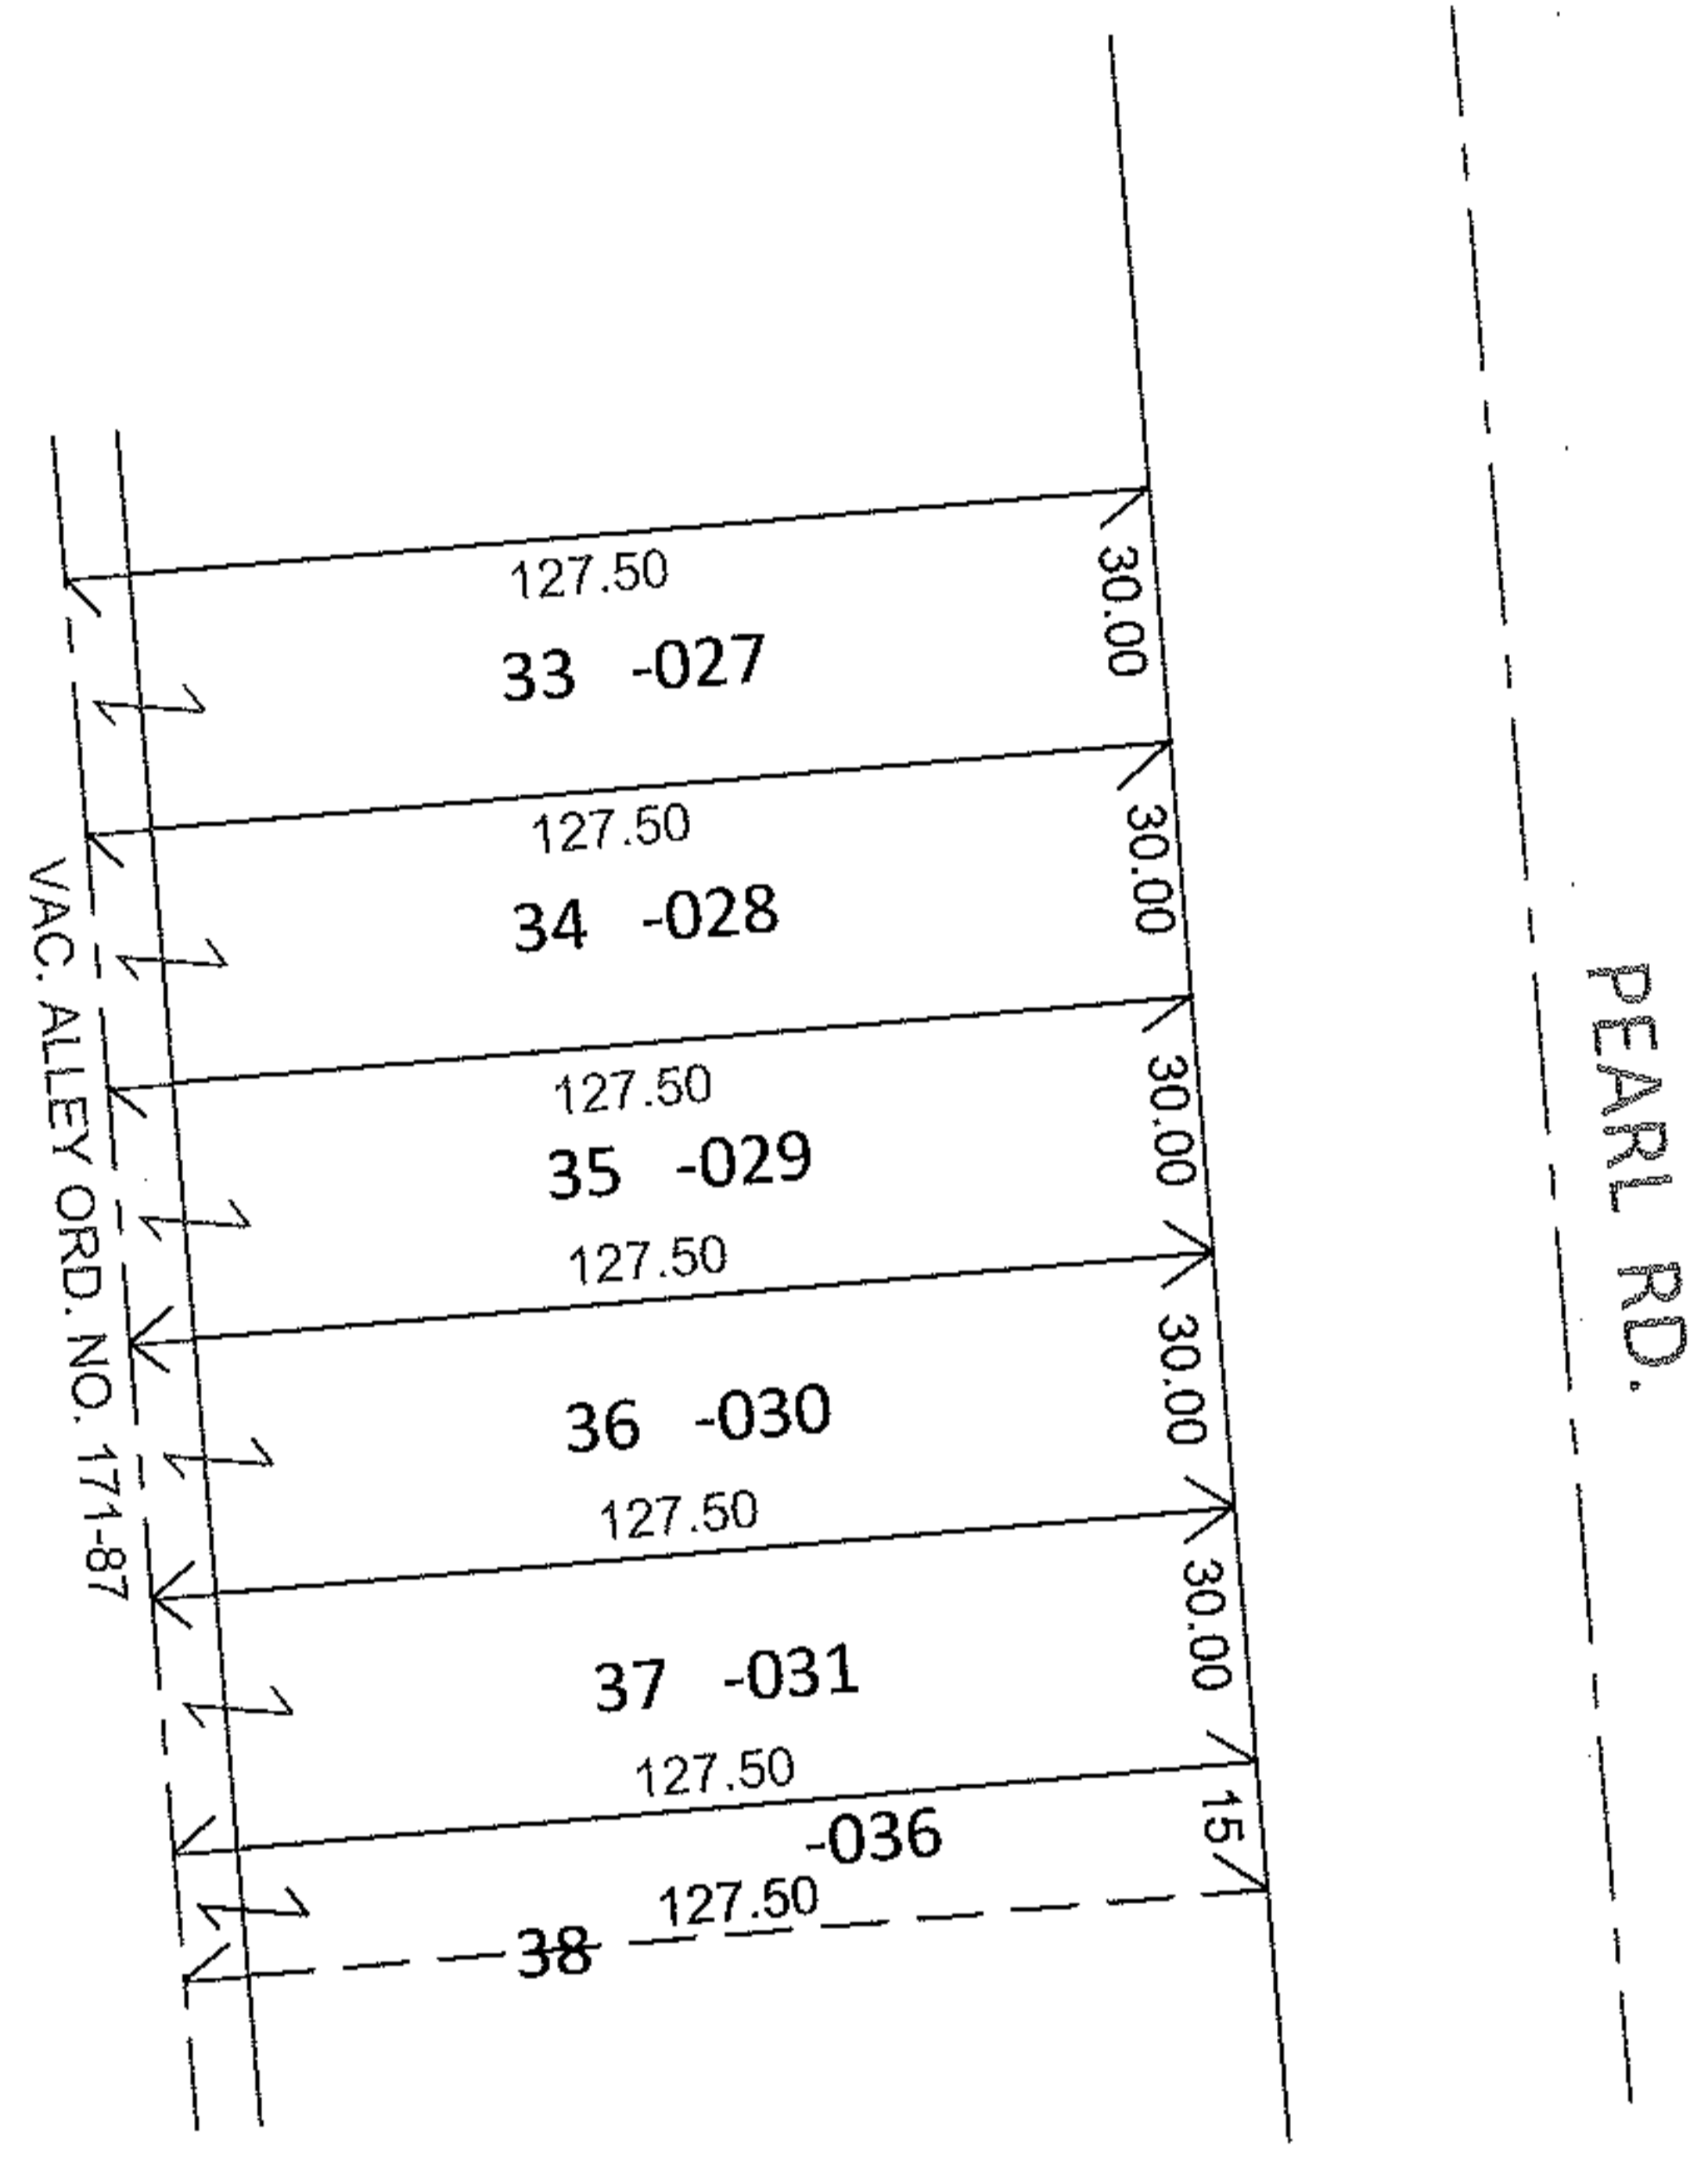


RASTER


PARENT PARCEL: 03-00-106-109-027, -028, -029, -030, -031, -036  
CHILD PARCEL:  
STARTING POINT: S/L'S 33-37 & 1/2 OF 38 IN BLOCK 16 OF CENTRAL DIVISION (VOL.9 PG.5)

11-02346-C

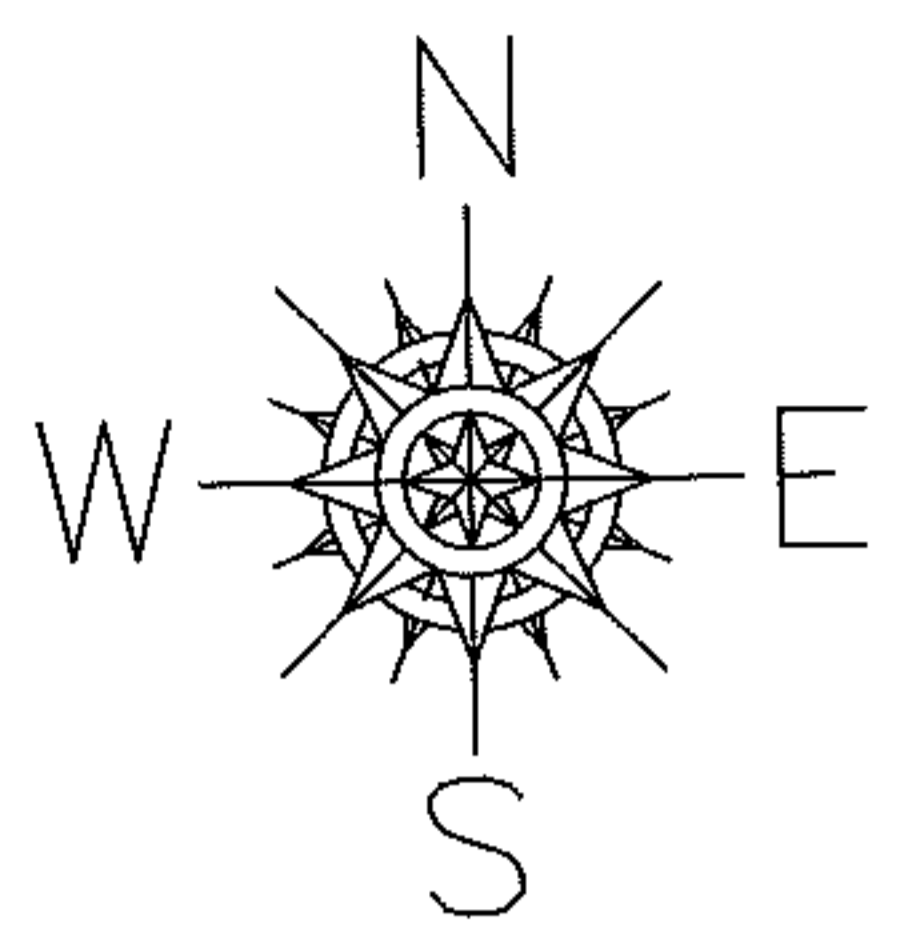

DEPTH CORRECTION

03-00-106-109-027	03-00-106-109-028	03-00-106-109-029
127.50	127.50	127.50
30 X 120	30 X 120	30 X 120
03-00-106-109-030	03-00-106-109-031	
127.50	127.50	
30 X 120	30 X 120	
CORR. PER PRIOR DEEDS & VAC. ORD. 171-87		

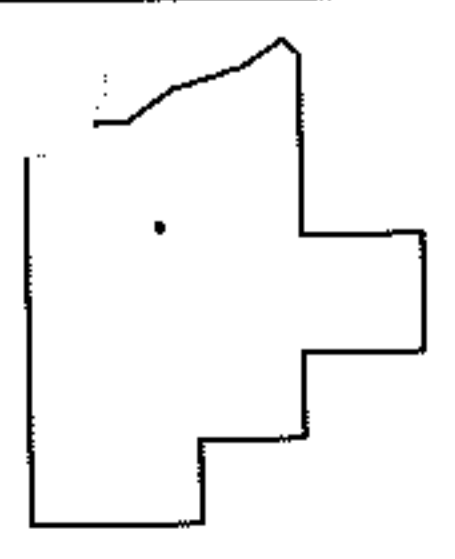

SPLITS/DEEDS PROCESSED  
LORAIN COUNTY TAX MAP DEPARTMENT  
226 MIDDLE AVE. ELYRIA, OHIO

SURVEYED BY: N/A  
CLOSURE: N/A  
MAP PAGE(S): 3-00-106-B  
APPROVED BY: RRM DATE: 8-30-11  
SCALE: 1"= 50' PRIOR INST.: 20080276748