


RASOER

PARENT PARCEL: 01-00-048-000-005

CHILD PARCEL: \_\_\_\_\_

STARTING POINT: \_\_\_\_\_

11-02348-A

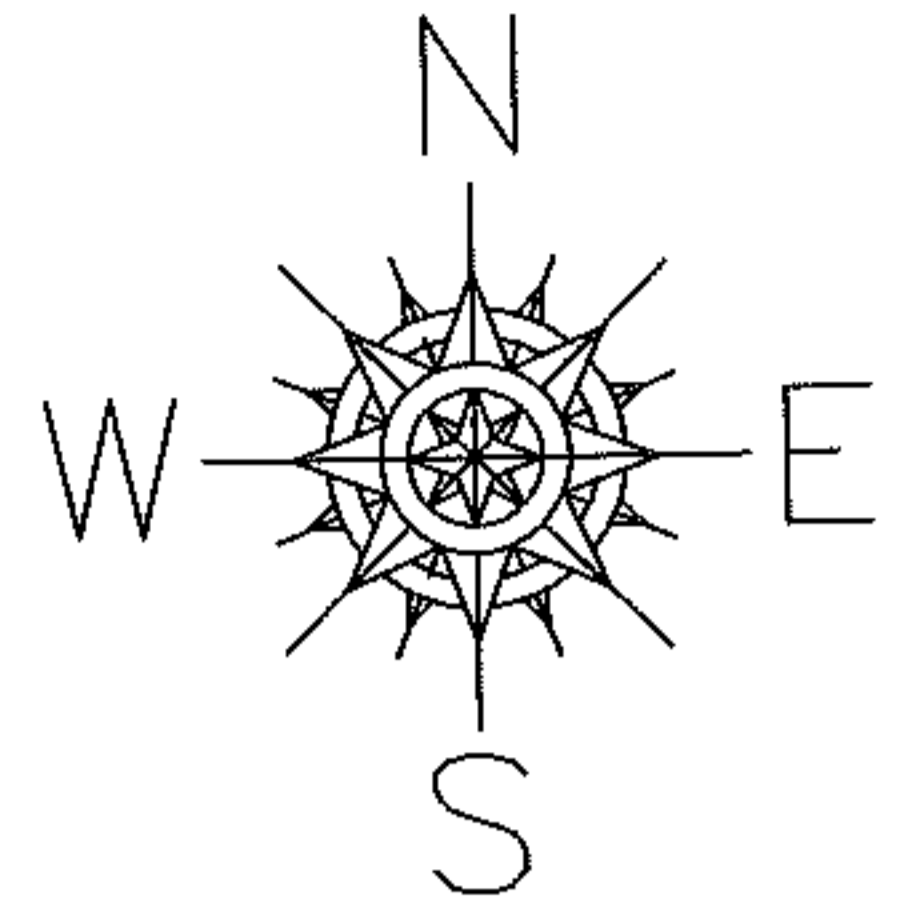


ACREAGE CORRECTION IN REGISTER AND DEVNET ONLY

01-00-048-000-005

48.78 A.

~~48.77 A.~~

AC. CORR. PER PRIOR DEEDS

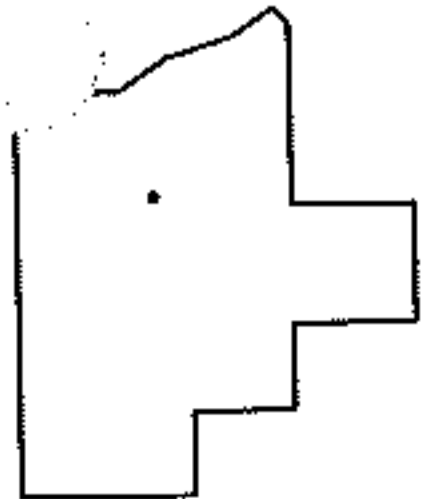

SPLITS/DEEDS PROCESSED

LORAIN COUNTY TAX MAP DEPARTMENT  
226 MIDDLE AVE. ELYRIA, OHIO

SURVEYED BY: N/A

CLOSURE: N/A

MAP PAGE(S): 1-E

APPROVED BY: RRM DATE: 9-6-11

SCALE: 1" = 50' PRIOR INST.: 19980513981