
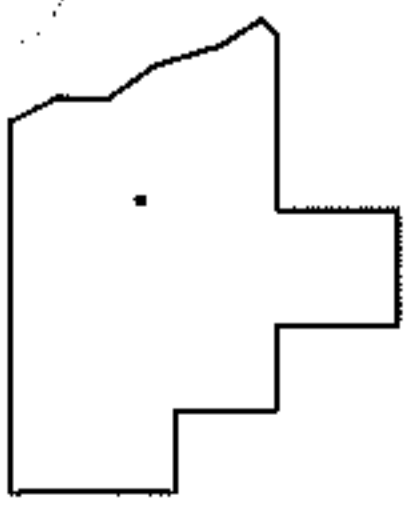
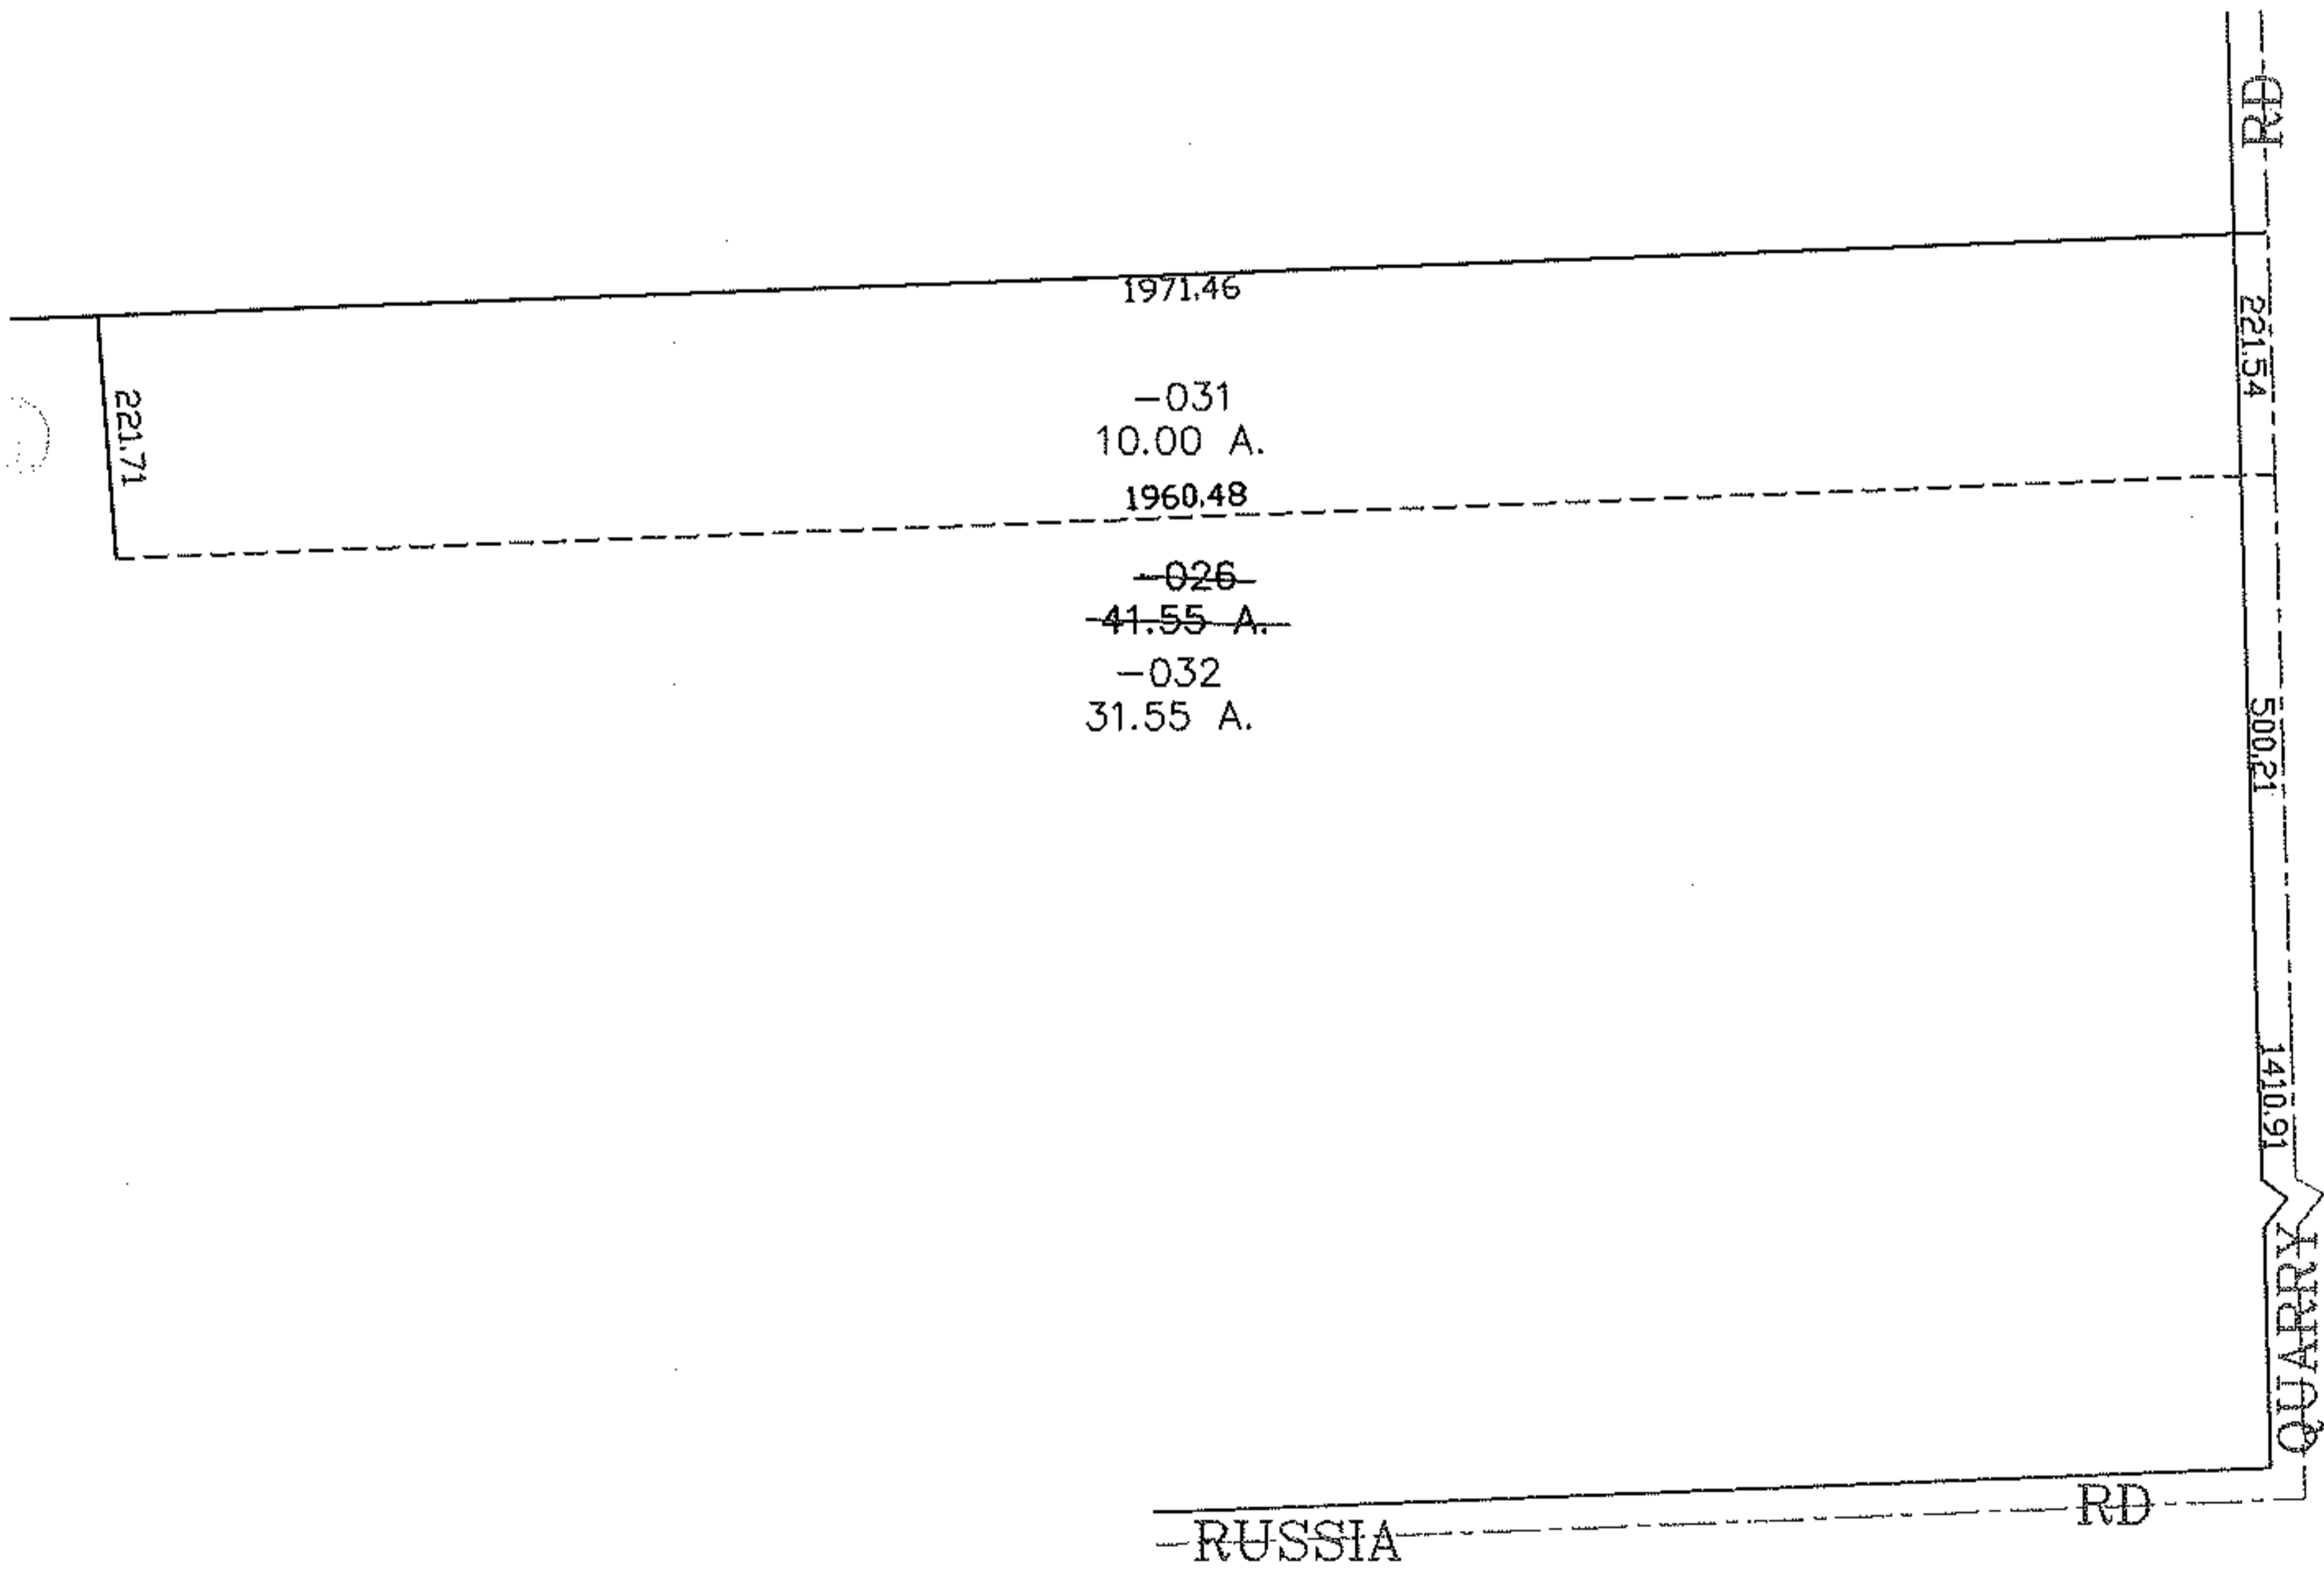


PARENT PARCEL: 09-00-011-000-026

CHILD PARCEL: 09-00-011-000-031, -032

STARTING POINT: CENTERLINE OF RUSSIA RD & QUARRY RD

07-02349

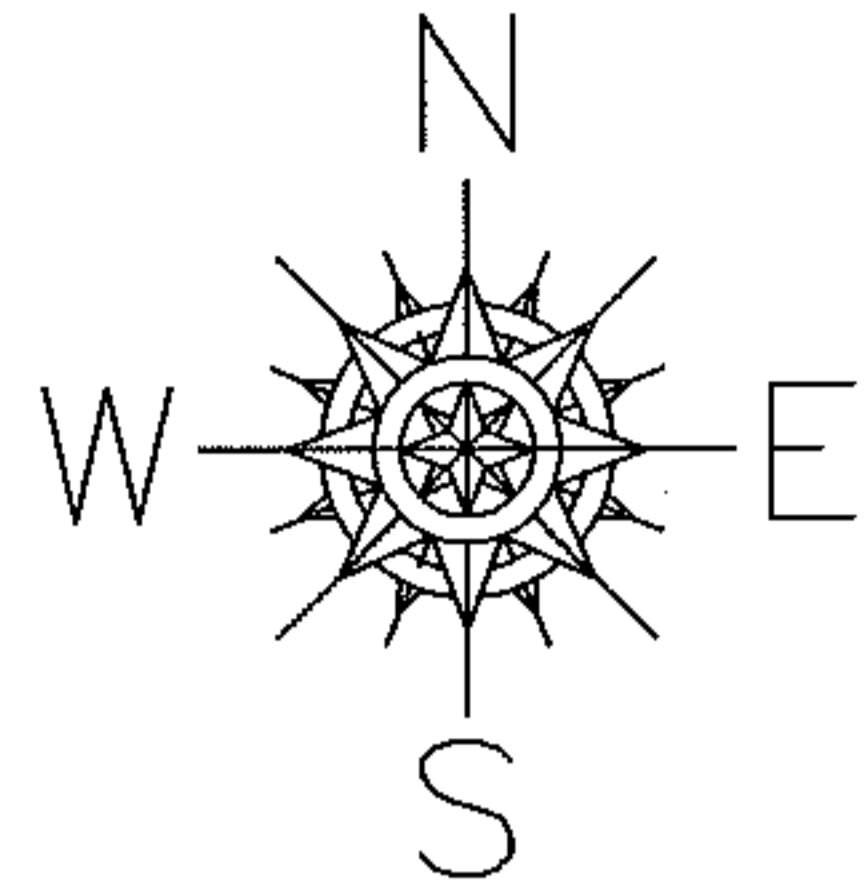

**SPLITS/DEEDS PROCESSED**  
 LORAIN COUNTY TAX MAP DEPARTMENT  
 226 MIDDLE AVE. ELYRIA, OHIO

SURVEYED BY: THOMAS SNEZEK  
 CLOSURE: 0.00 : 10.000  
 MAP PAGE(S): 09-00-011-B  
 APPROVED BY: JAH DATE: 4-2-07  
 SCALE: 1" = 300' PRIOR INSTRUMENT: OR 126/797