
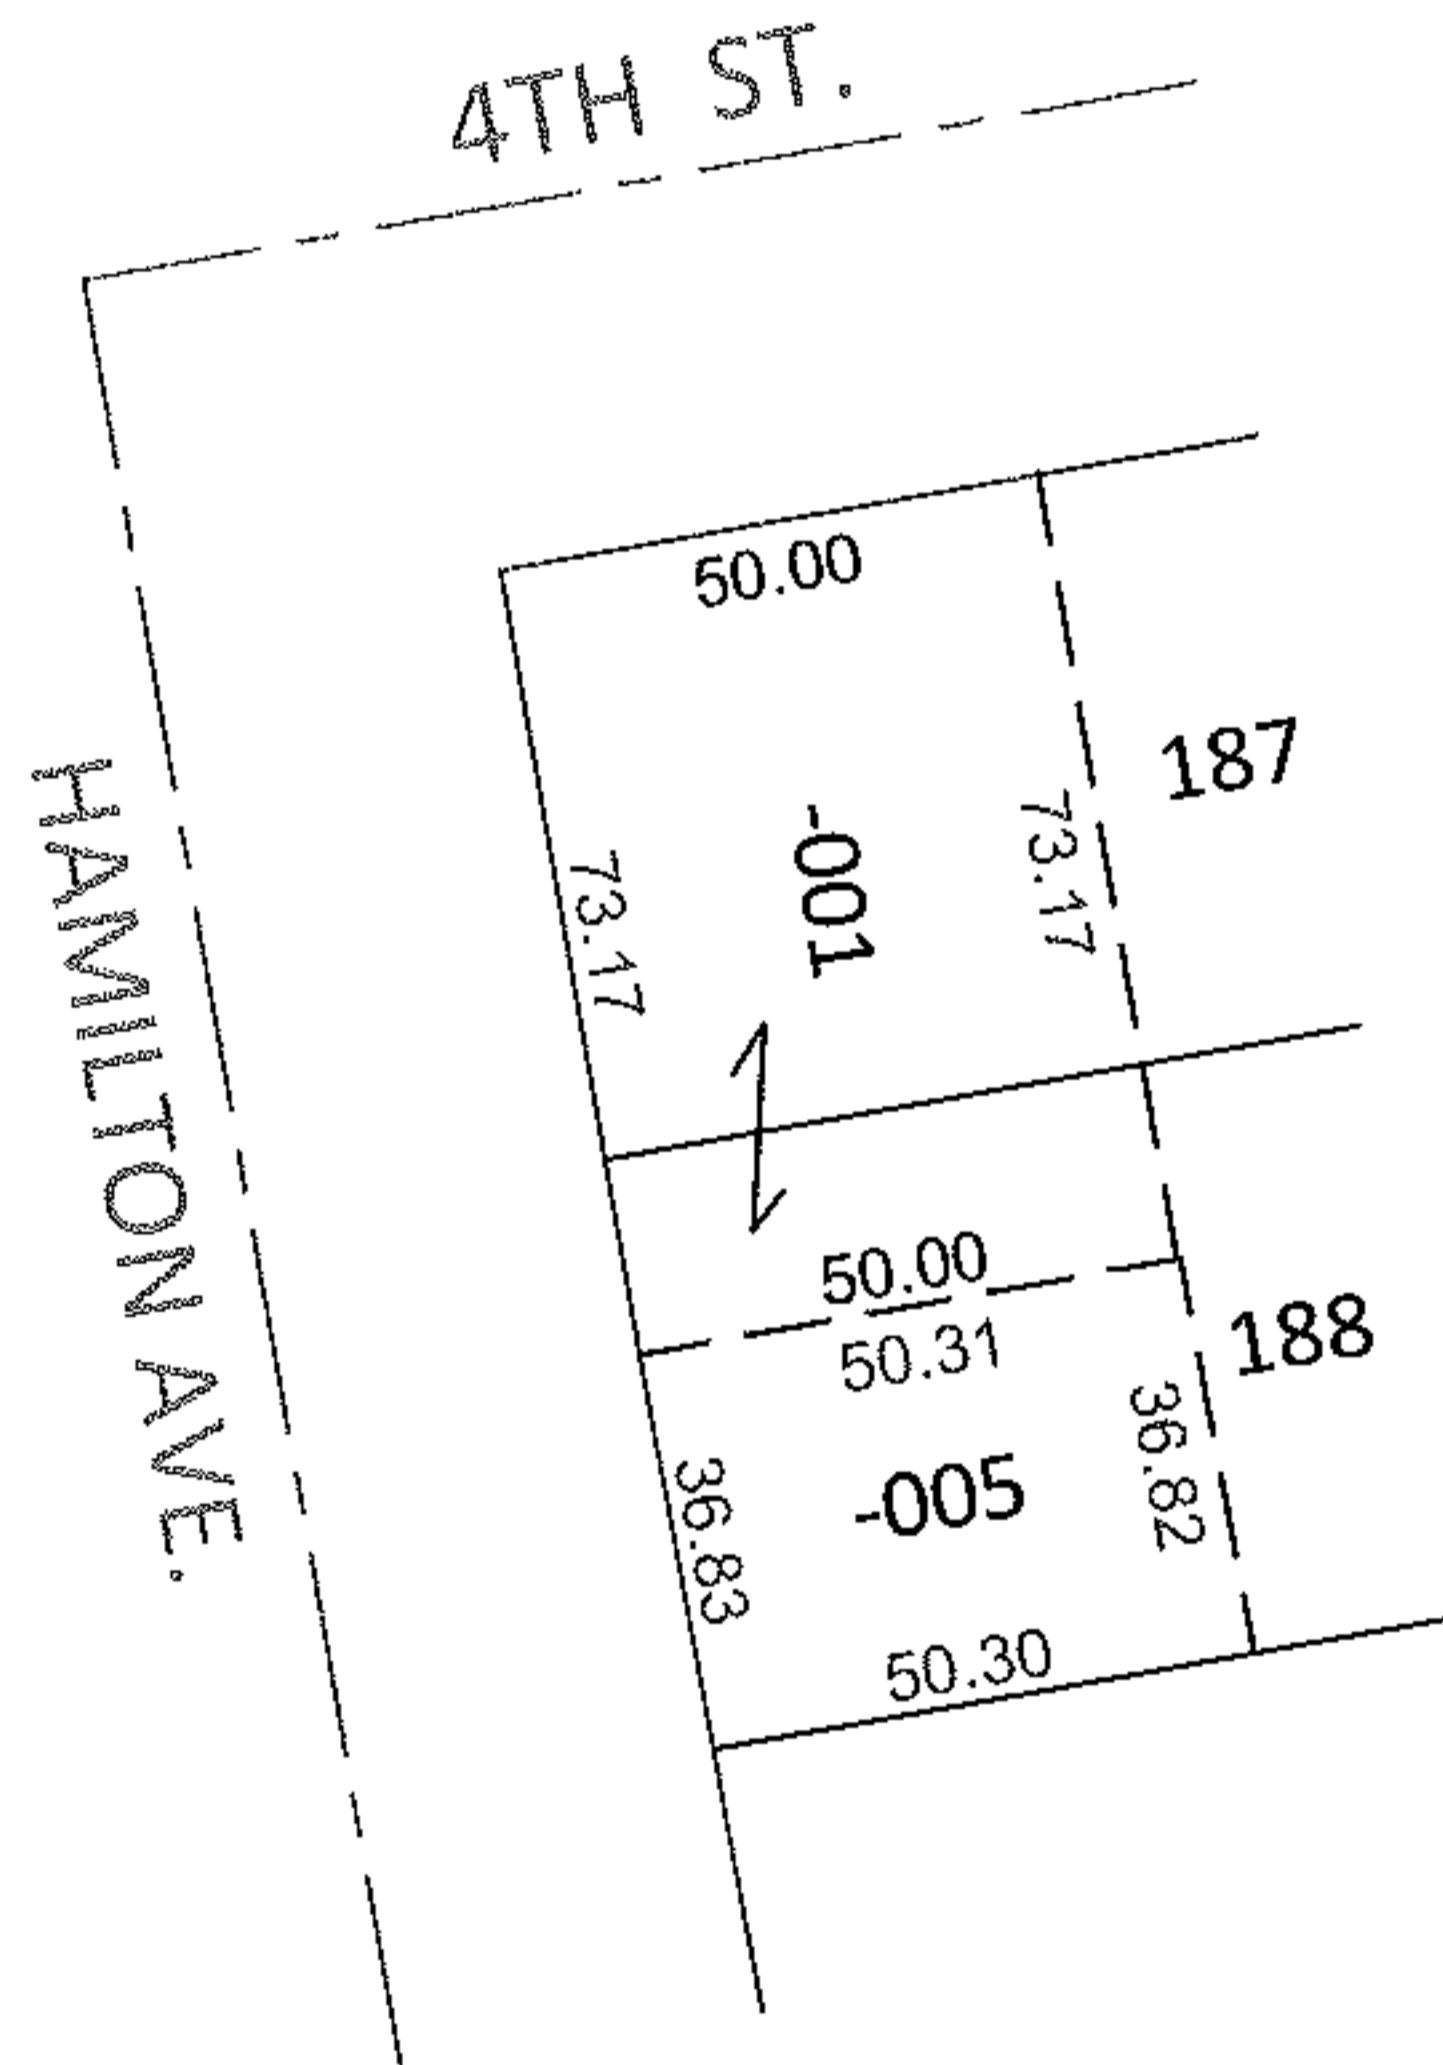


PARENT PARCEL: 02-01-006-110-001, -005

CHILD PARCEL: _____

STARTING POINT: PARTS OF S/L'S 187 & 188 IN DURANDS PLAT OF CHARLESTON (VOL.J PG.446)

11-02350-C

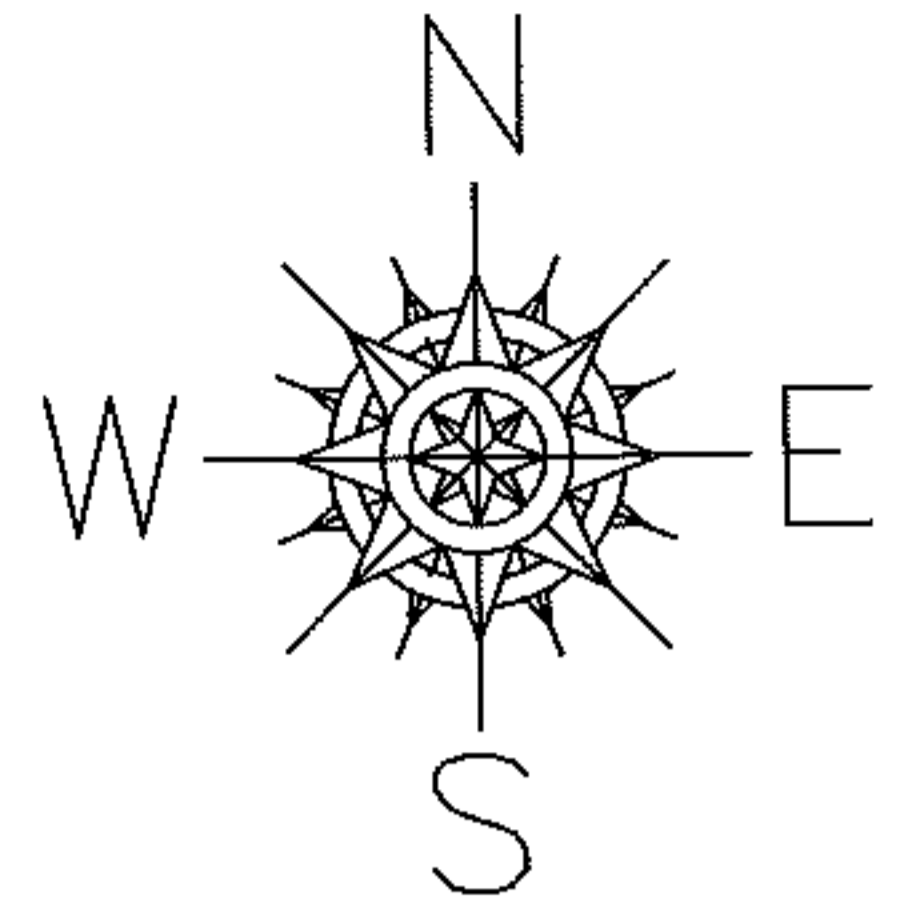

FRONTAGE AND DEPTH CORRECTION

02-01-006-110-001

73.17
~~73~~ X 50

PER PRIOR DEEDS

02-01-006-110-005

36.83 X 50.31
~~37~~ X 50

PER SURV. R.CARLSON

SPLITS/DEEDS PROCESSED

LORAIN COUNTY TAX MAP DEPARTMENT
226 MIDDLE AVE. ELYRIA, OHIO

SURVEYED BY: RICHARD D. CARLSON

CLOSURE: .01:10,000

MAP PAGE(S): 2-01-006-B

APPROVED BY: RRM DATE: 9-26-11

SCALE: 1" = 50' PRIOR INST.: 20070204615

