
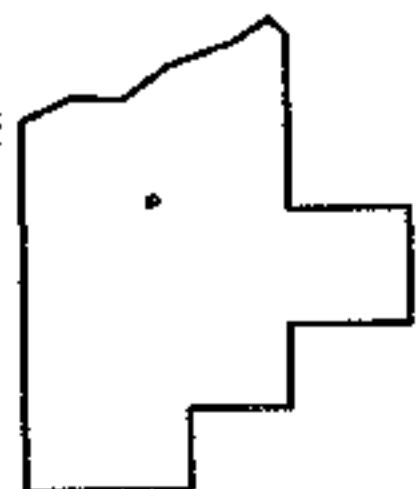
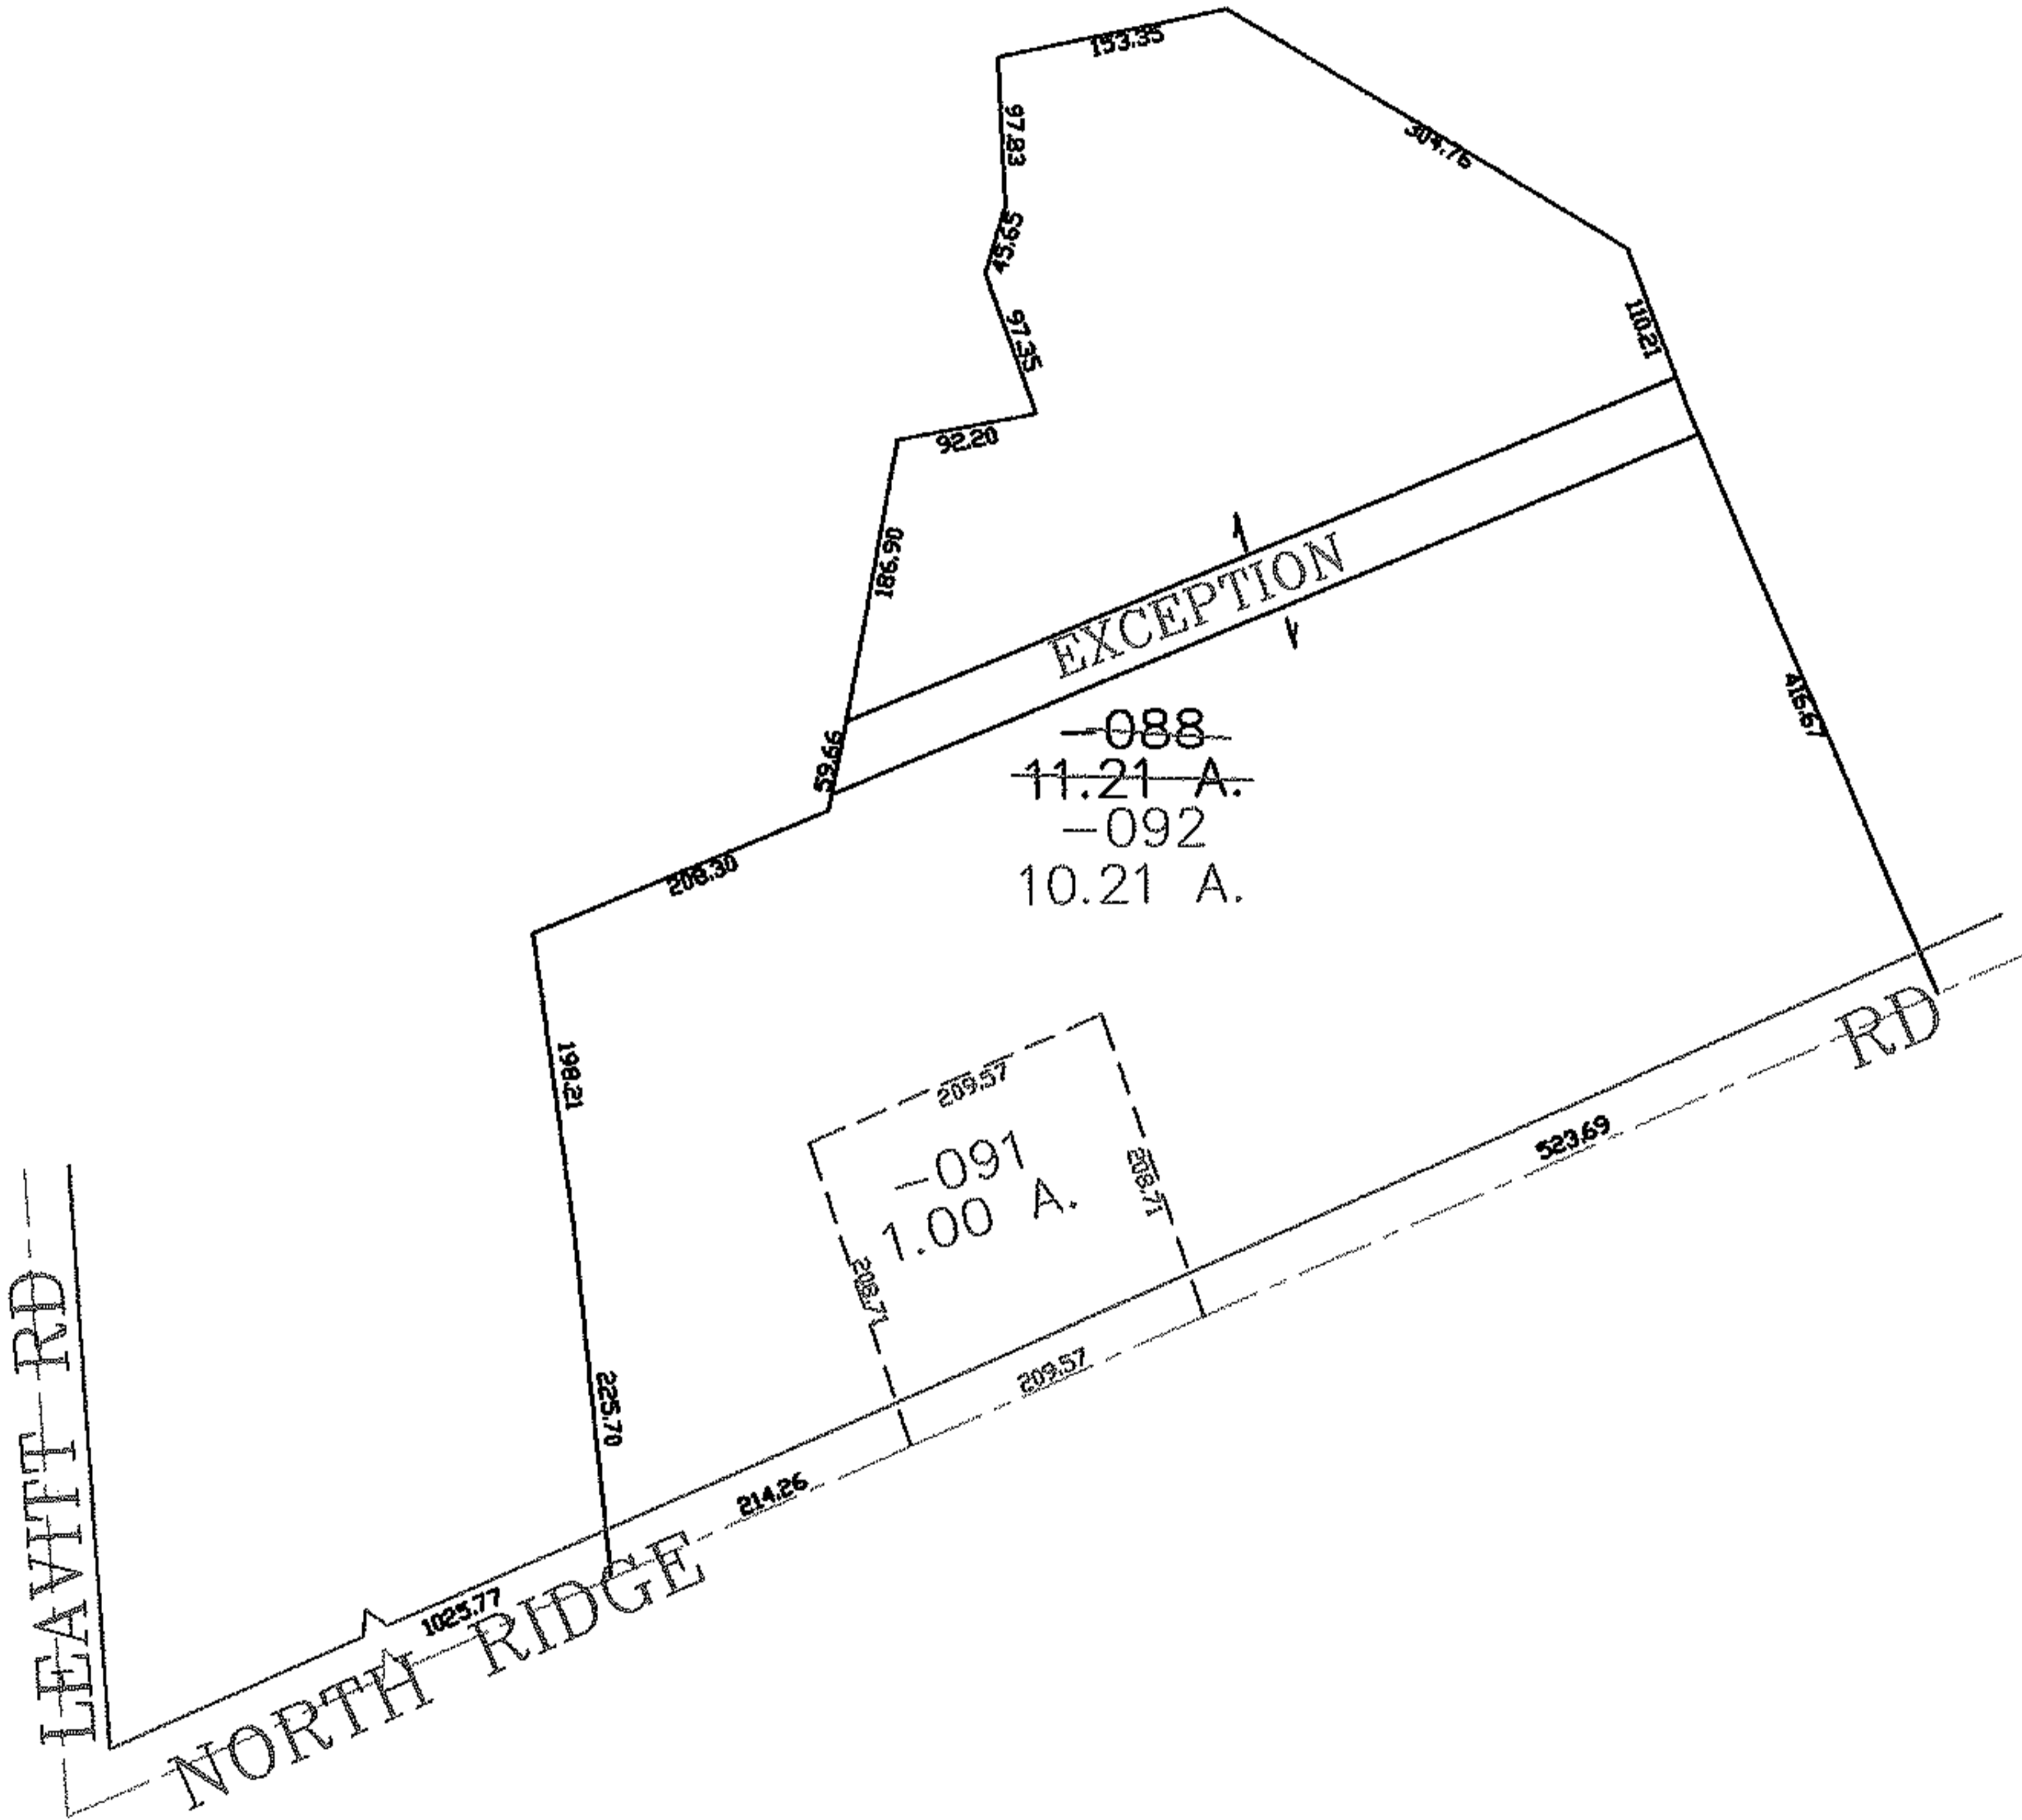


PARENT PARCEL: 05-00-042-104-088

CHILD PARCEL: 05-00-042-104-091, -092

STARTING POINT: CENTERLINE OF NORTH RIDGE RD * LEAVITT RD

07-02350

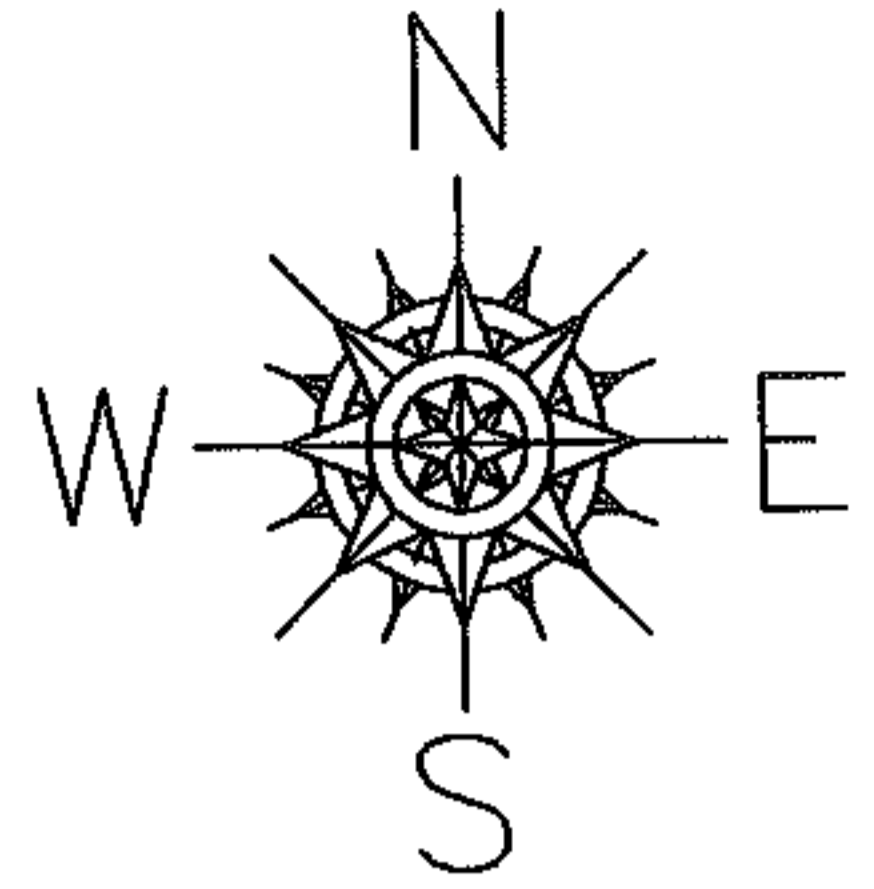

SPLITS/DEEDS PROCESSED

LORAIN COUNTY TAX MAP DEPARTMENT
226 MIDDLE AVE. ELYRIA, OHIO

SURVEYED BY: THOMAS SIMON

CLOSURE: 0.00 : 10.000

MAP PAGE(S): 05-00-042-A

APPROVED BY: JAH DATE: 4-2-07

SCALE: 1" = 200 PRIOR INSTRUMENT: OR 445/214