



RASTER

PARENT PARCEL: 04-00-018-130-047

11-02351-A

CHILD PARCEL:

STARTING POINT: CENTERLINE OF LAKE RD & MAPLE CLIFF DR

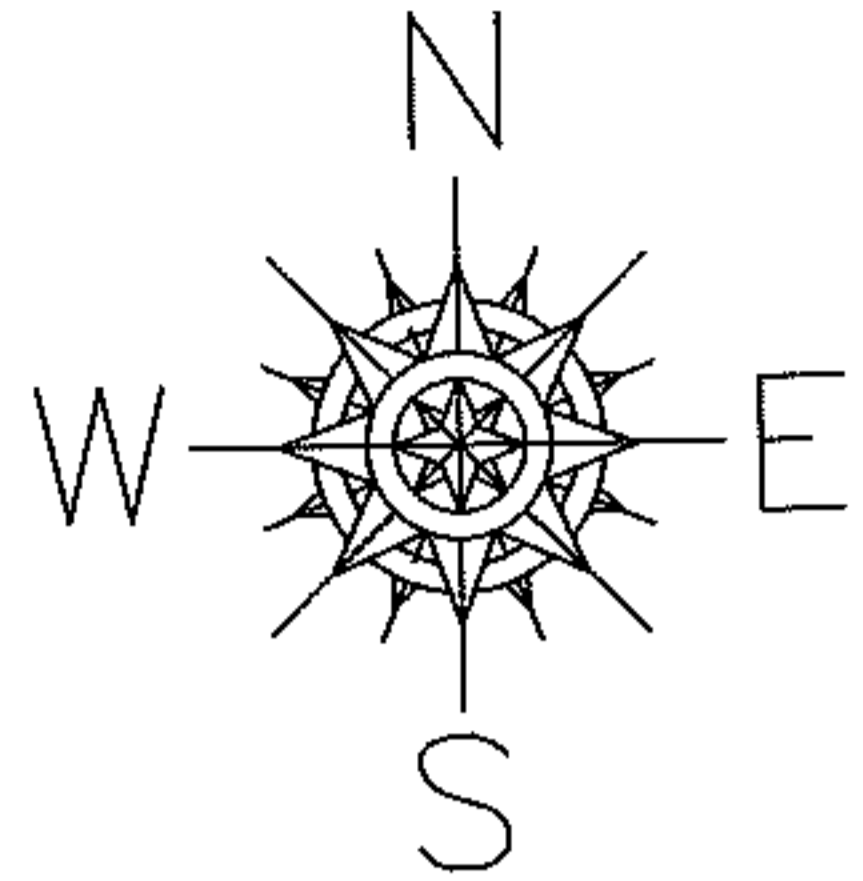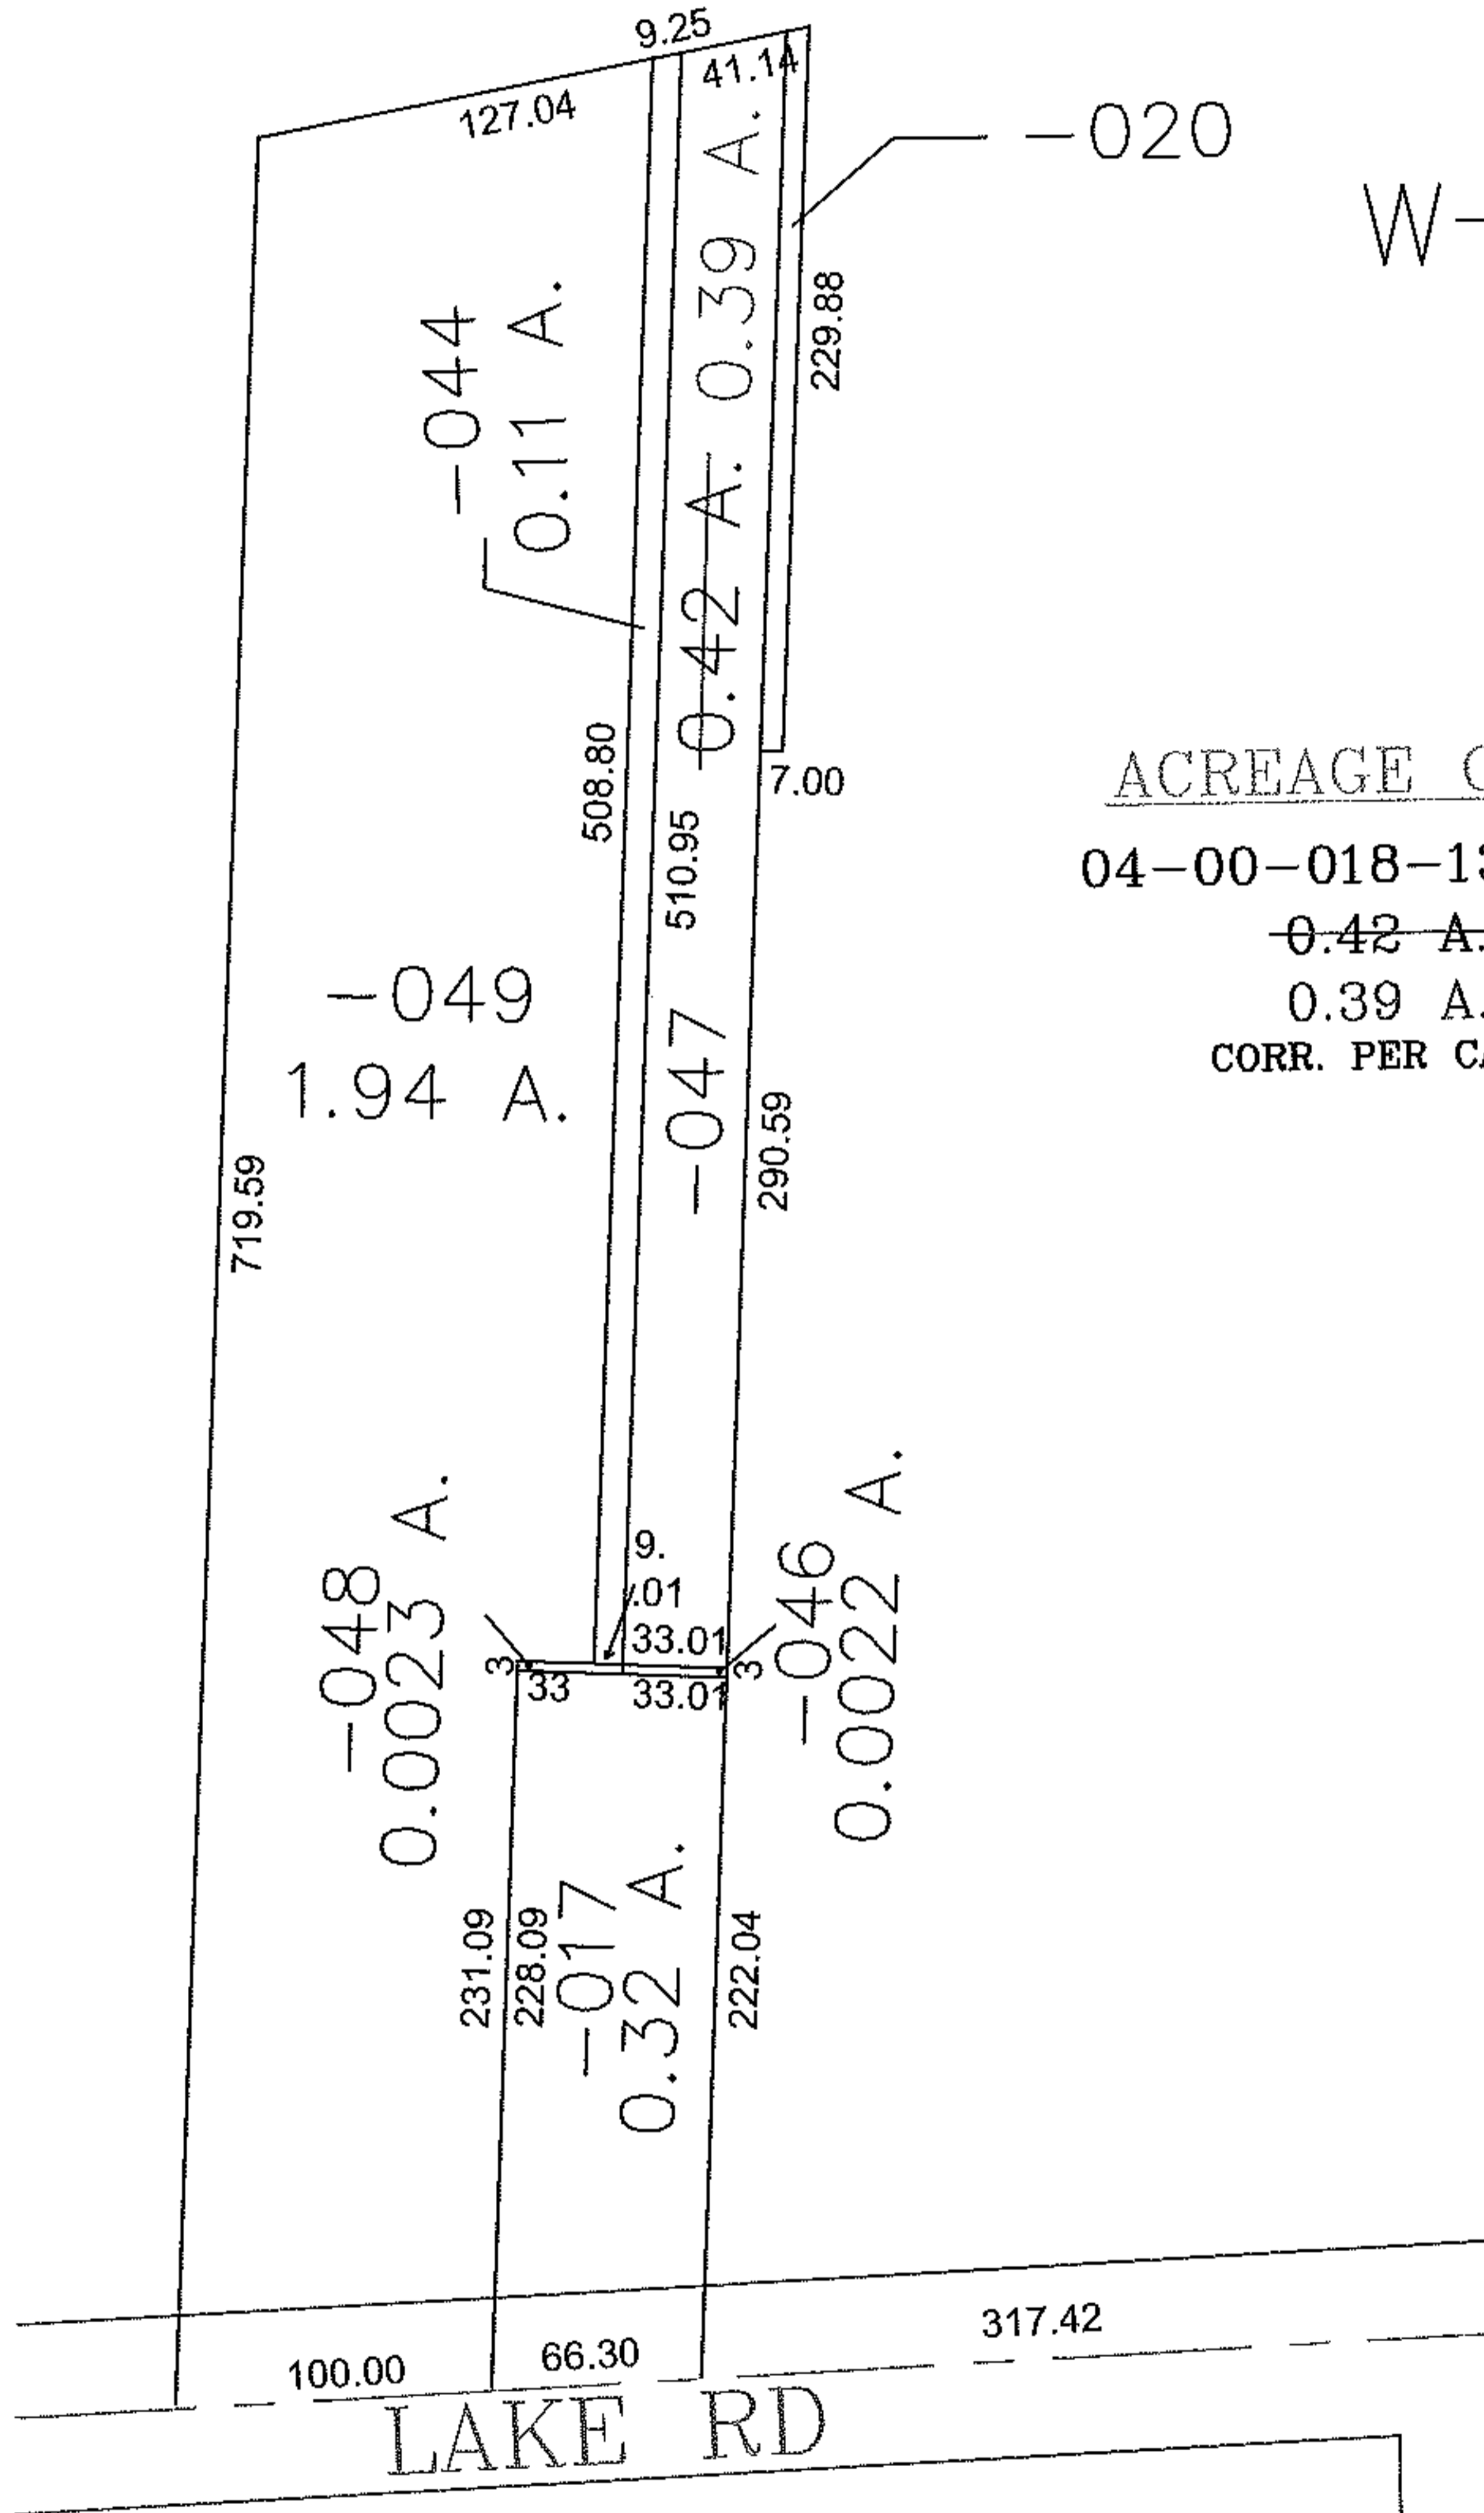

ACREAGE CORR.

04-00-018-130-047

~~0.42 A.~~

0.39 A.

CORR. PER CALC.

MAPLE CLIFF DR

SPLITS/DEEDS PROCESSED

LORAIN COUNTY TAX MAP DEPARTMENT
226 MIDDLE AVE. ELYRIA, OHIO

SURVEYED BY: EDWARD B DUDLEY

CLOSURE: 0.00 : 10.000

MAP PAGE(S): 04-00-018-C

APPROVED BY: TJS DATE: 9/14/11

SCALE: 1" = 100 PRIOR INSTRUMENT: 20080240598