


PARENT PARCEL: 04-00-030-124-046

CHILD PARCEL: 04-00-030-124-047 THRU -050

07-02355

STARTING POINT: INTERSECTION OF EAST R.O.W. LINE OF LAKEWOOD DR. AND SOUTH R.O.W. LINE OF CLIFTON DR.


CLIFTON DR.

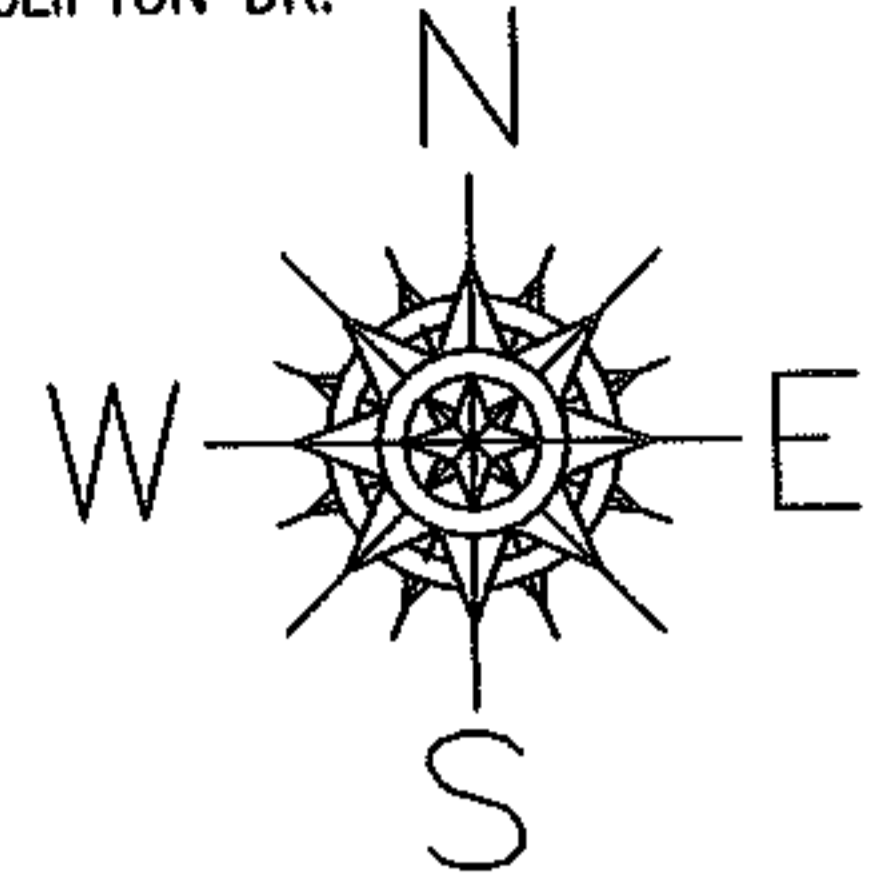

LAKWOOD DR.

254.78

04-00-030-124-046	100 X 91.83
04-00-030-124-047	20 X 91.58
04-00-030-124-048	30 X 91.59
04-00-030-124-049	10 X 91.59
04-00-030-124-050	40 X 91.60

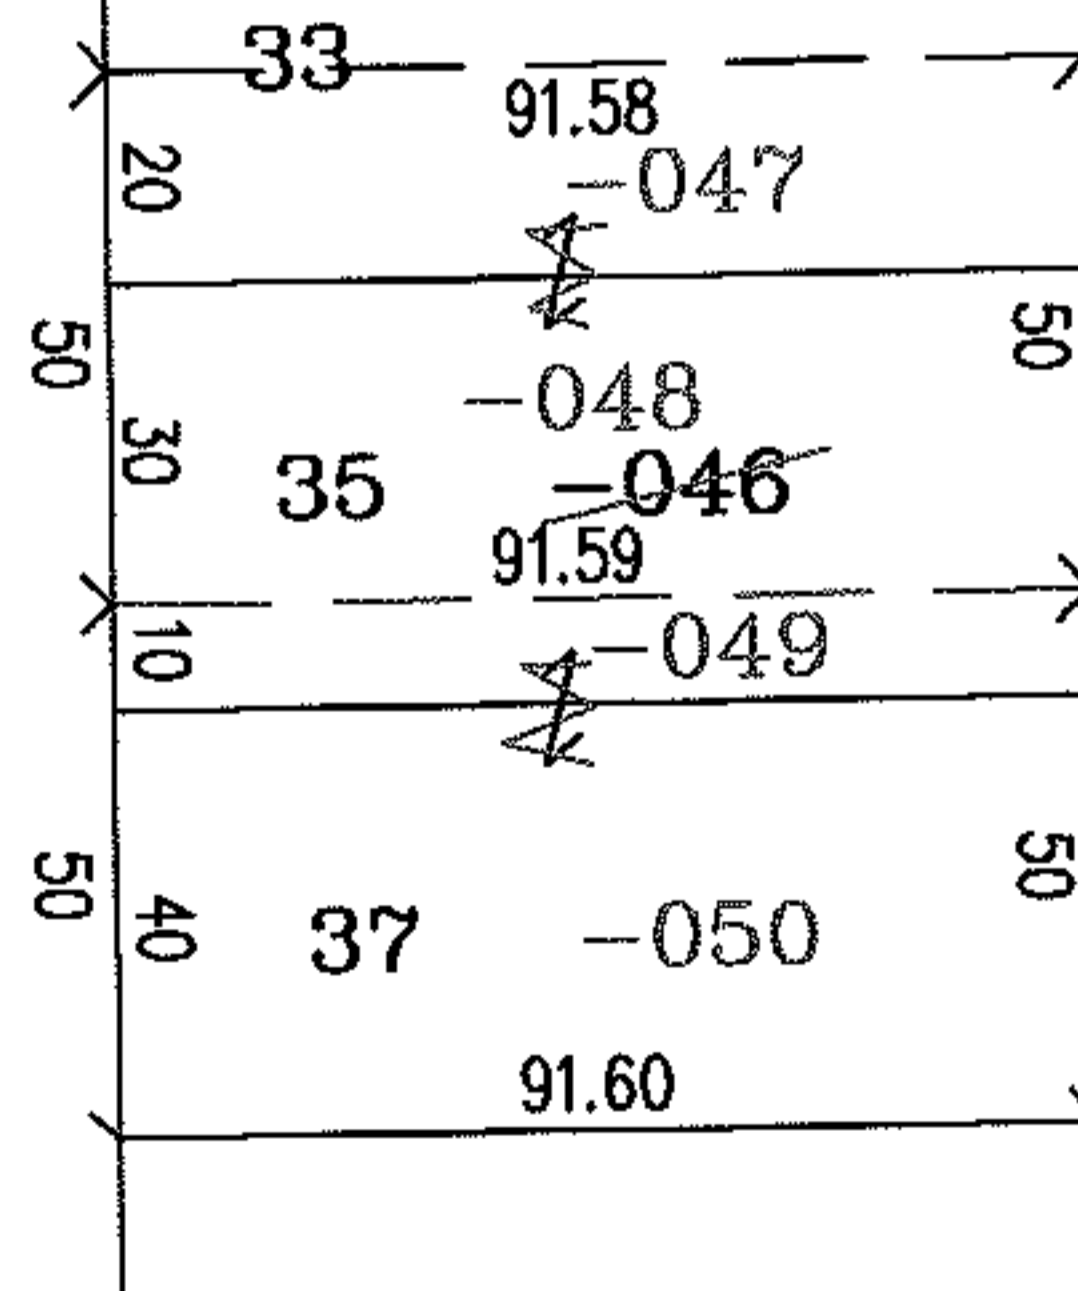

SPLITS/DEEDS PROCESSED

LORAIN COUNTY TAX MAP DEPARTMENT
226 MIDDLE AVE. ELYRIA, OHIO

SURVEYED BY: DAVID L. ELWELL

CLOSURE: .00:10.000

MAP PAGE(S): 4-00-030-A

APPROVED BY: RRM DATE: 4/12/07

SCALE: 1" = 50 PRIOR INSTRUMENT: 20070188171