


PARENT PARCEL: 04-00-029-000-782

CHILD PARCEL: _____

STARTING POINT: INTERSECTION OF C/L OF LEAR NAGLE RD. AND C/L OF WALKER RD.

11-02357-A

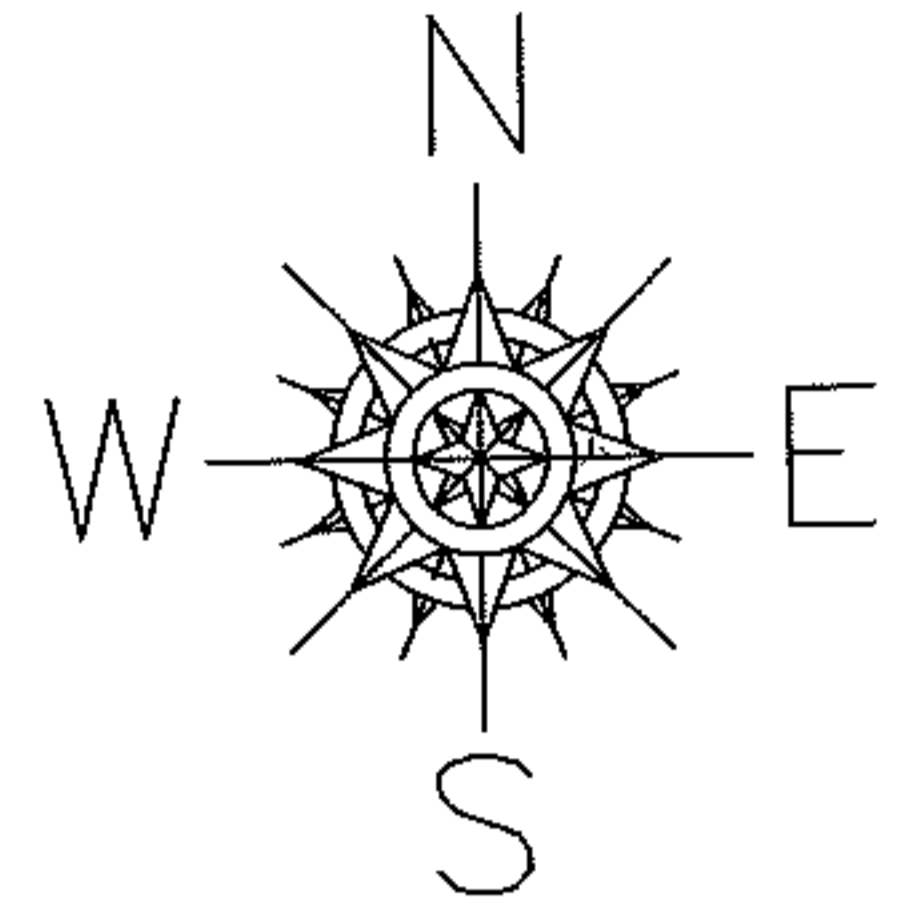

LEAR NAGLE RD.

WALKER RD.

2289.50

50.00

125.00

36.68

298.00

AC. CORR. PER SURV.
M. STRAUB

~~1.16 A.~~
1.11 A.

161.68

298.00

-782

SPLITS/DEEDS PROCESSED

LORAIN COUNTY TAX MAP DEPARTMENT
226 MIDDLE AVE. ELYRIA, OHIO

SURVEYED BY: MICHAEL STRAUB

CLOSURE: .01:10,000

MAP PAGE(S): 4-00-029-B

APPROVED BY: RRM DATE: 9-26-11

SCALE: 1"= 100 PRIOR INST.: 20050074475