


RASTER

PARENT PARCEL: 06-23-008-104-049 & -055

CHILD PARCEL: 06-23-009-102-076 & -077

STARTING POINT: XXXXXX

11-02359-C

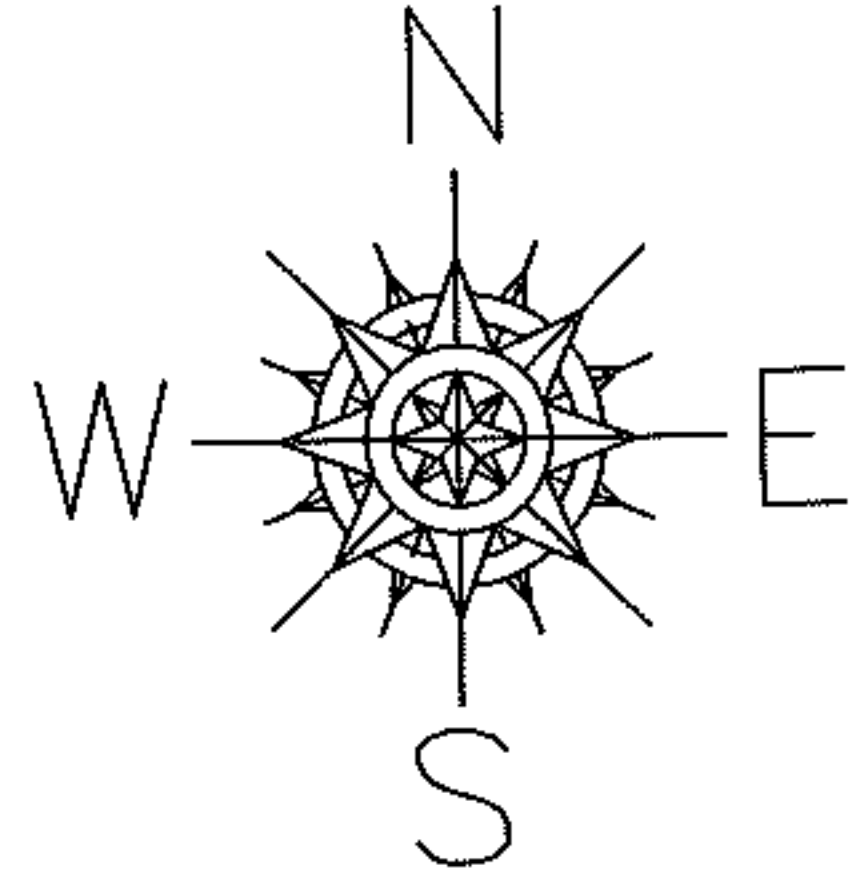

PARCEL RENUMBER

~~06-23-008-104-049~~

~~0.07 A.~~

06-23-009-102-076

0.07 A.


PARCEL RENUMBER

~~06-23-008-104-055~~

~~0.19 A.~~

06-23-009-102-077

0.19 A.

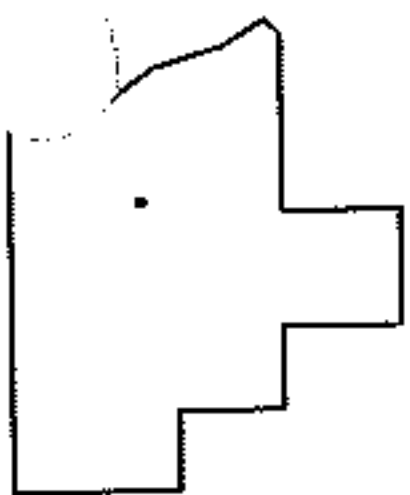

SPLITS/DEEDS PROCESSED

LORAIN COUNTY TAX MAP DEPARTMENT  
226 MIDDLE AVE. ELYRIA, OHIO

SURVEYED BY: NONE

CLOSURE: NONE

MAP PAGE(S): 6-24

APPROVED BY: TJS DATE: 9/28/11

SCALE: 1"= 50' PRIOR INST.: DV XXXX/XXX