
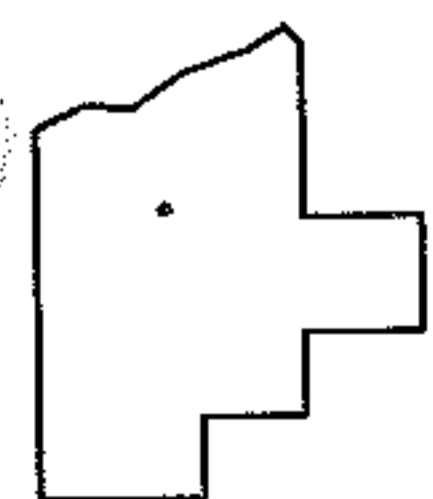
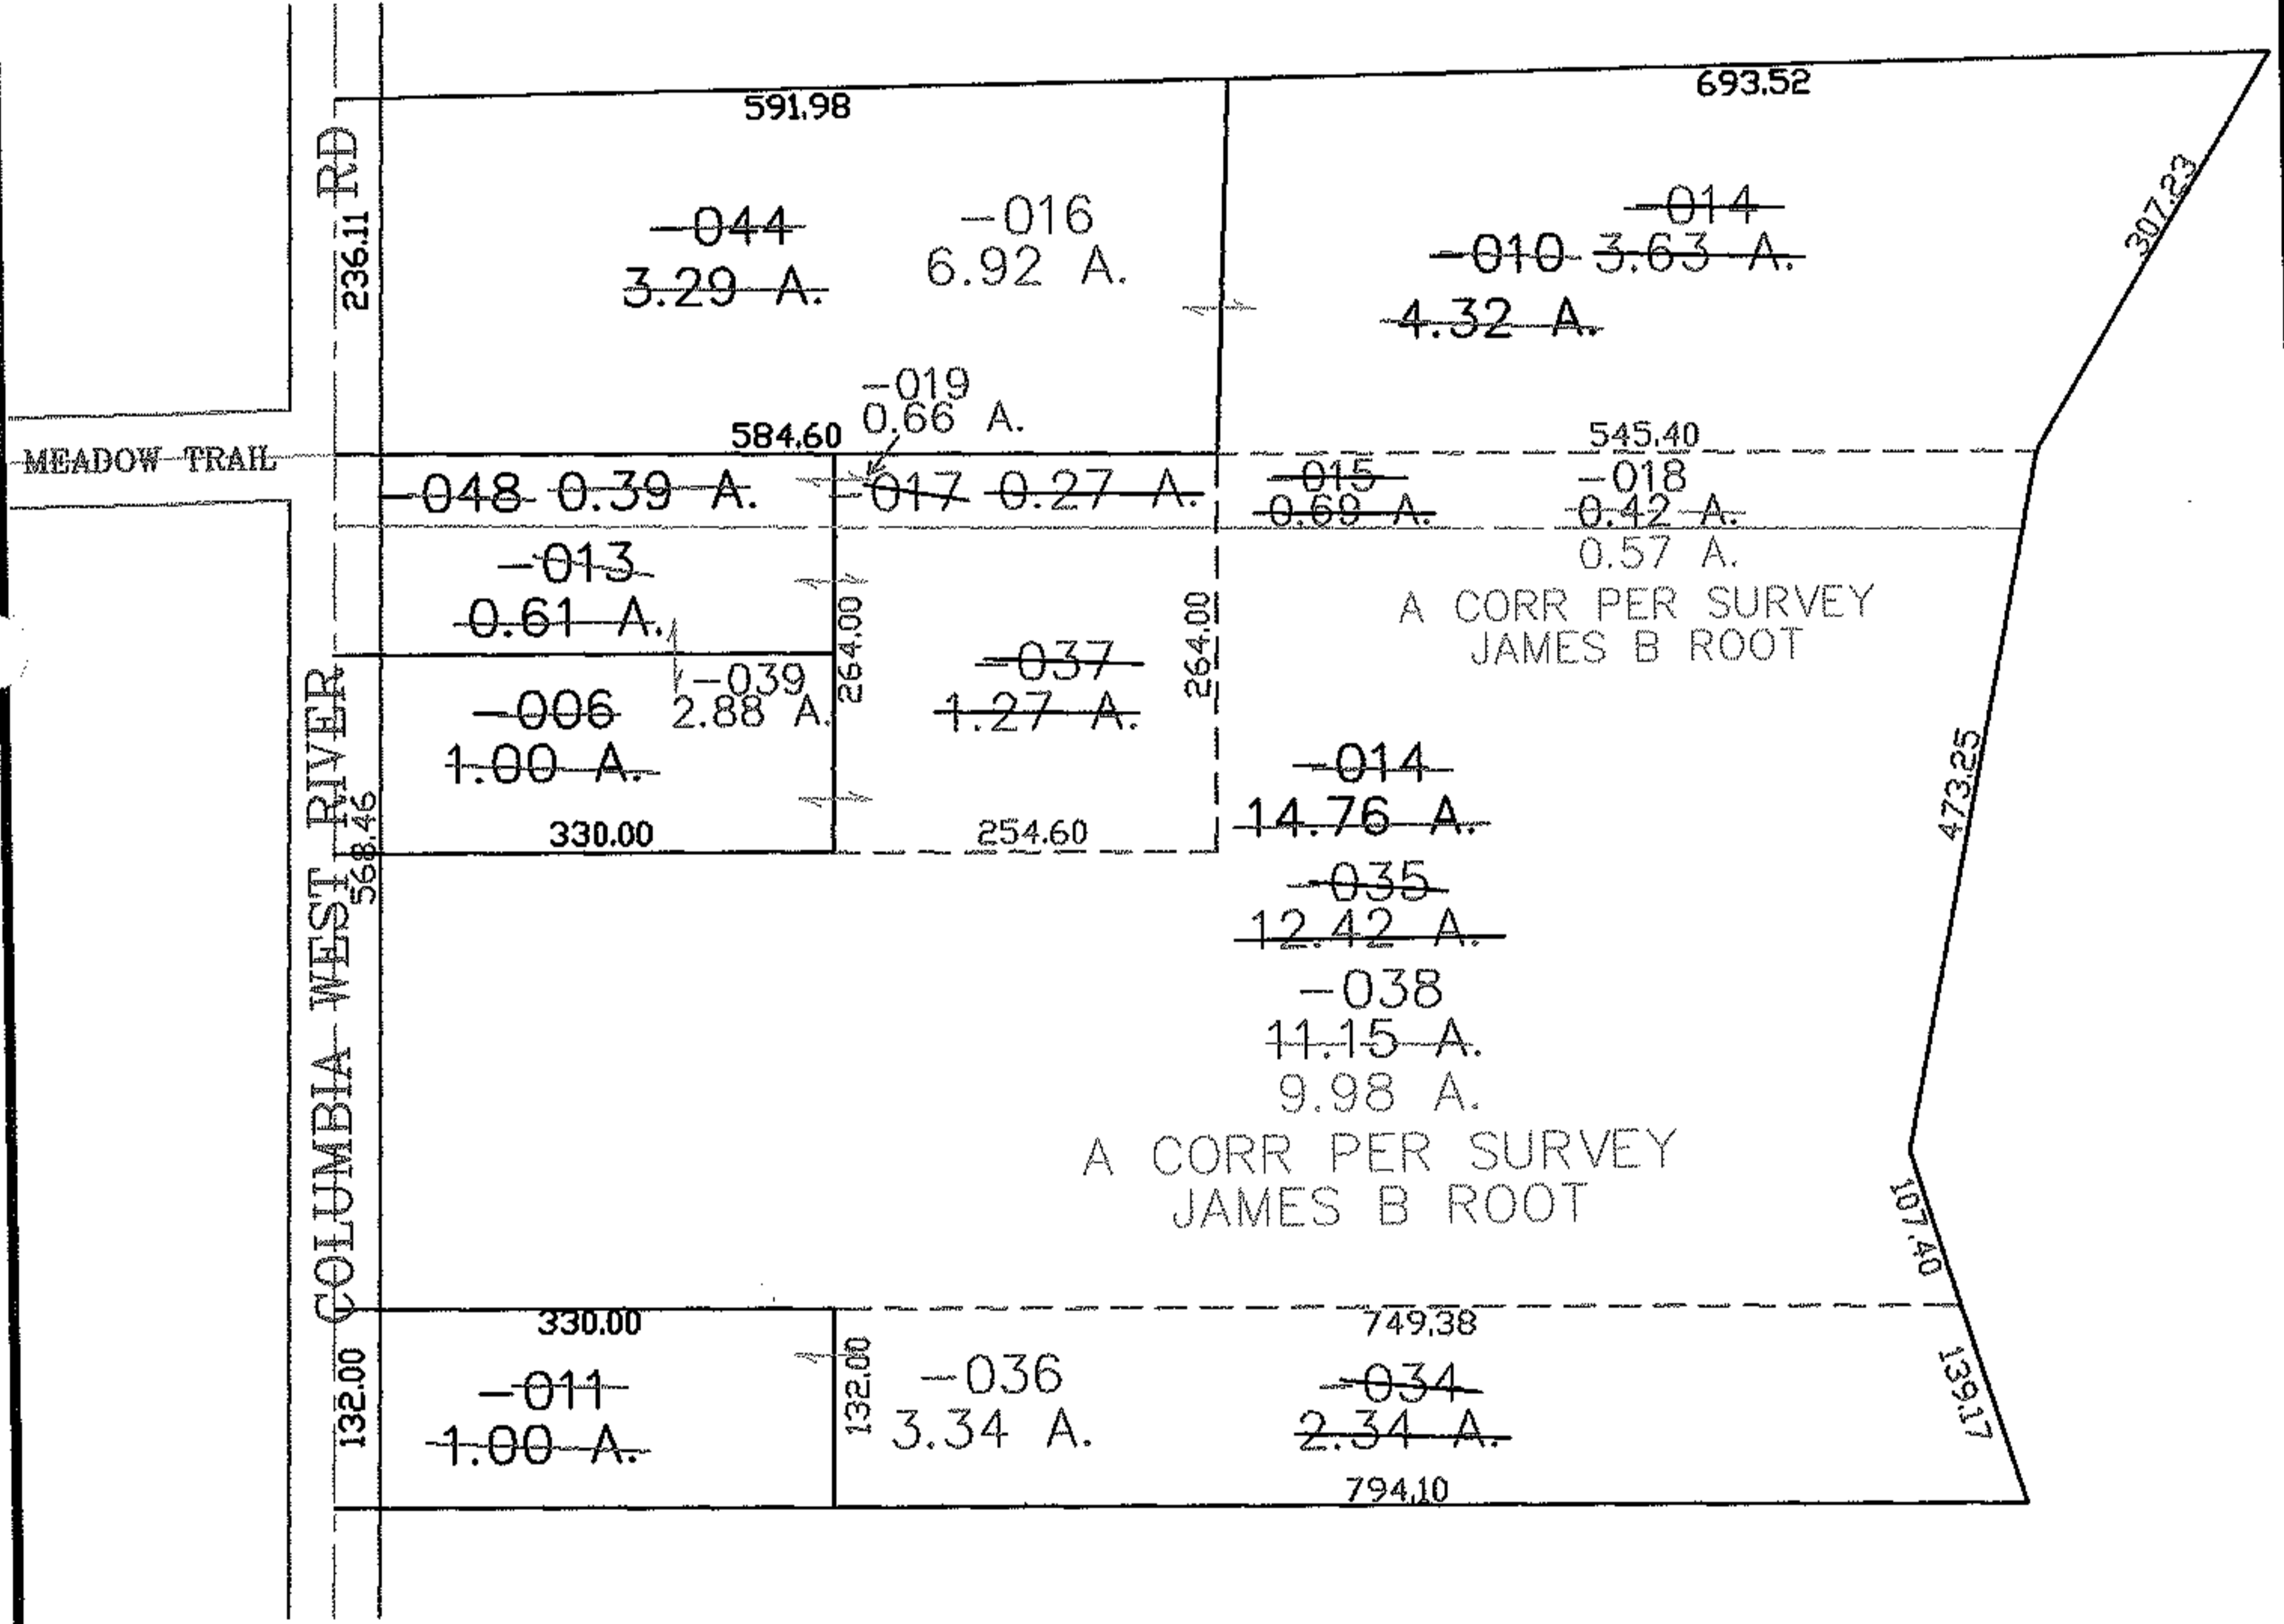


RASTER

PARENT PARCEL: 12-00-048-000-014 -011 -006 12-00-047-103-010-044
CHILD PARCEL: 12-00-048-000-034 THRU -039, 12-00-047-103-014 THRU -019
STARTING POINT: CENTERLINE OF COLUMBIA WEST RIVER RD & MEADOW TRAIL

07-02359

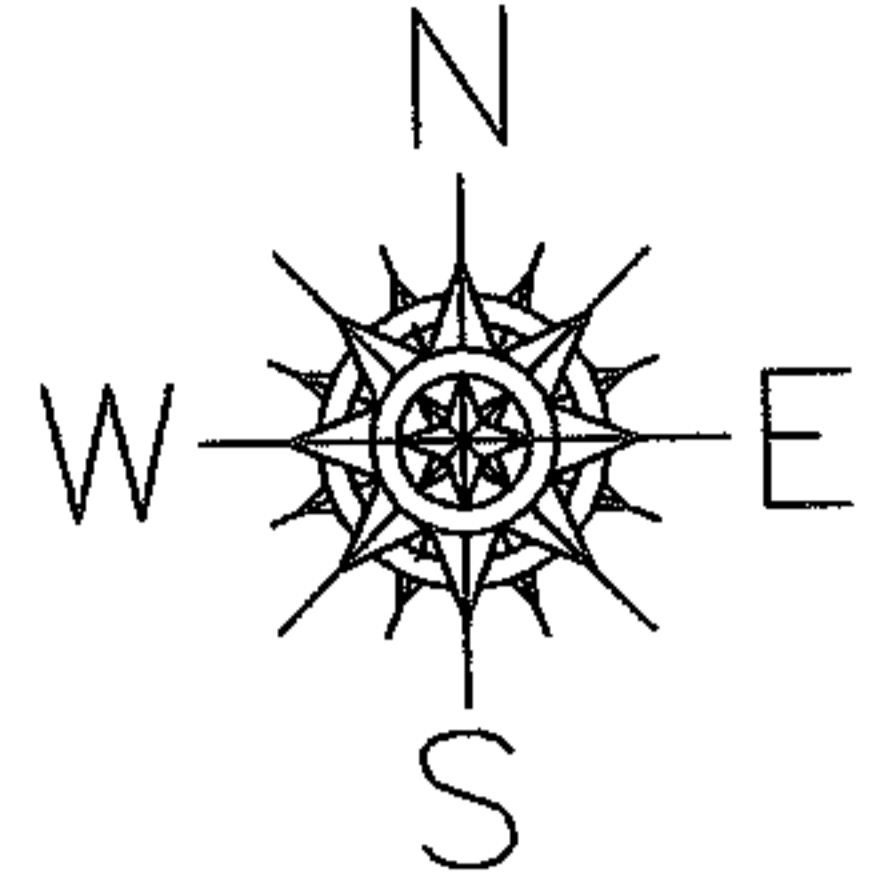

SPLITS/DEEDS PROCESSED
LORAIN COUNTY TAX MAP DEPARTMENT
226 MIDDLE AVE. ELYRIA, OHIO

SURVEYED BY: JAMES ROOT
CLOSURE: 0.00 : 10.000
MAP PAGE(S): 12-00-047-A, -048-A
APPROVED BY: JAH DATE: 04-23-07
SCALE: 1" = 200 PRIOR INSTRUMENT: 20020808436