
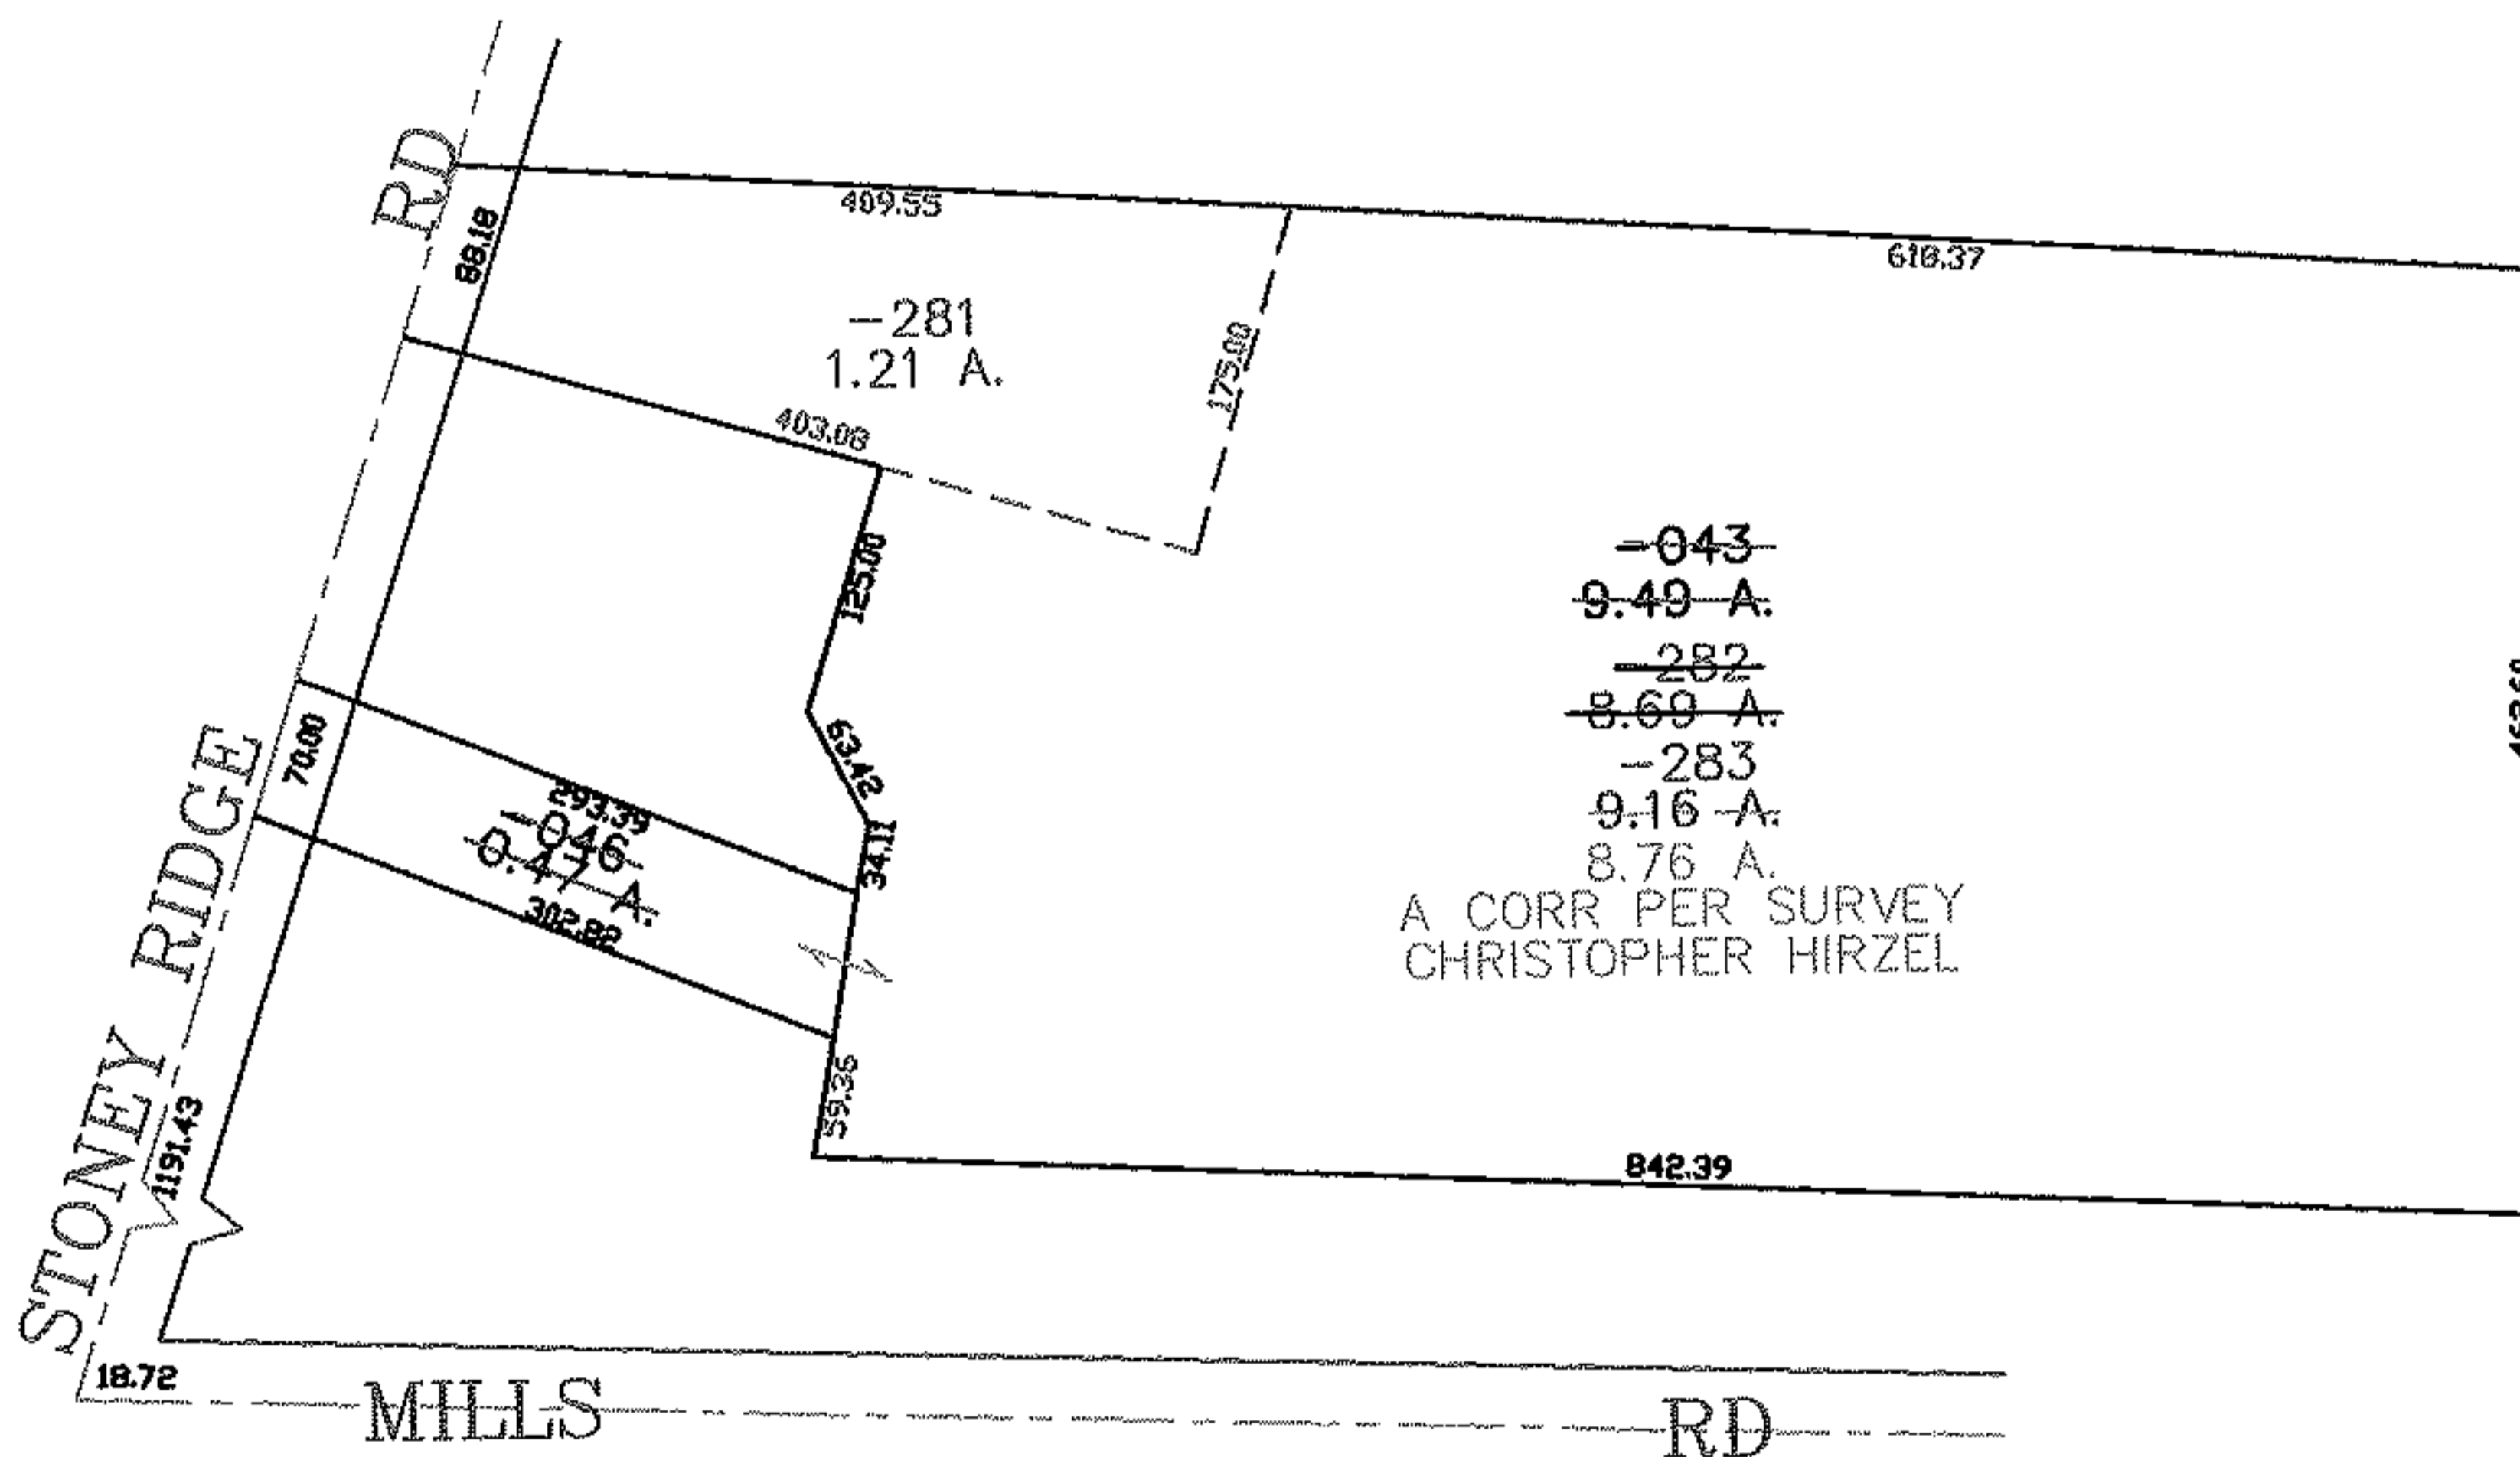


PARENT PARCEL: 04-00-012-103-043, -046

CHILD PARCEL: 04-00-012-103-281 THRU -283

STARTING POINT: CENTERLINE OF STONEY RIDGE RD & MILLS RD

07-02360

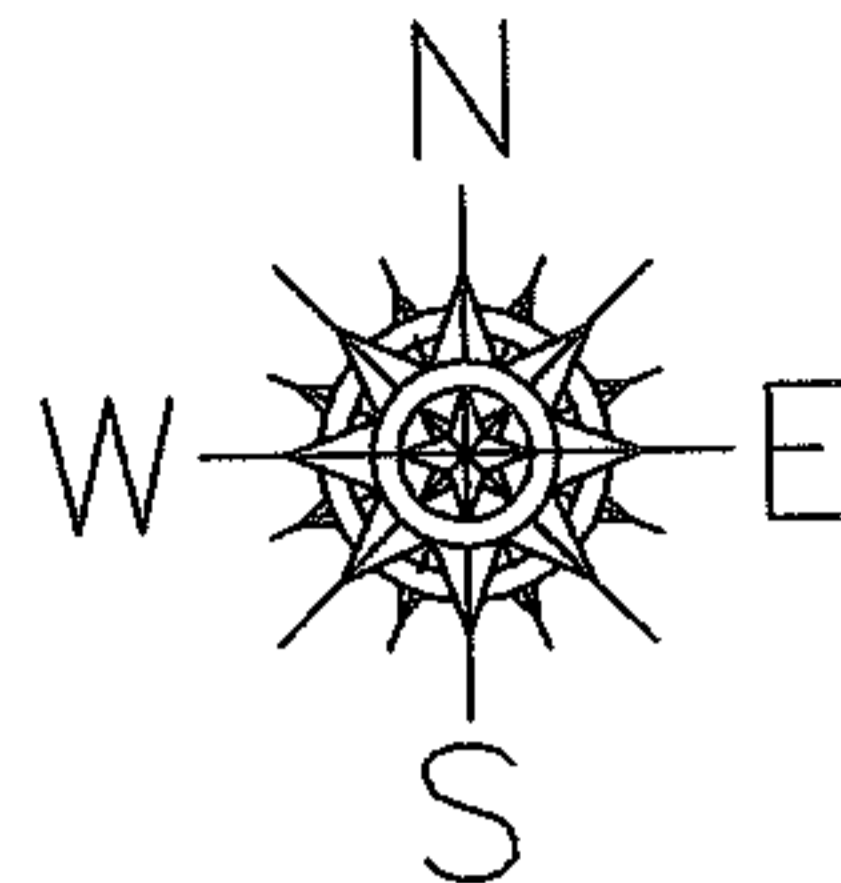

SPLITS/DEEDS PROCESSED

LORAIN COUNTY TAX MAP DEPARTMENT
226 MIDDLE AVE. ELYRIA, OHIO

SURVEYED BY: CHRISTOPHER HIRZEL

CLOSURE: 0.00 : 10.000

MAP PAGE(S): 04-00-012-G

APPROVED BY: JAH DATE: 4-18-07

SCALE: 1" = 200 PRIOR INSTRUMENT: 20070192409