
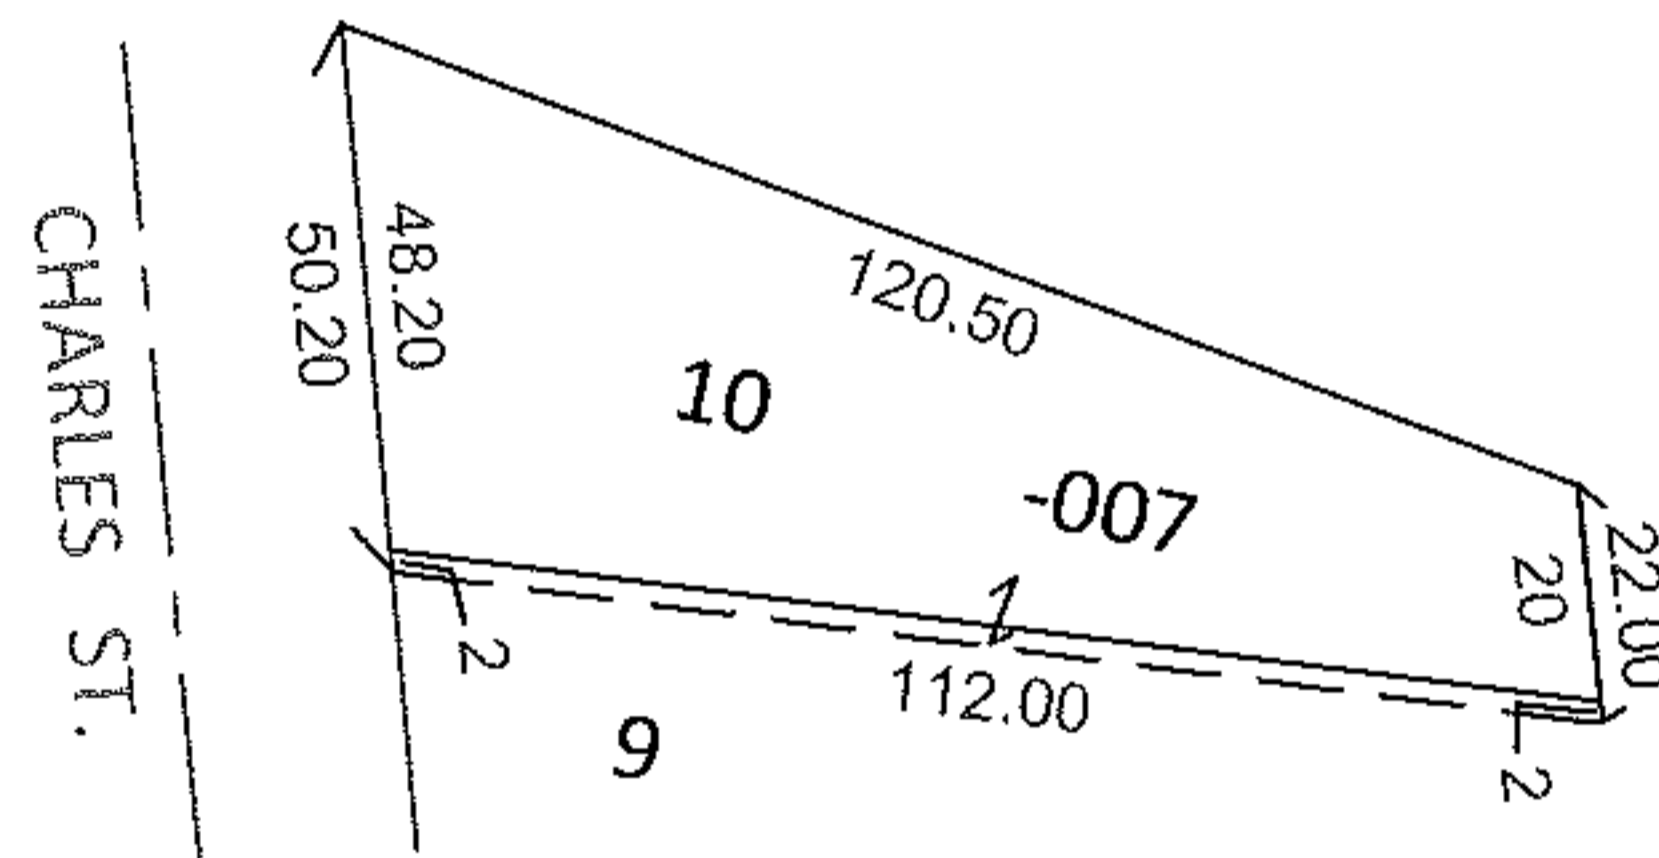


PARENT PARCEL: 06-25-098-102-007

CHILD PARCEL: _____

STARTING POINT: S/L 10 & PART OF S/L 9 IN SCHEIDE'S ADD.(VOL. 5 PG.6)

11-02361-C

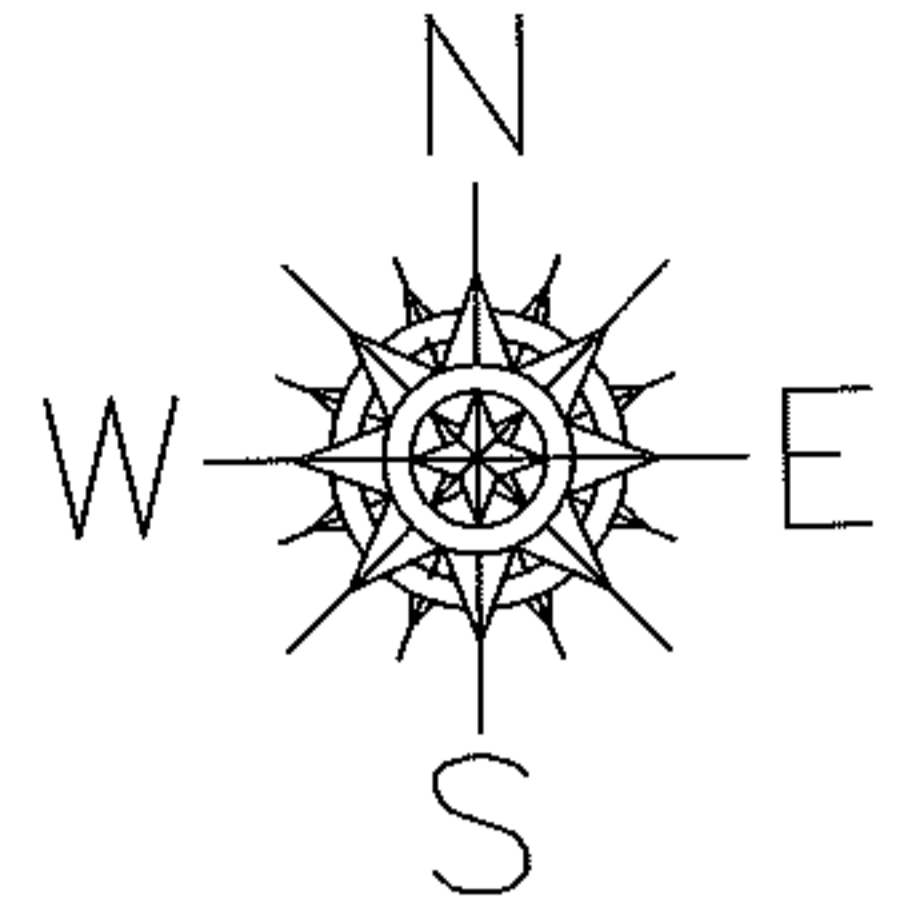


FRONTAGE AND DEPTH CORRECTION

06-25-098-102-007

50.20 X 120.50

~~48 X 112~~

PER PRIOR DEEDS

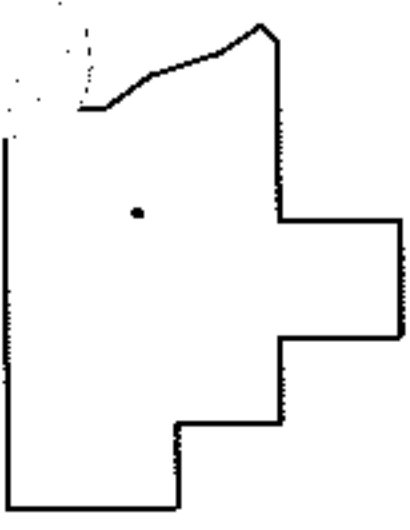

SPLITS/DEEDS PROCESSED

LORAIN COUNTY TAX MAP DEPARTMENT
226 MIDDLE AVE. ELYRIA, OHIO

SURVEYED BY: N/A

CLOSURE: N/A

MAP PAGE(S): 6-120

APPROVED BY: RRM DATE: 9-29-11

SCALE: 1" = 50' PRIOR INST.: OR 1385/914