


RASTER

PARENT PARCEL: 07-00-015-107-001


CHILD PARCEL: 07-00-015-107-014, -015

STARTING POINT: SIDELINE OF BAINBRIDGE RD & CENTERLINE OF TIMOTHY DR

07-023632

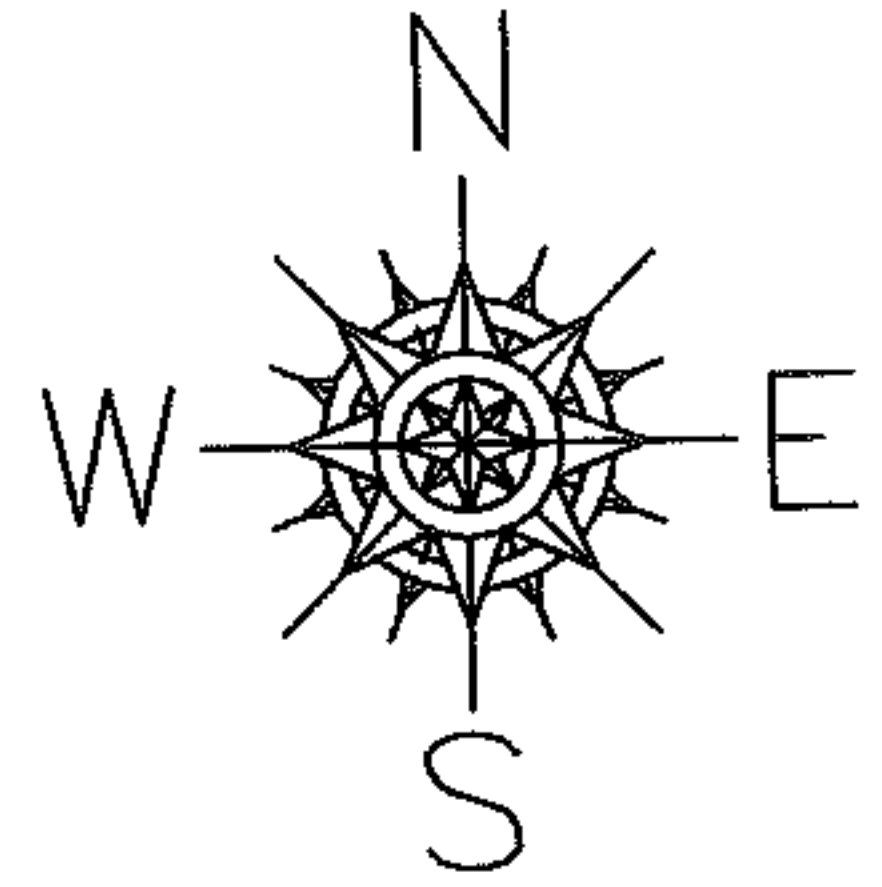

BAINBRIDGE RD

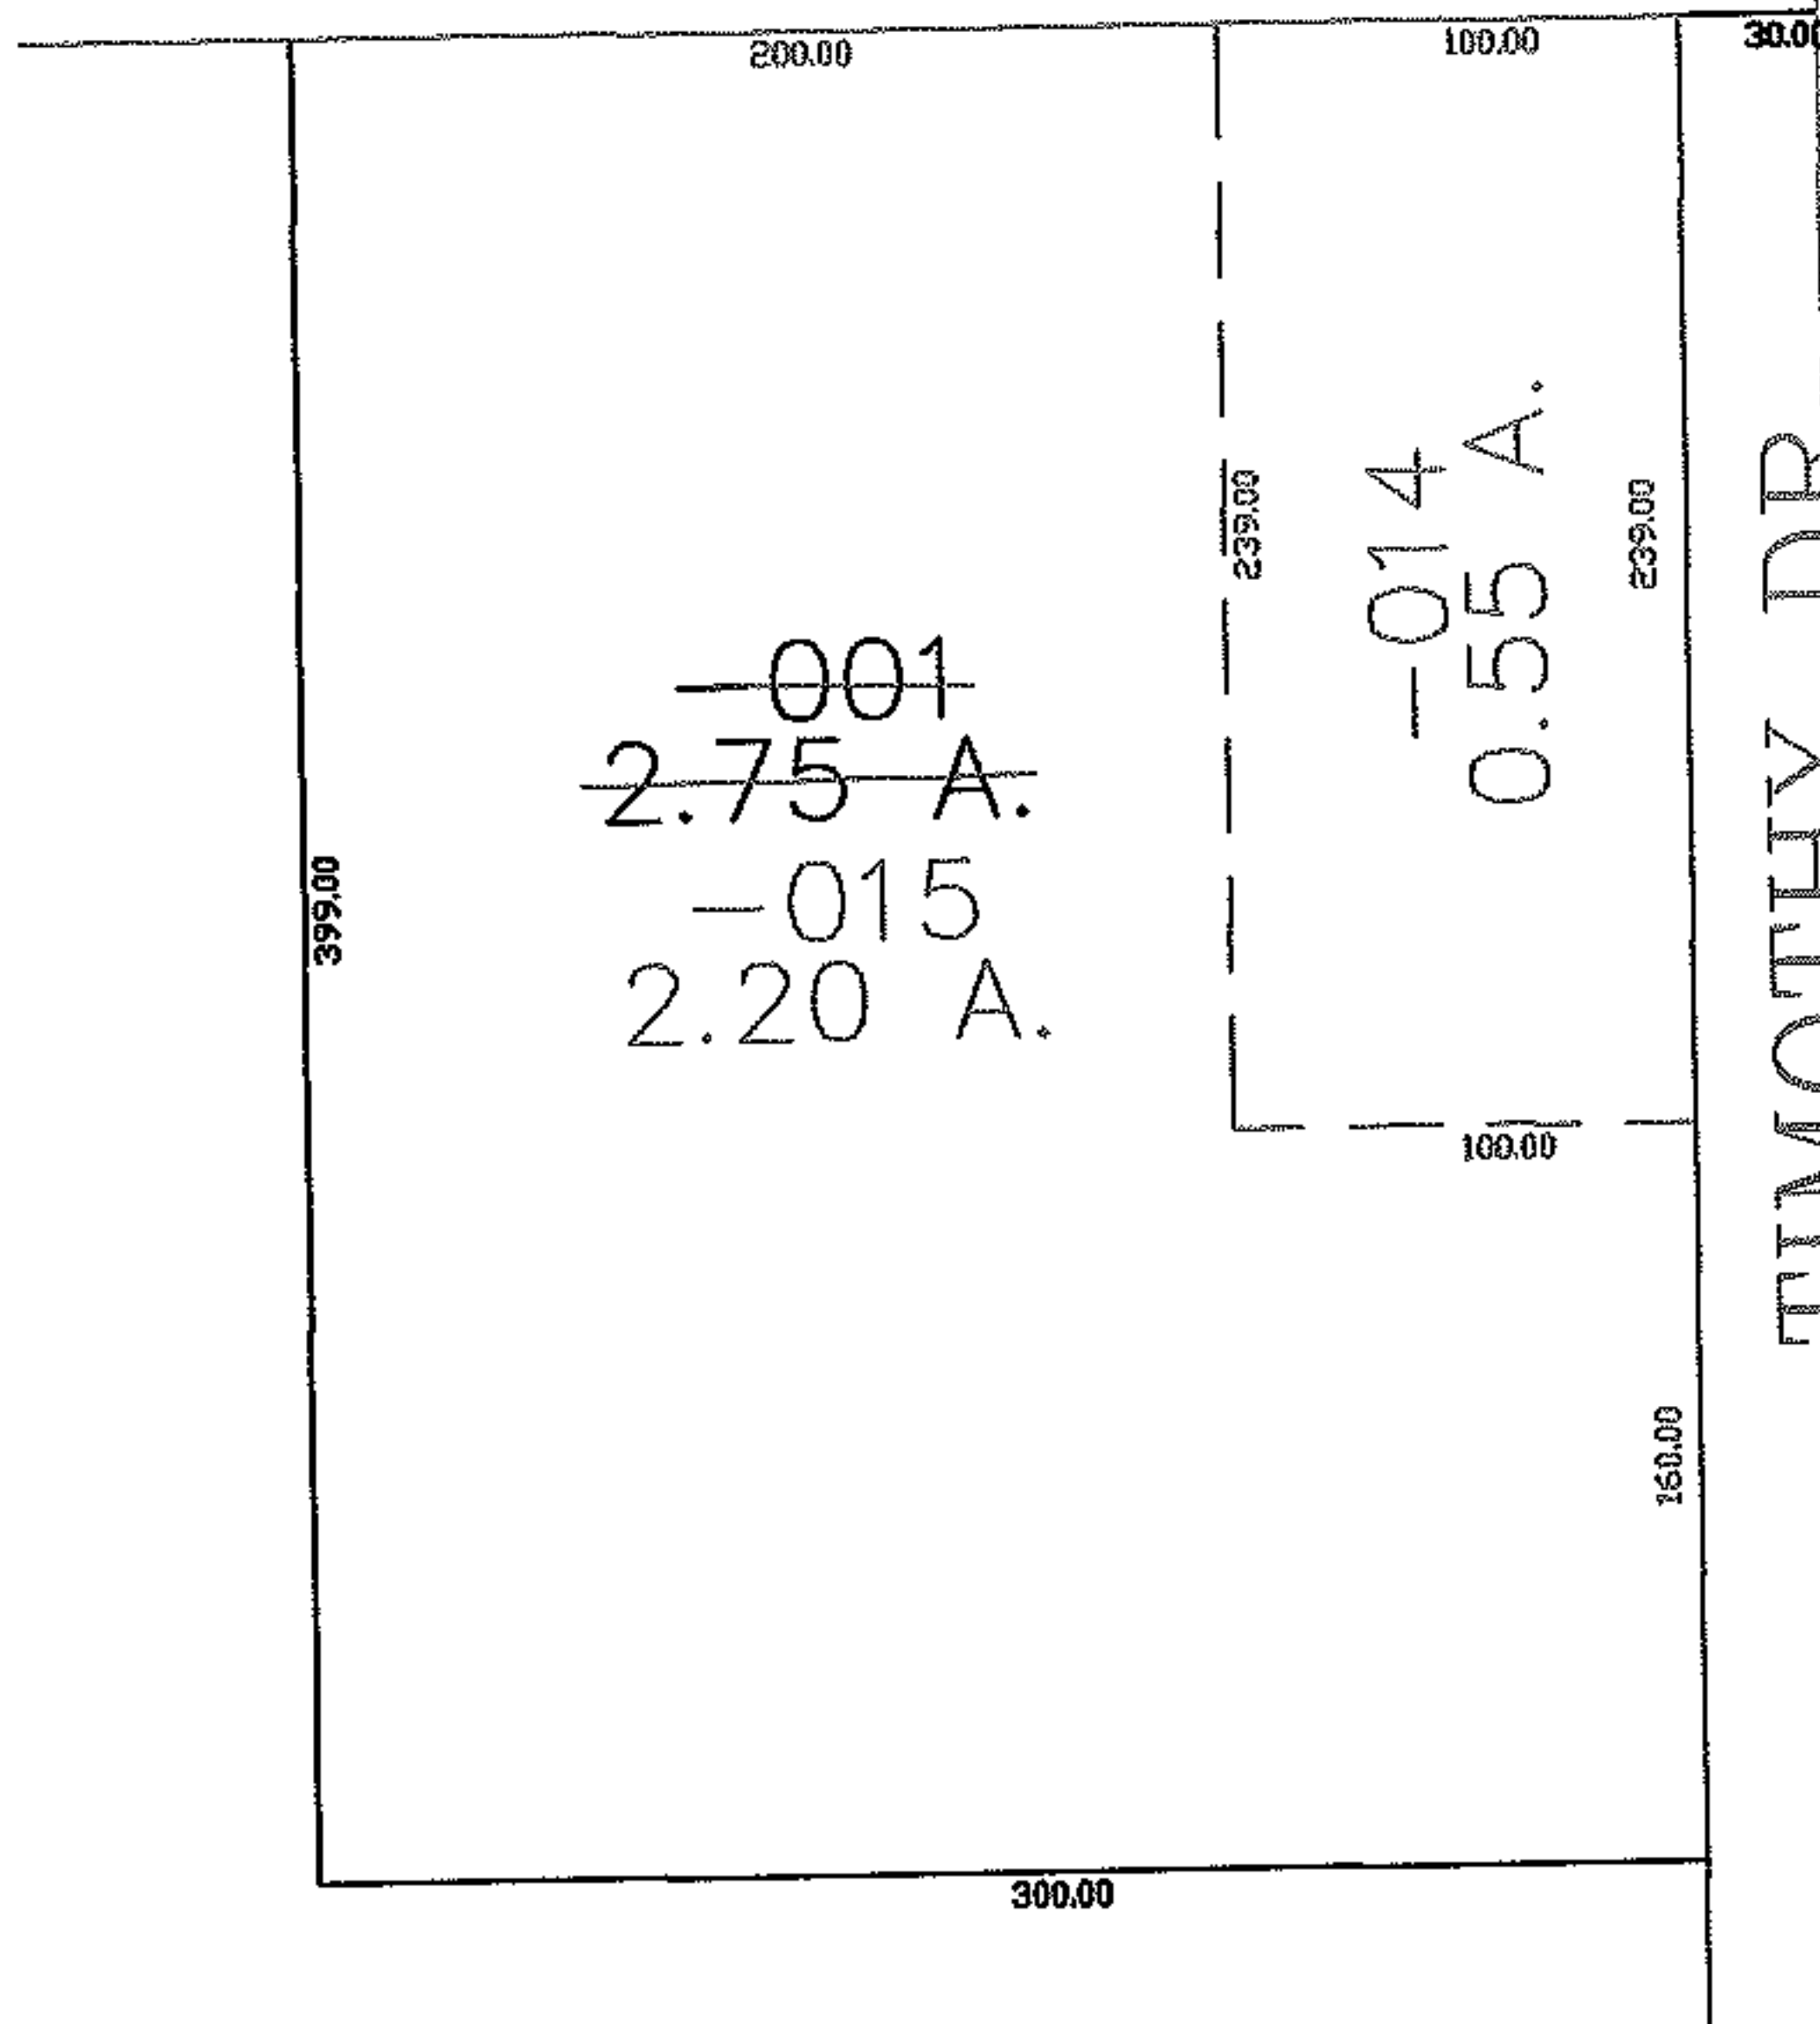

SPLITS/DEEDS PROCESSED

LORAIN COUNTY TAX MAP DEPARTMENT
226 MIDDLE AVE. ELYRIA, OHIO

SURVEYED BY: DANE HAPONER

CLOSURE: 0.00 : 10.000

MAP PAGE(S): 07-00-015-B

APPROVED BY: JAH DATE: 4-20-07

SCALE: 1" = 100 PRIOR INSTRUMENT: 2004040570