

PARENT PARCEL: 01-00-010-000-006
 CHILD PARCEL: XX-XX-XXX-XXX-XXX
 STARTING POINT: CL OF LAKE RD. & CL OF BAUMHART RD.

11-02363-A



ACREAGE CORRECTION

01-00-010-000-006

~~18.50 A.~~

18.55 A.

AC. CORR. PER DEED
 INST. 20000685286

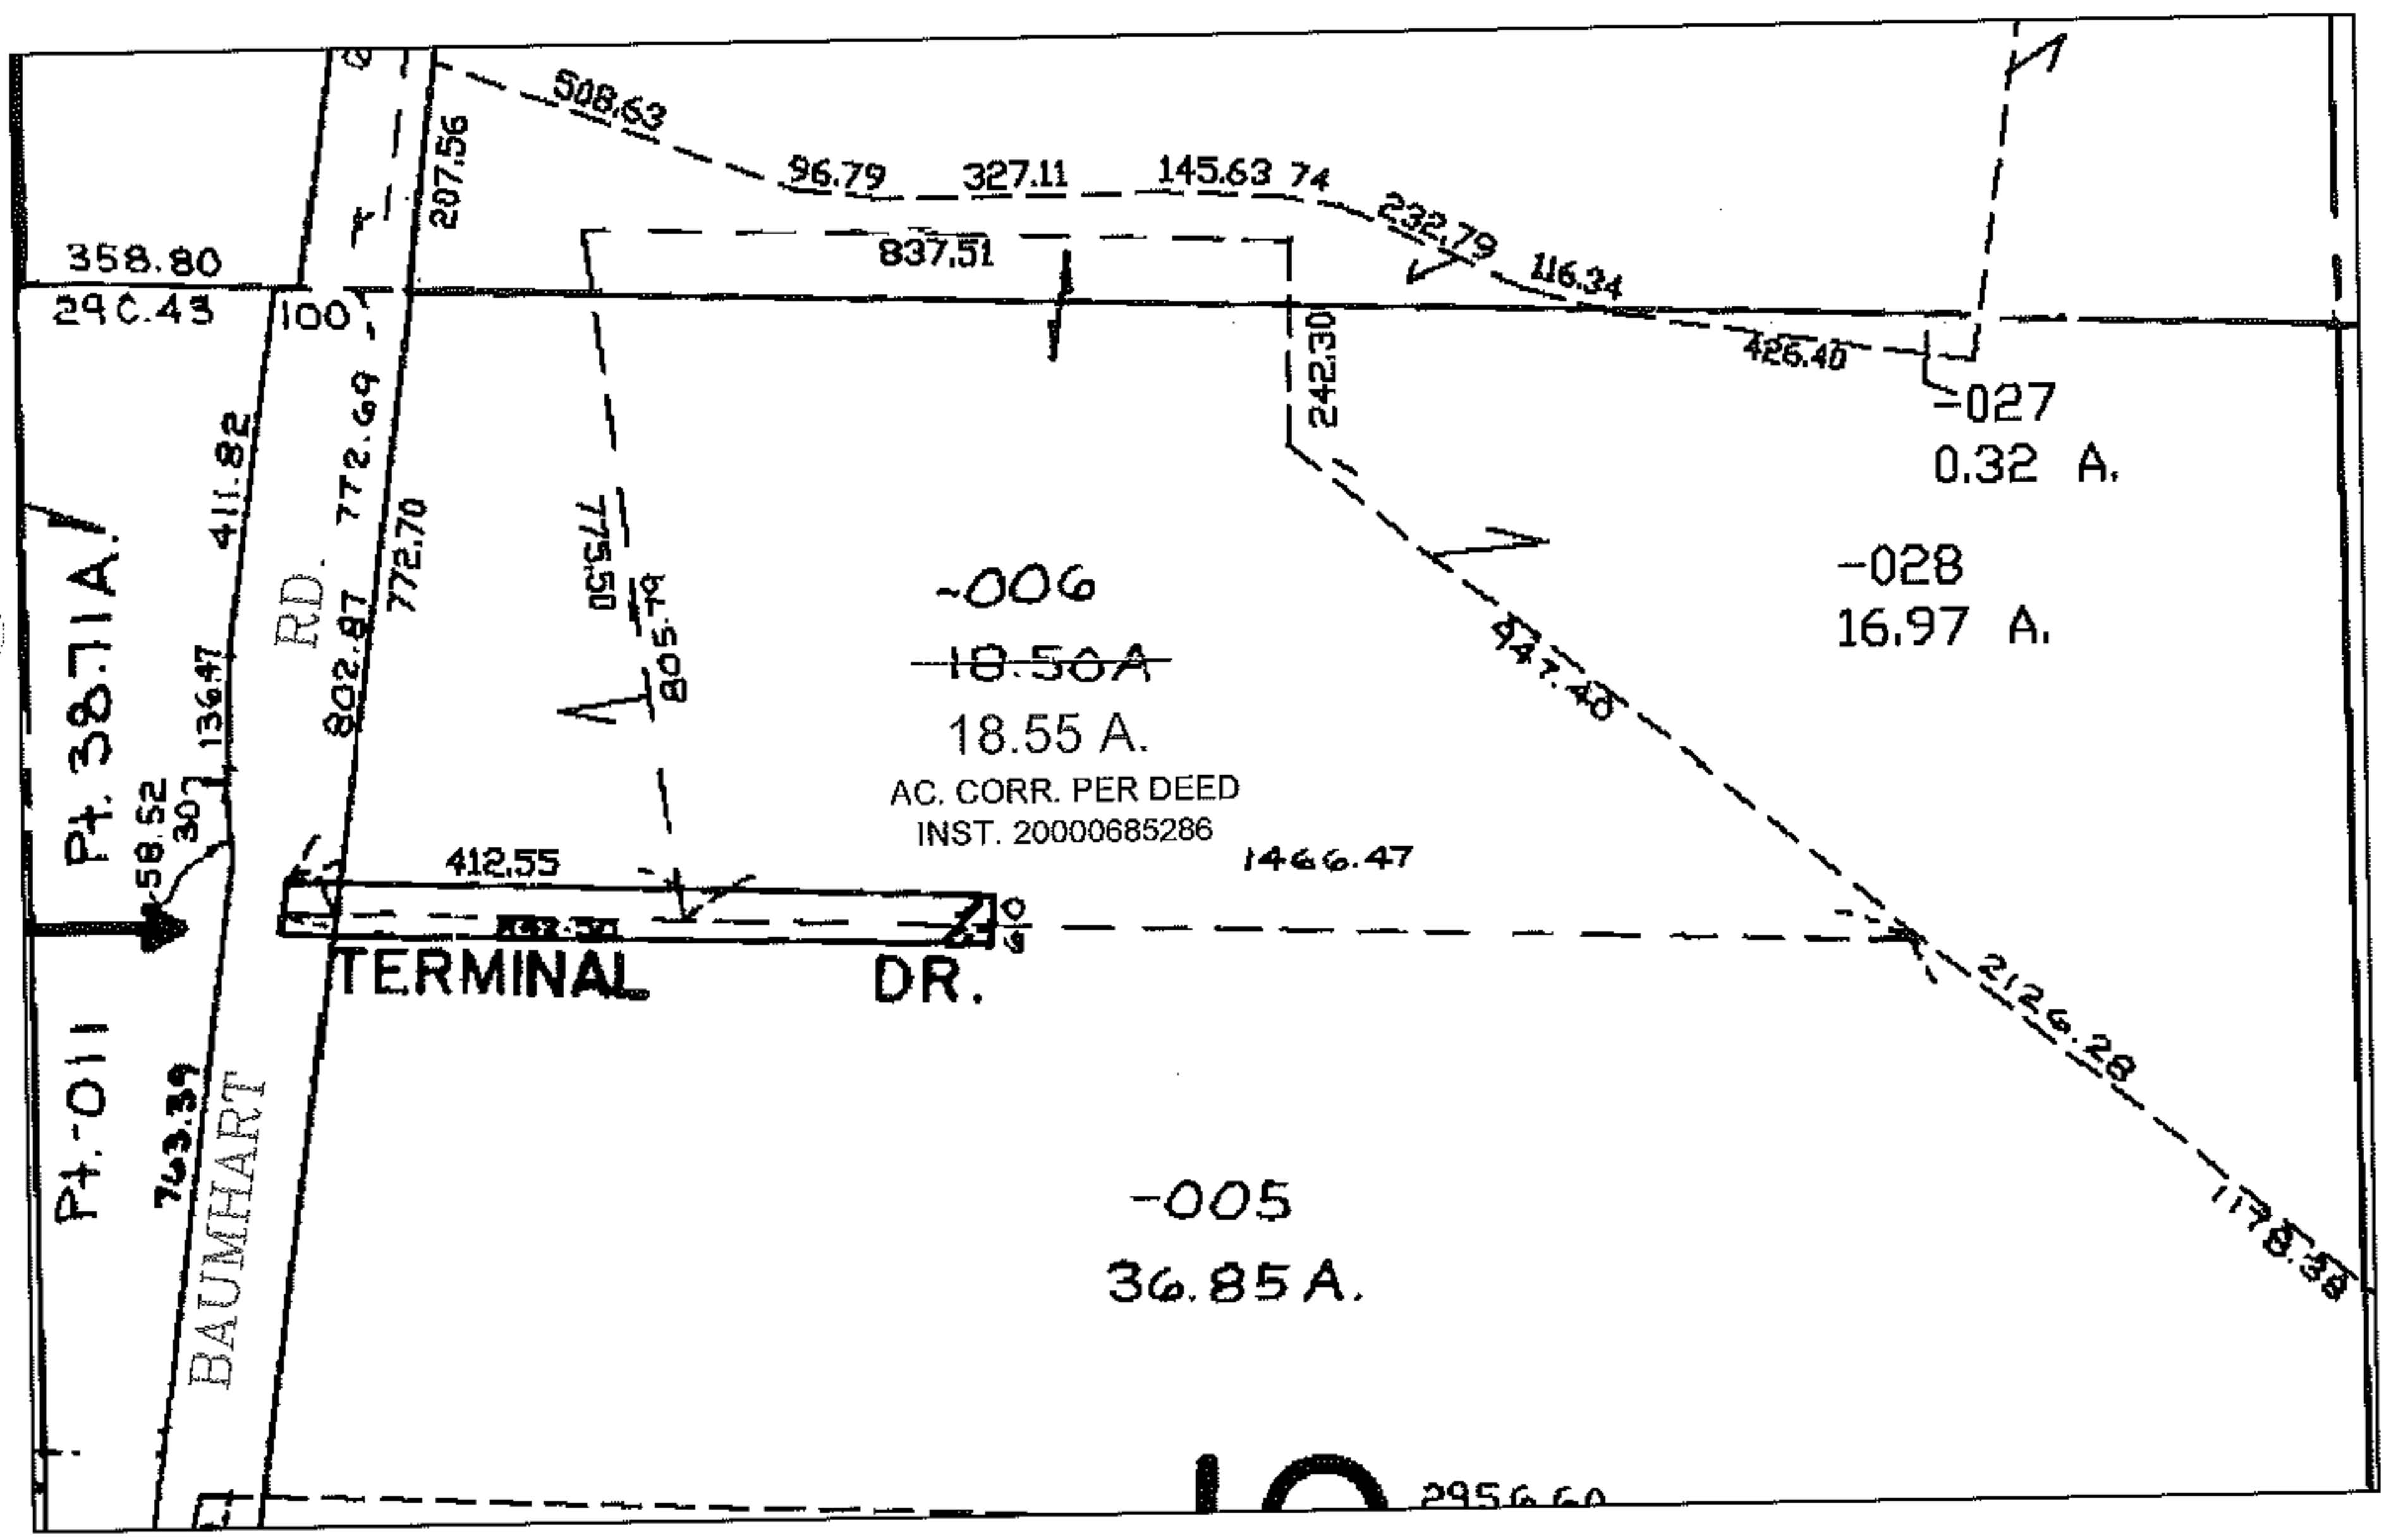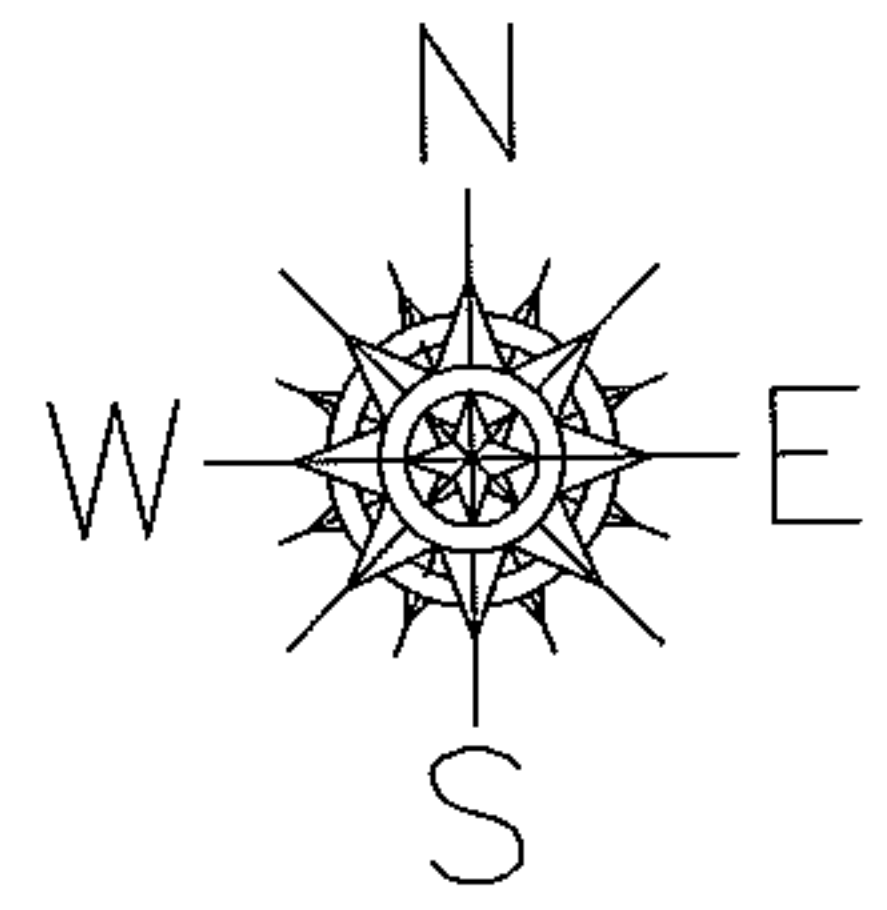

SPLITS/DEEDS PROCESSED
 LORAIN COUNTY TAX MAP DEPARTMENT
 226 MIDDLE AVE. ELYRIA, OHIO

SURVEYED BY: XXXXXXXXXX
 CLOSURE: 0.01: 10.000
 MAP PAGE(S): 1-D
 APPROVED BY: TJS DATE: 10/14/11
 SCALE: 1"= 400 PRIOR INST.: 20000685286