
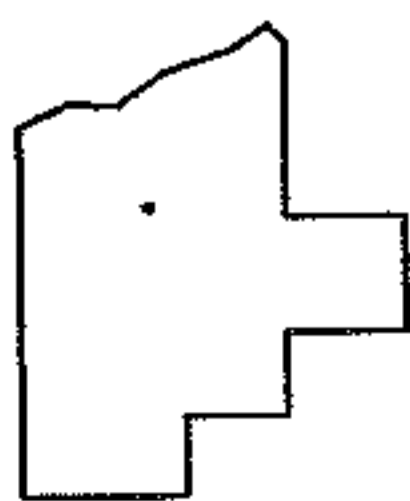
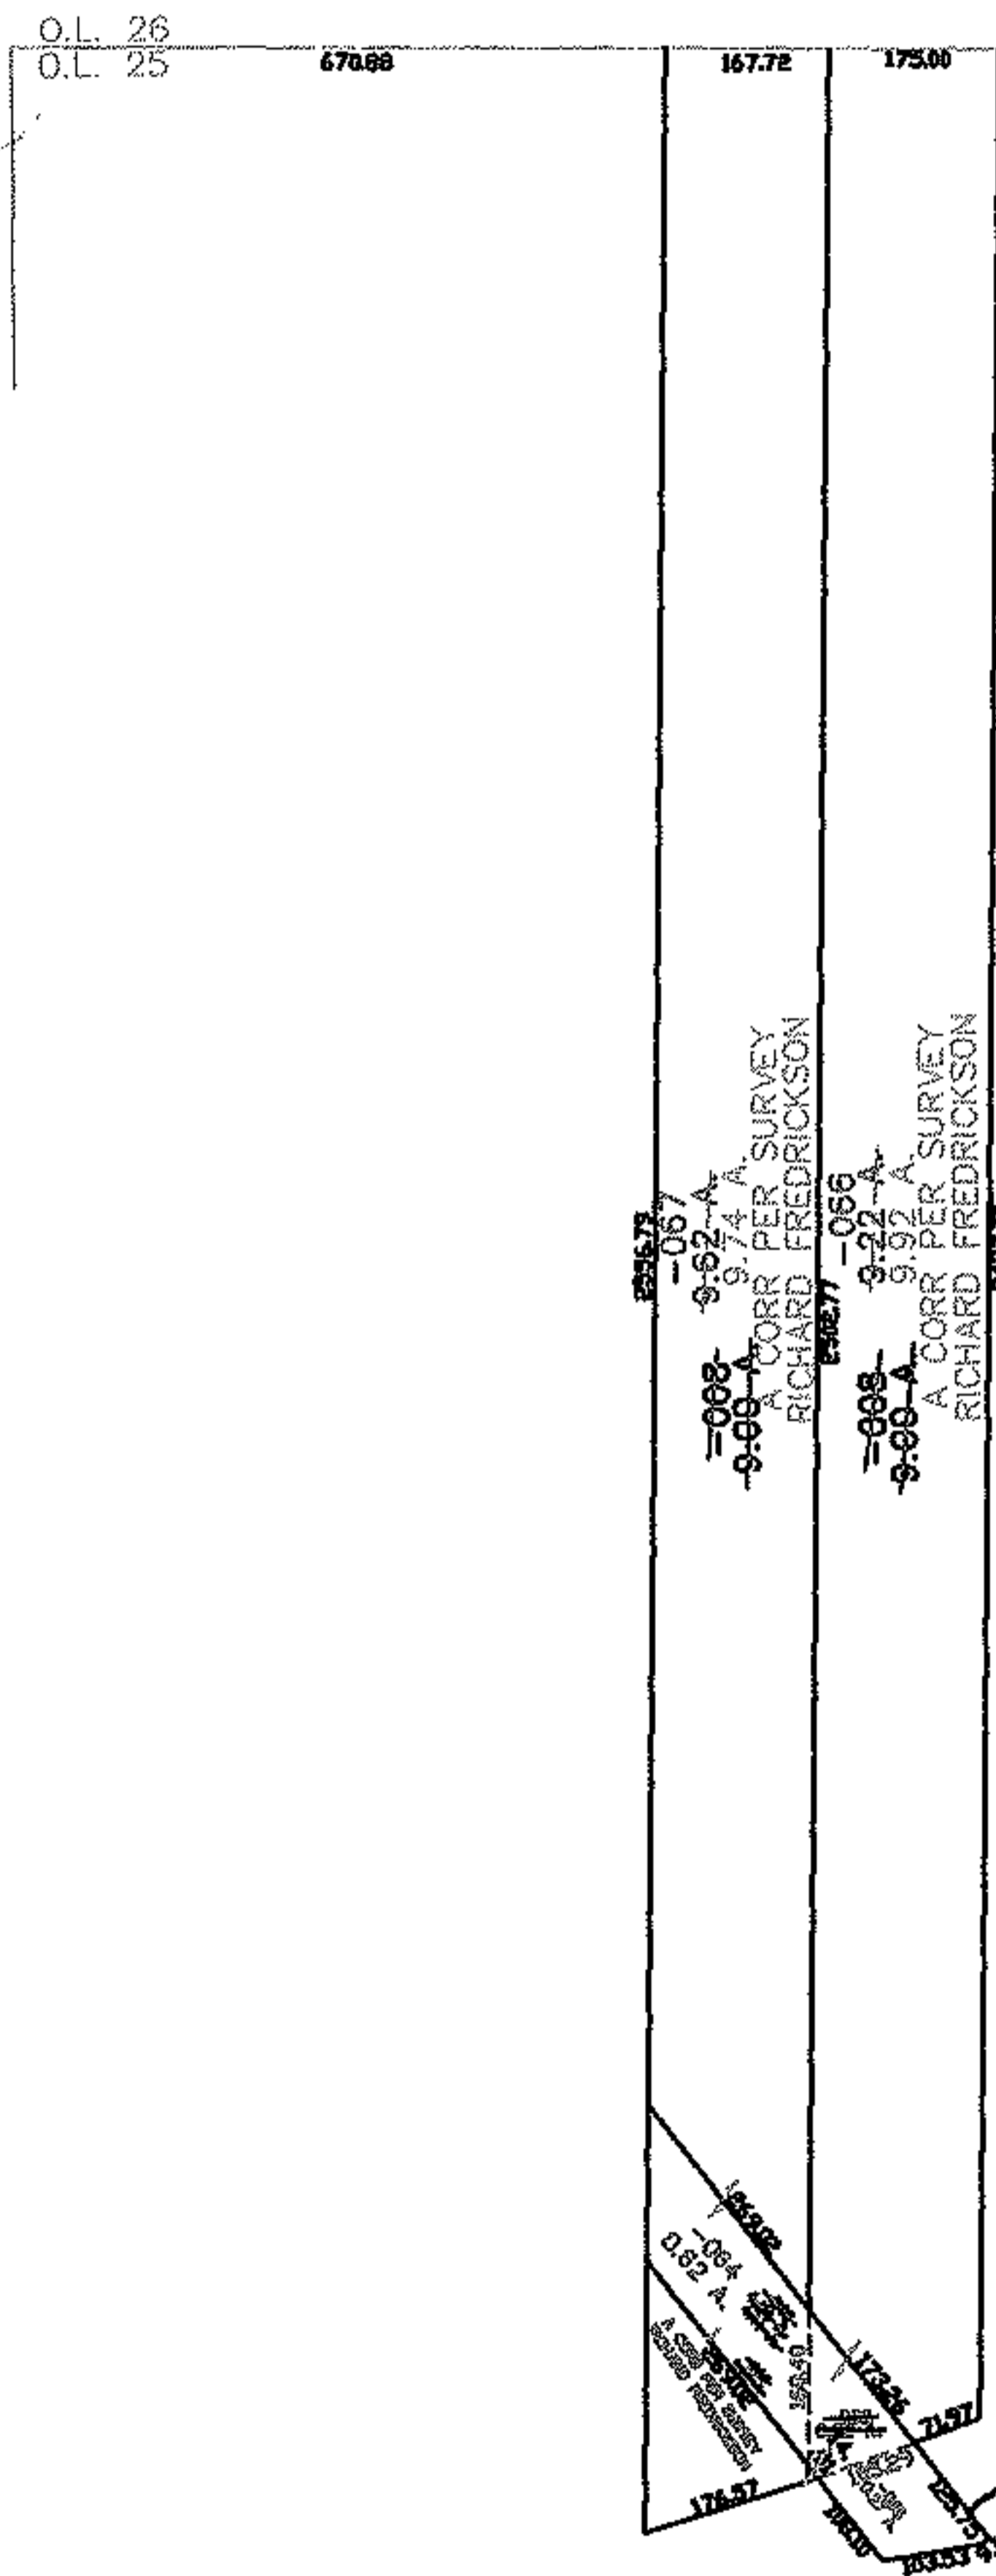


PARENT PARCEL: 03-00-025-000-049, -007, -008

CHILD PARCEL: 03-00-025-000-062 THRU -067

STARTING POINT: NORTHWEST CORNER OF O.L. 25 & 26

07-02363

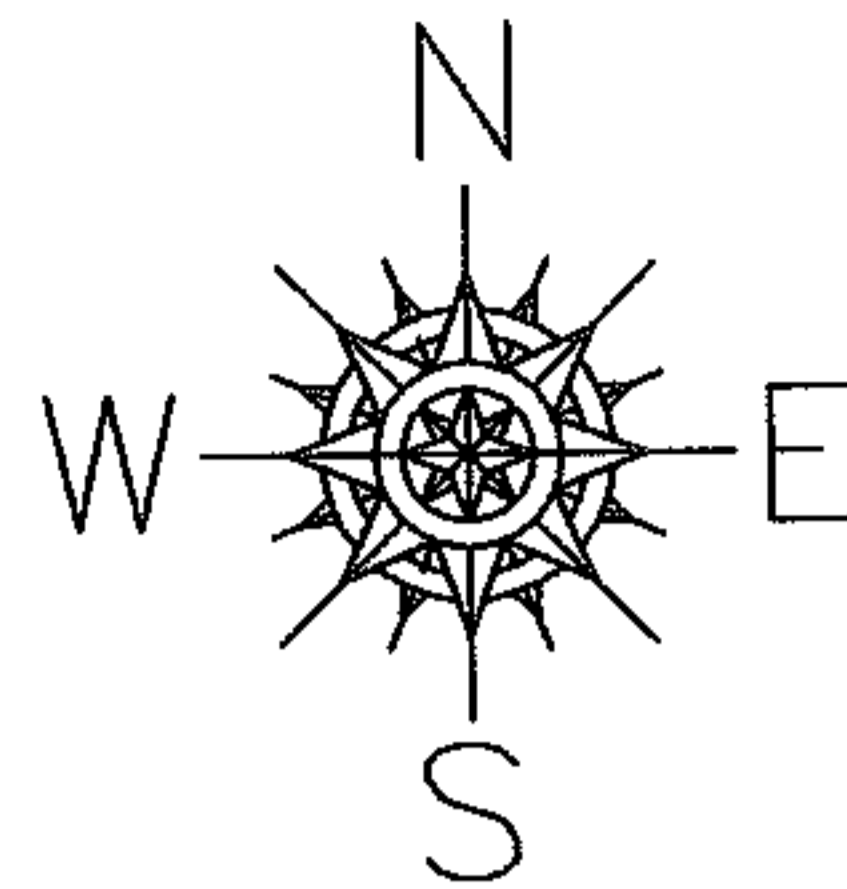

SPLITS/DEEDS PROCESSED

LORAIN COUNTY TAX MAP DEPARTMENT
226 MIDDLE AVE. ELYRIA, OHIO

SURVEYED BY: RICHARD FREDRICKSON

CLOSURE: 0.00 : 10.000

MAP PAGE(S): 03-00-025-A

APPROVED BY: JAH DATE: 4-25-07

SCALE: 1" = 100 PRIOR INSTRUMENT: 20060137690