
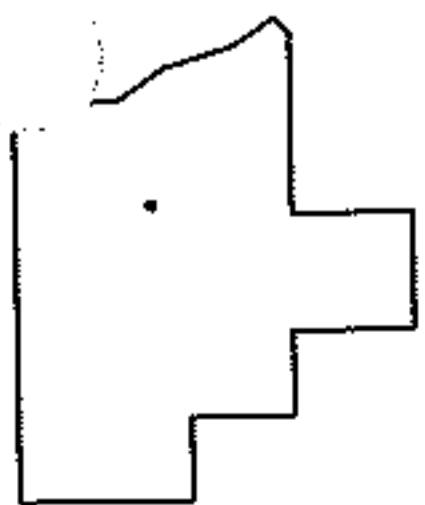
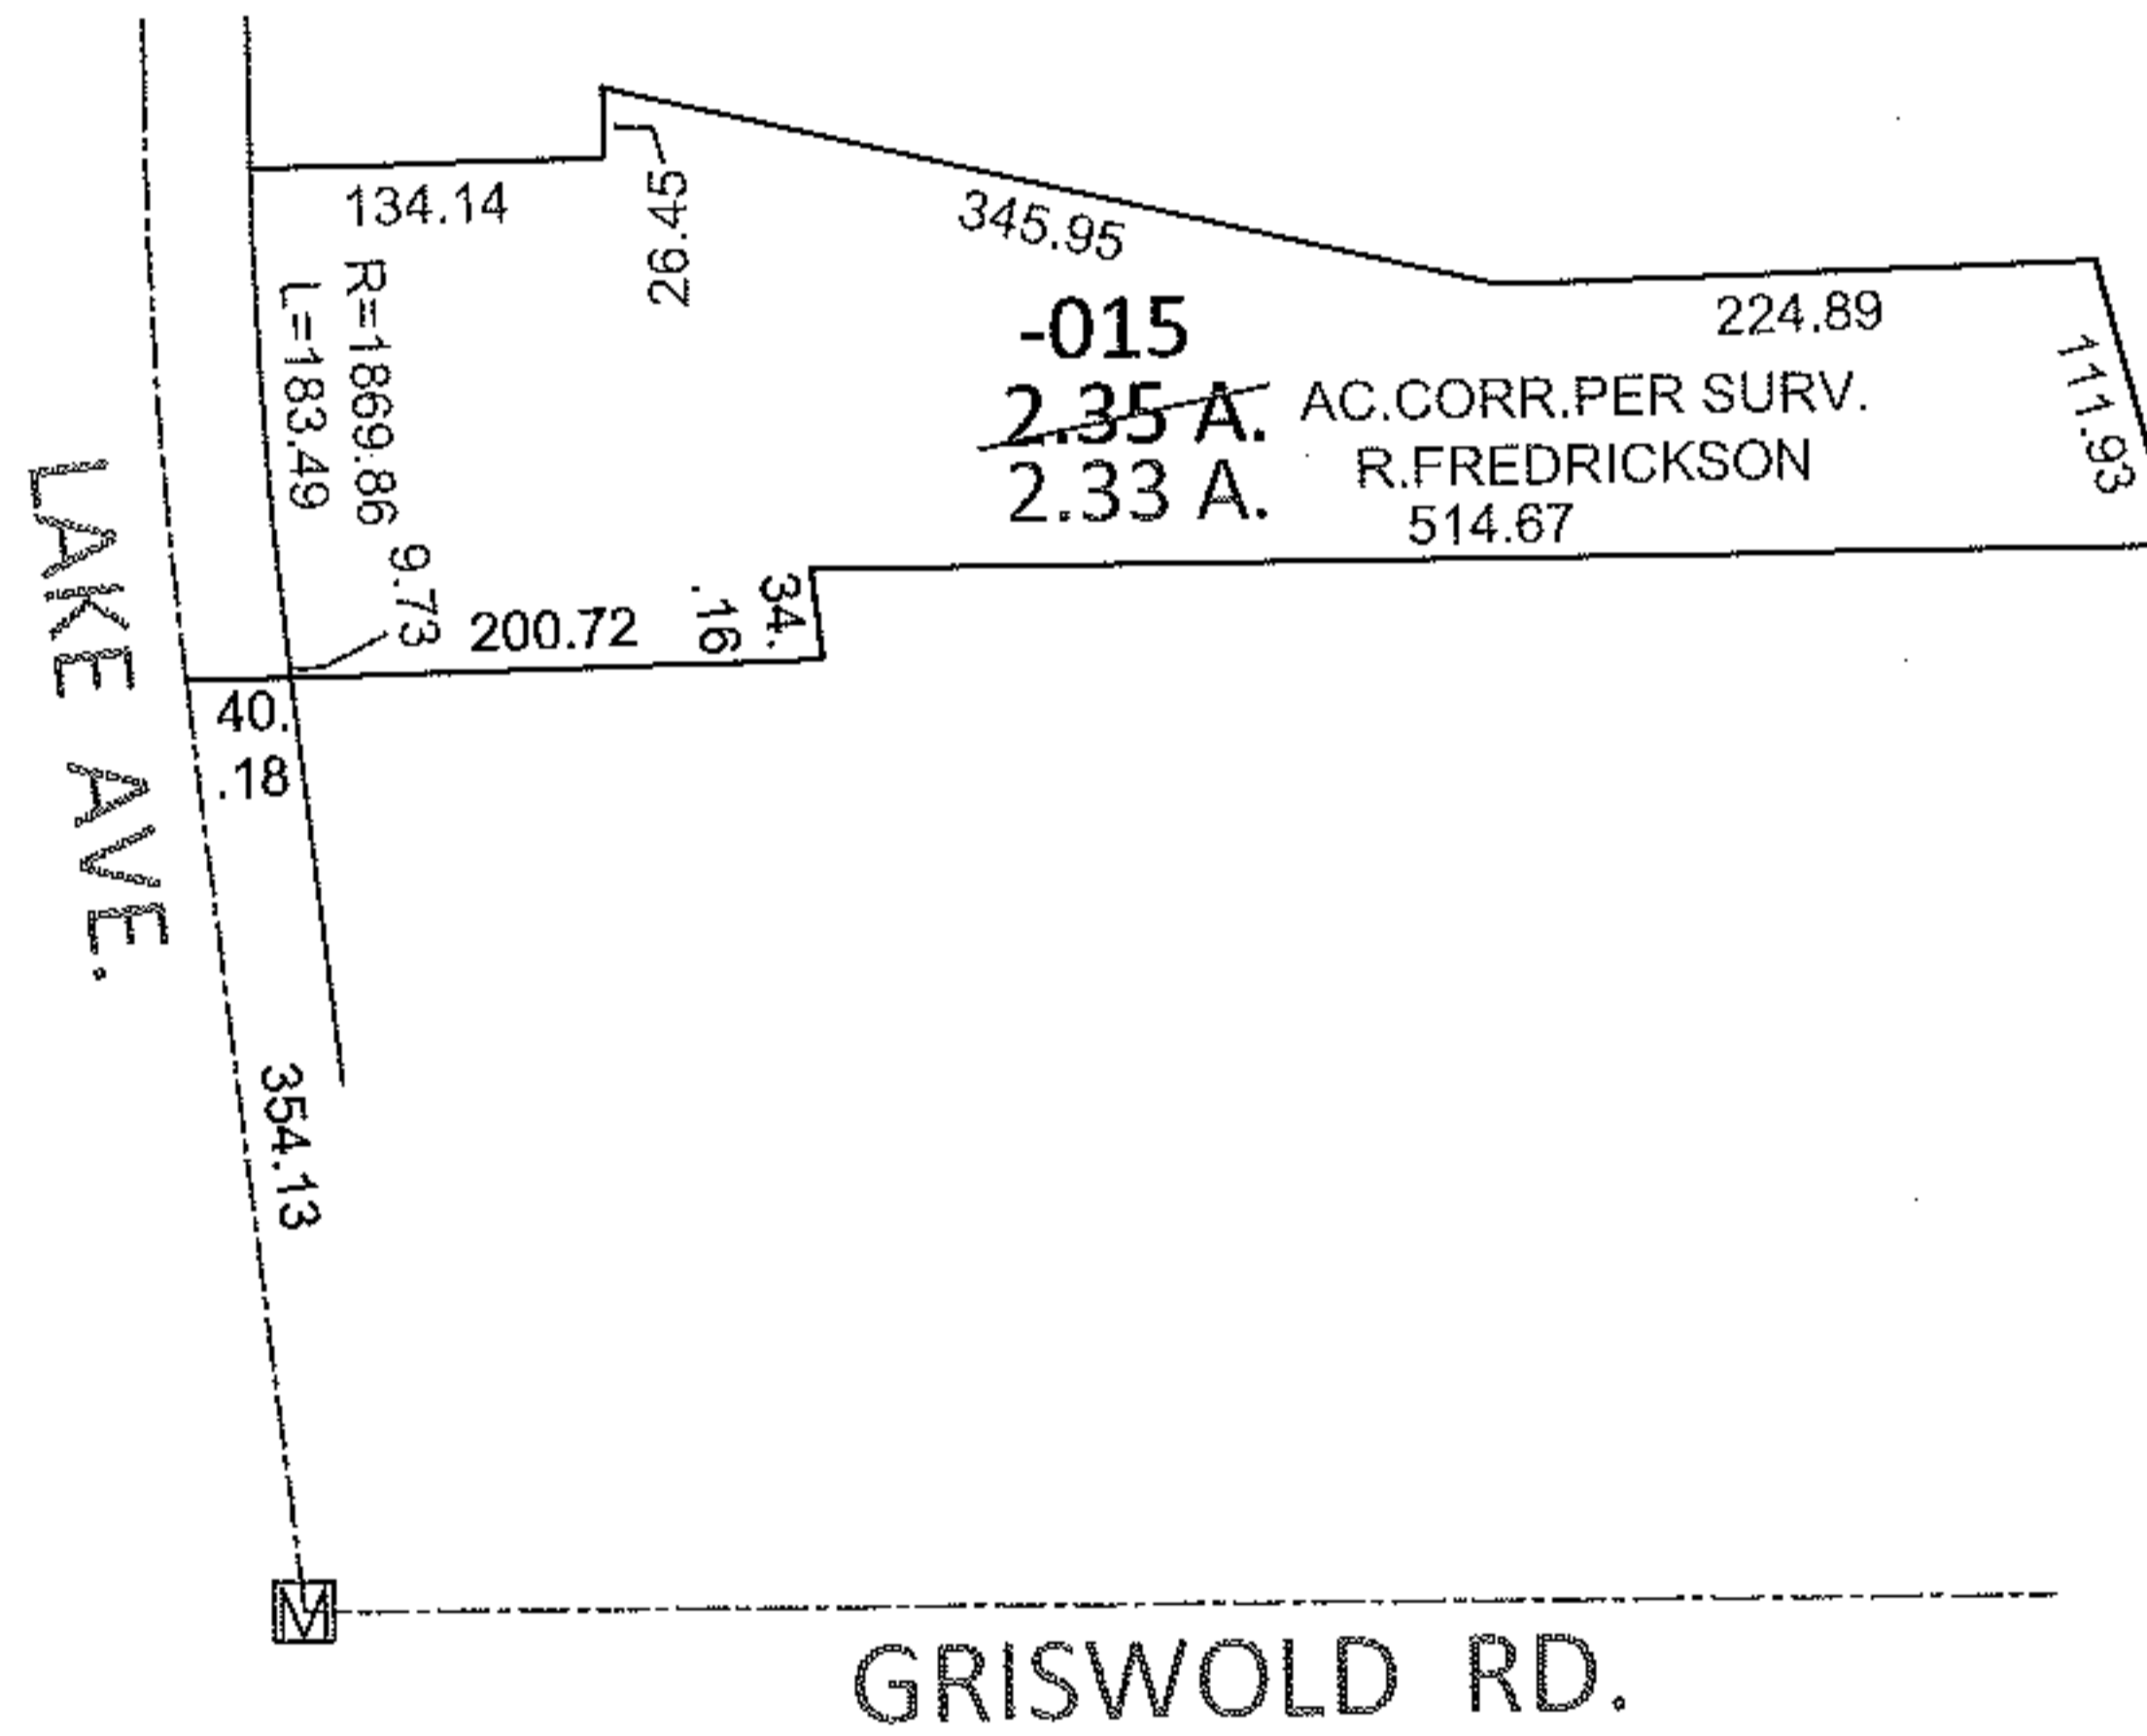


PARENT PARCEL: 06-23-011-102-015

11-02364-A

CHILD PARCEL: _____

STARTING POINT: AT A MON BOX AT THE INTERSECTION OF C/L OF GRISWOLD RD. AND C/L OF LAKE AVE.

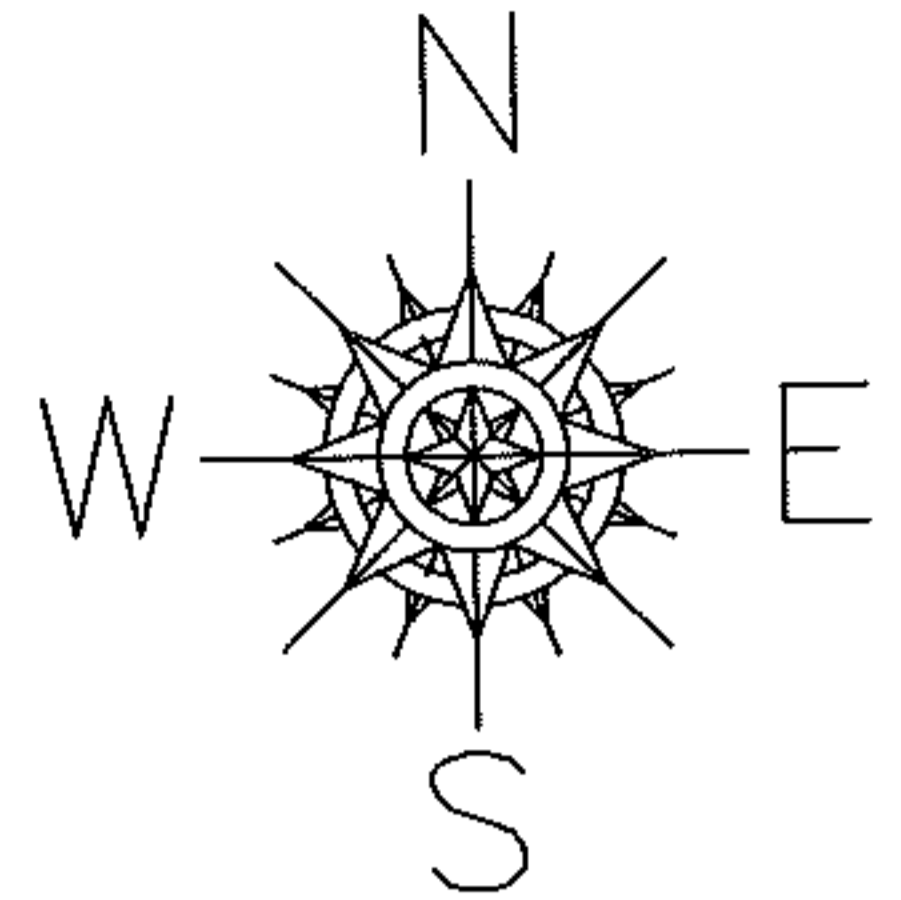

SPLITS/DEEDS PROCESSED

LORAIN COUNTY TAX MAP DEPARTMENT
226 MIDDLE AVE. ELYRIA, OHIO

SURVEYED BY: RICHARD A. FREDRICKSON

CLOSURE: .01:10,000

MAP PAGE(S): 6-43

APPROVED BY: RRM DATE: 10-6-11

SCALE: 1"= 200 PRIOR INST.: 19998242078