


PARENT PARCEL: 18-00-030-000-033

CHILD PARCEL: XX-XX-XXX-XXX-XXX

STARTING POINT: CL OF ASHLAND-OBERLIN RD. (S.R. 58) & CL OF PECK WADSWORTH RD.

11-02365-A

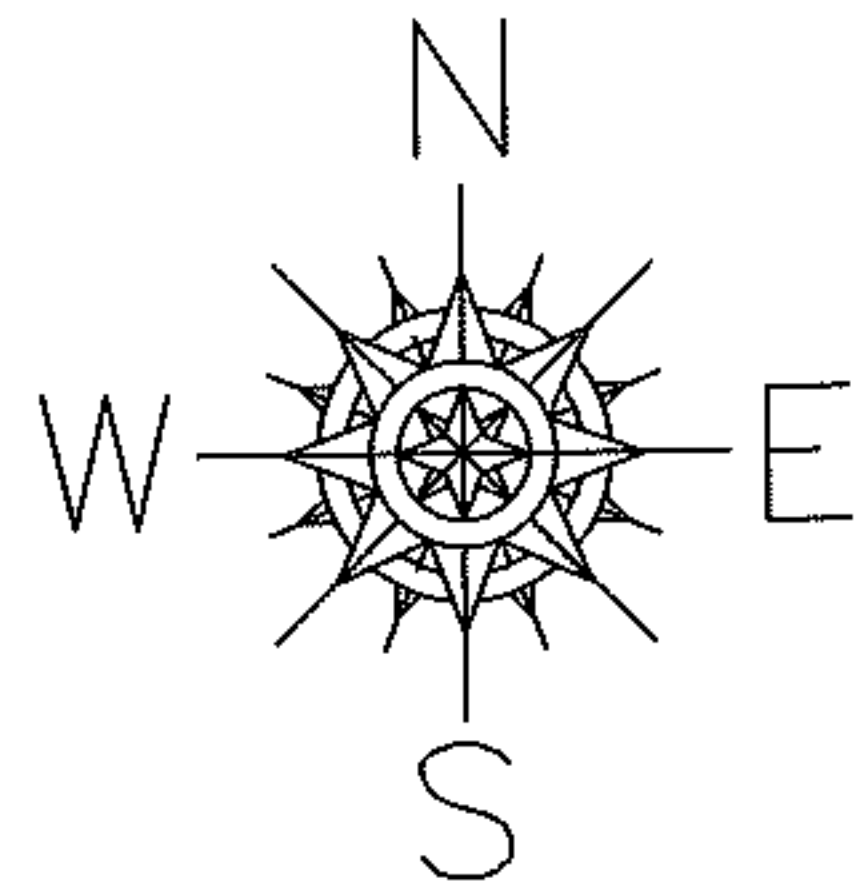


ACREAGE CORRECTION

18-00-030-000-033

~~1.73 A.~~

1.61 A.

CORR. PER SURV.
JAMES P. YURKSCHATT

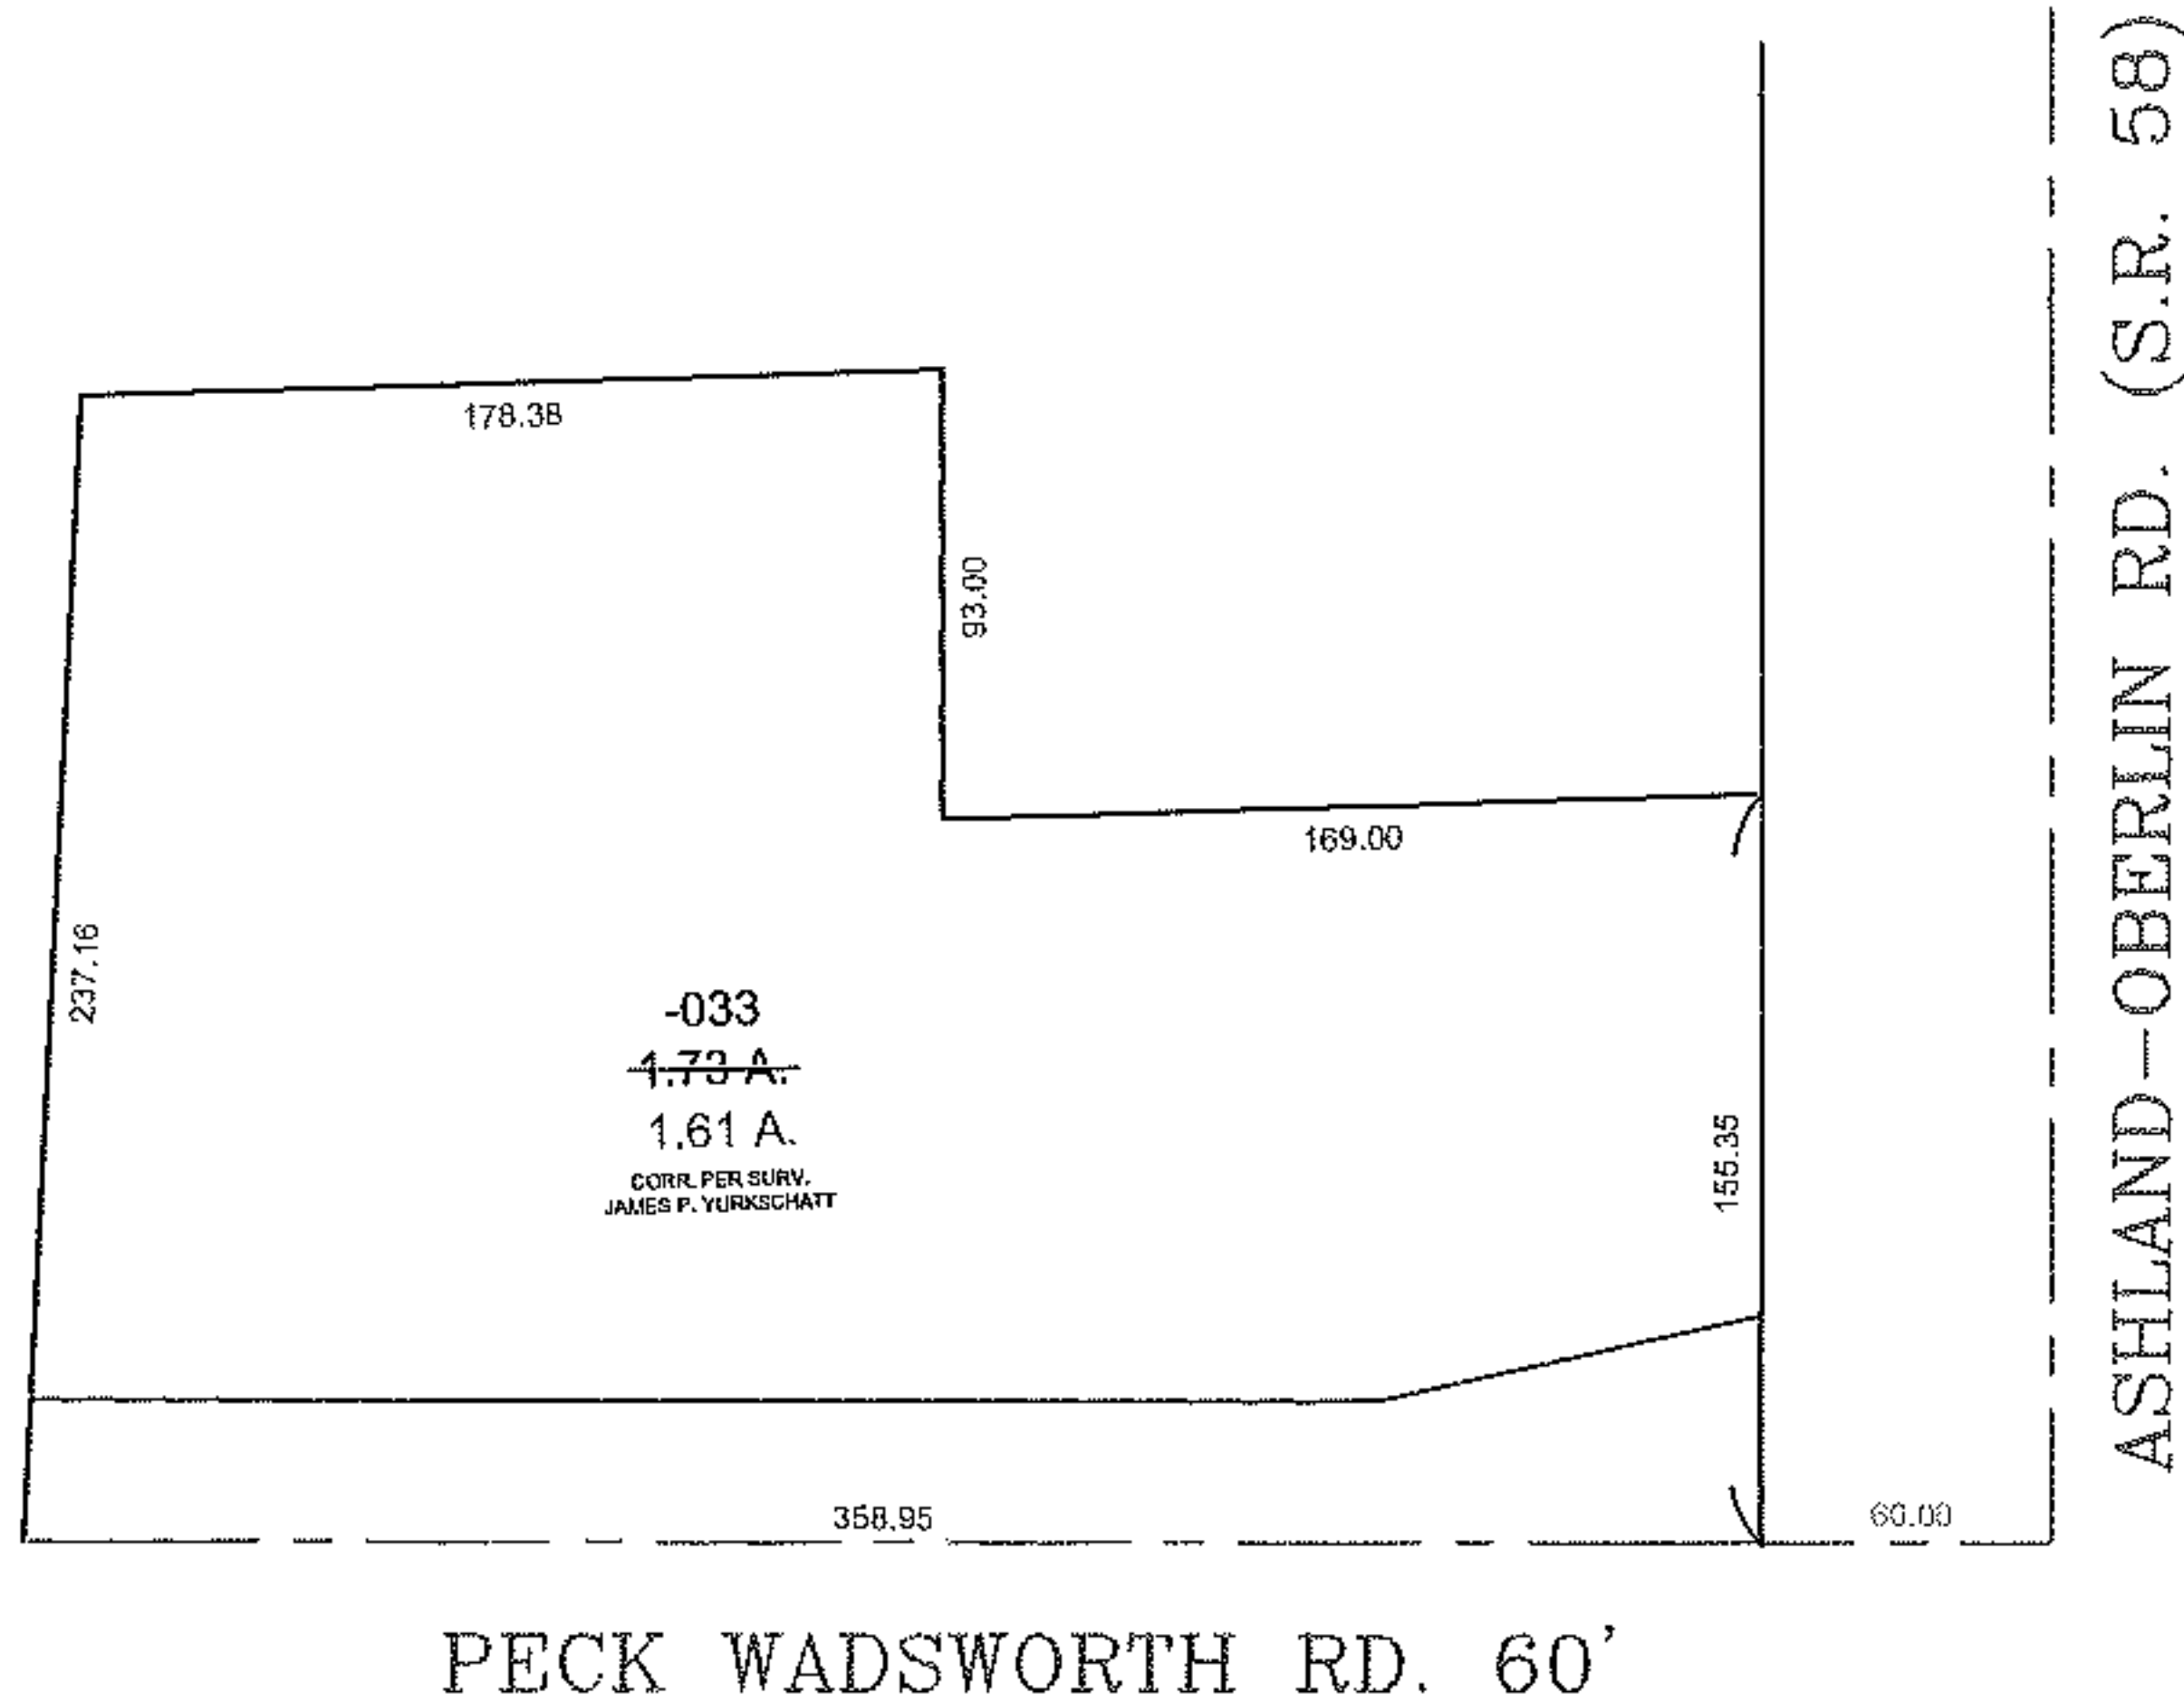

PECK WADSWORTH RD. 60'

ASHLAND-OBERLIN RD. (S.R. 58)

SPLITS/DEEDS PROCESSED

LORAIN COUNTY TAX MAP DEPARTMENT
226 MIDDLE AVE. ELYRIA, OHIO

SURVEYED BY: JAMES P. YURKSCHATT

CLOSURE: 0.01 : 10,000

MAP PAGE(S): 18-00-030-D

APPROVED BY: TJS DATE: 10/13/11

SCALE: 1"= 100 PRIOR INST.: 20110385849