
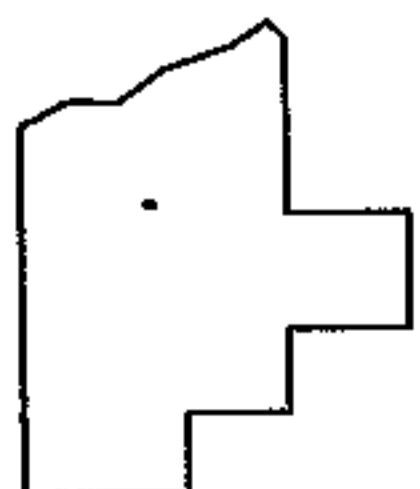
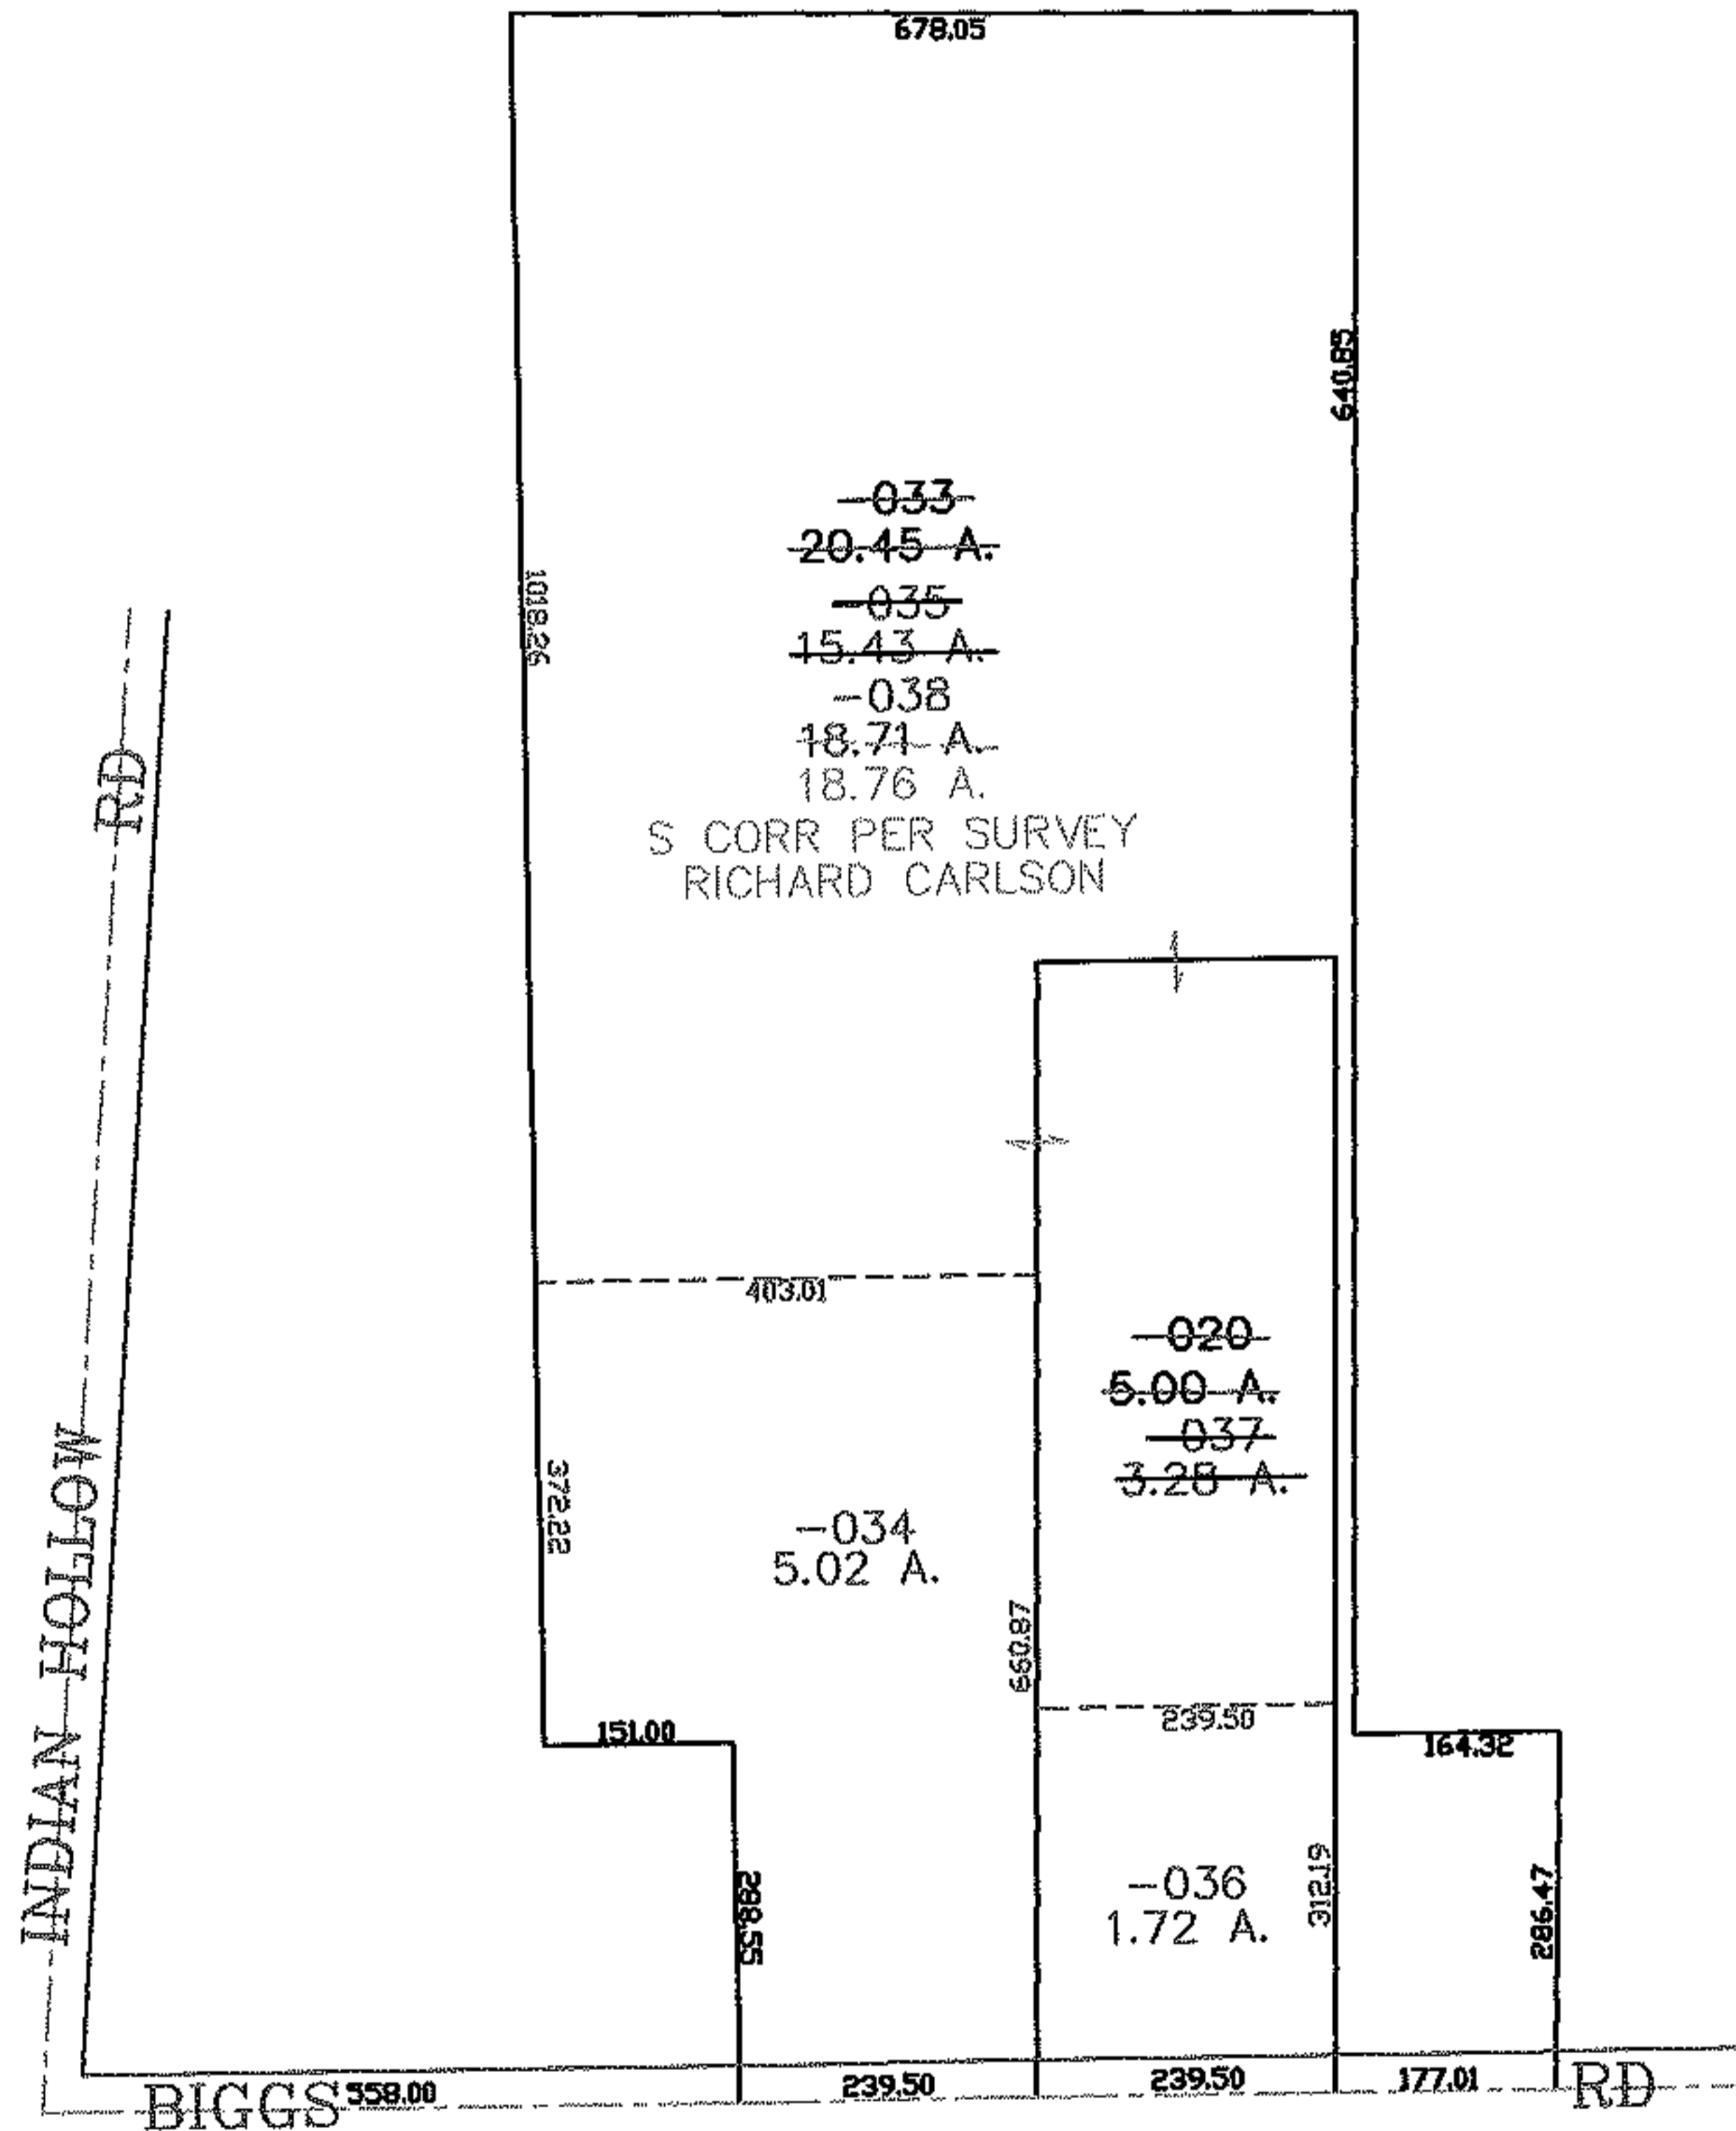


PARENT PARCEL: 15-00-030-000-033, -020

CHILD PARCEL: 15-00-030-000-034 THRU -038

STARTING POINT: CENTERLING OF BIGGS RD & INDIAN HOLLOW RD.

07-02365

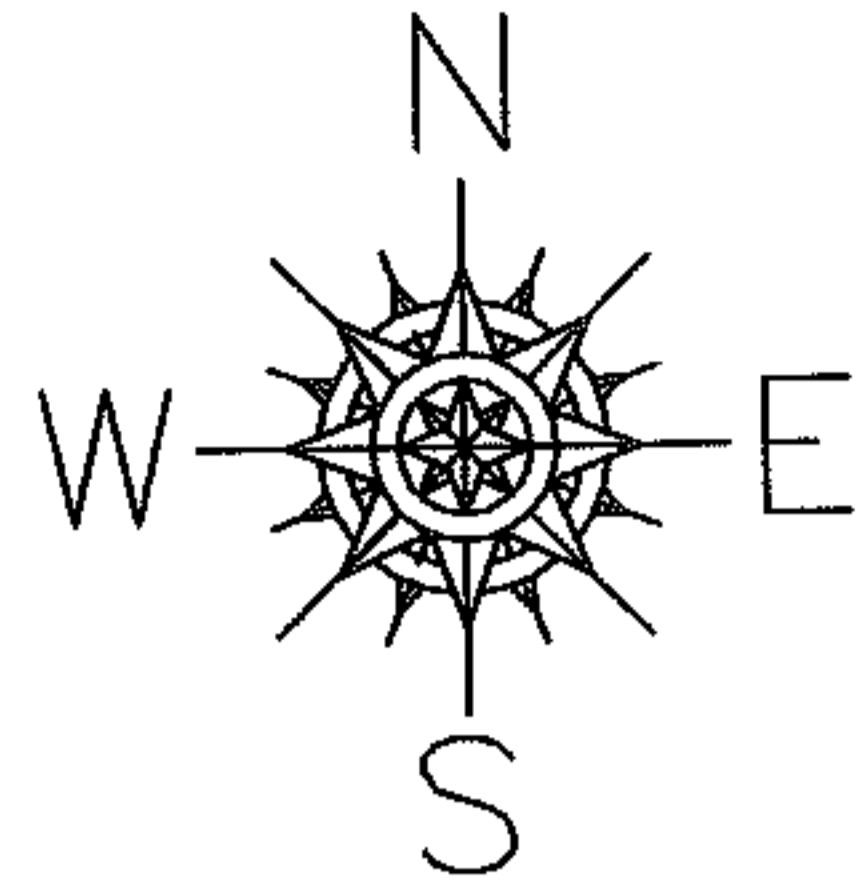

**SPLITS/DEEDS PROCESSED**

LORAIN COUNTY TAX MAP DEPARTMENT  
226 MIDDLE AVE. ELYRIA, OHIO

SURVEYED BY: RICHARD CARLSON

CLOSURE: 0.00 : 10.000

MAP PAGE(S): 15-00-030-A

APPROVED BY: JAH DATE: 5-1-07

SCALE: 1" = 300 PRIOR INSTRUMENT: DV 1203/248