
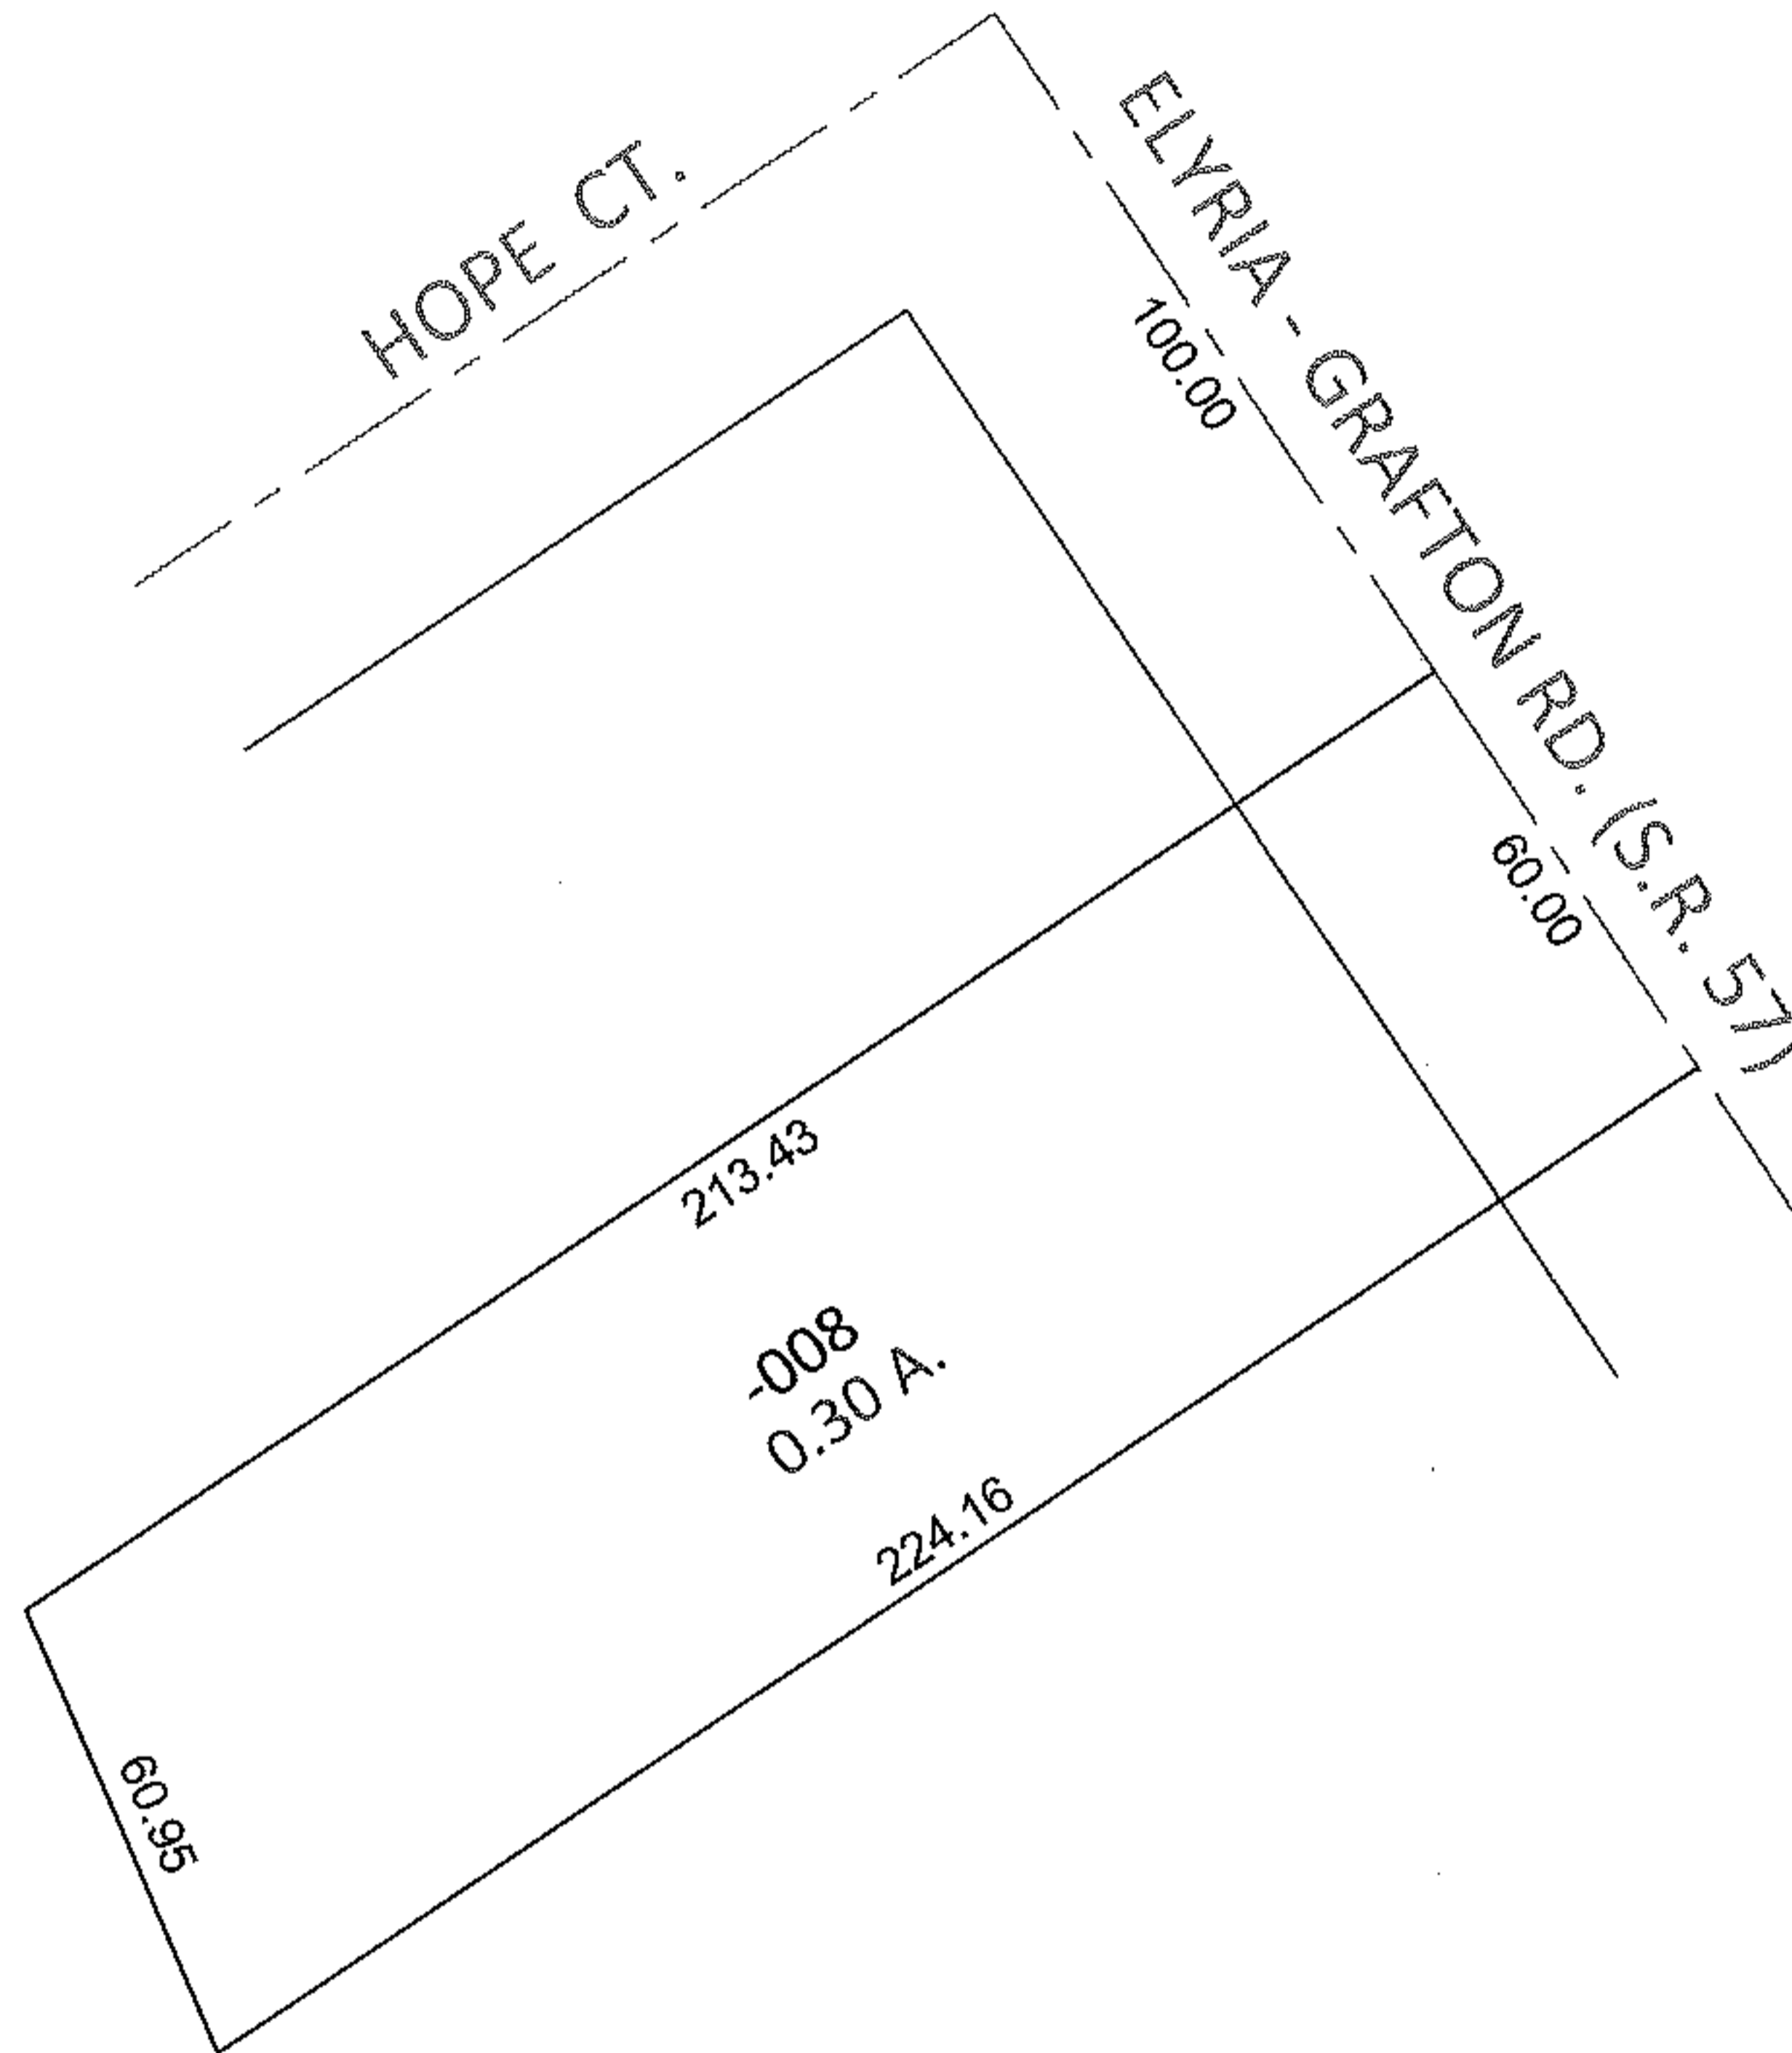


PARENT PARCEL: 10-00-004-126-008

CHILD PARCEL: _____

STARTING POINT: INTERSECTION OF C/L OF HOPE CT. AND C/L OF S.R.57

11-02366-A

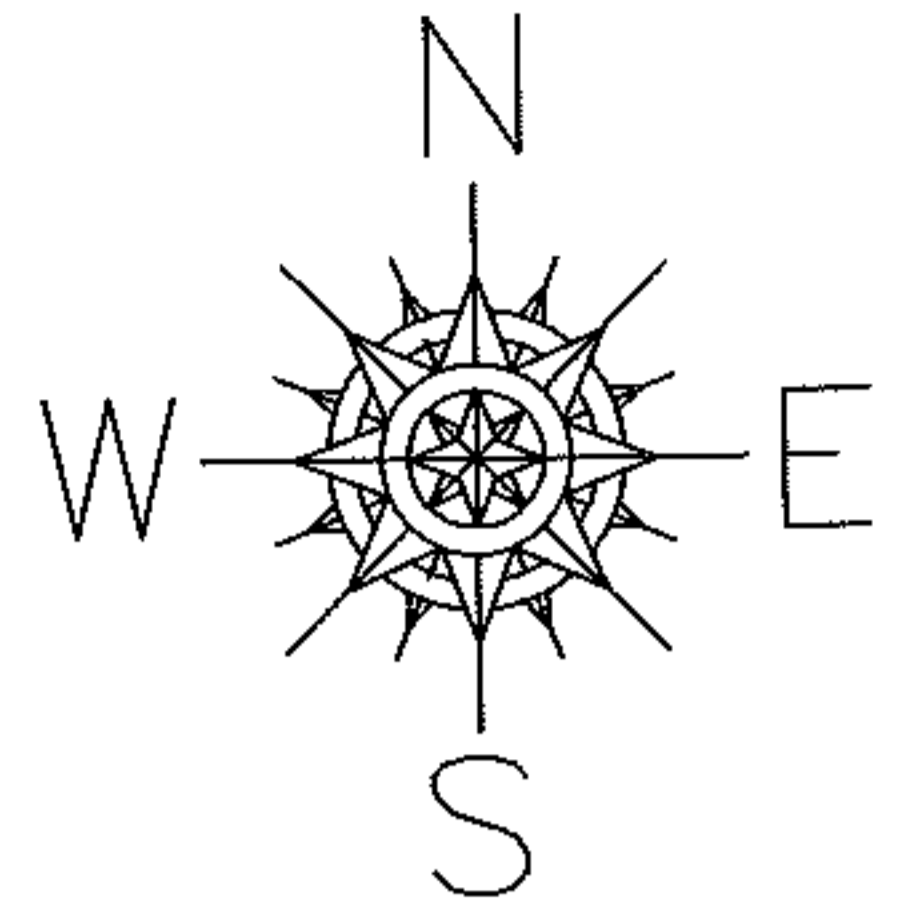

FRONTAGE AND DEPTH TO ACREAGE CORRECTION

10-00-004-126-008

0.30 A.

~~60 X 213~~

PER SURV. J. YURKSCHATT



SPLITS/DEEDS PROCESSED

LORAIN COUNTY TAX MAP DEPARTMENT
226 MIDDLE AVE. ELYRIA, OHIO

SURVEYED BY: JAMES P. YURKSCHATT

CLOSURE: .01:10,000

MAP PAGE(S): 10-00-004-H

APPROVED BY: RRM DATE: 10-13-11

SCALE: 1"= 50' PRIOR INST.: 20110380777