
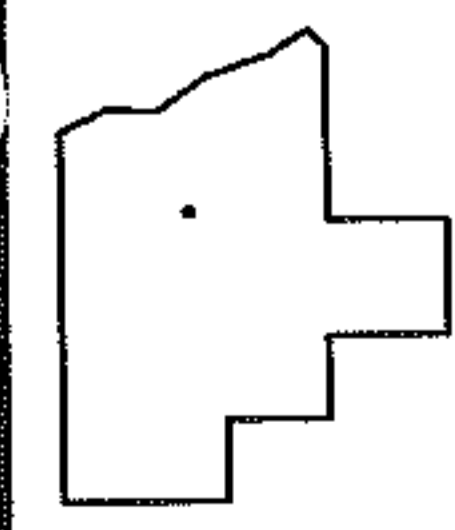
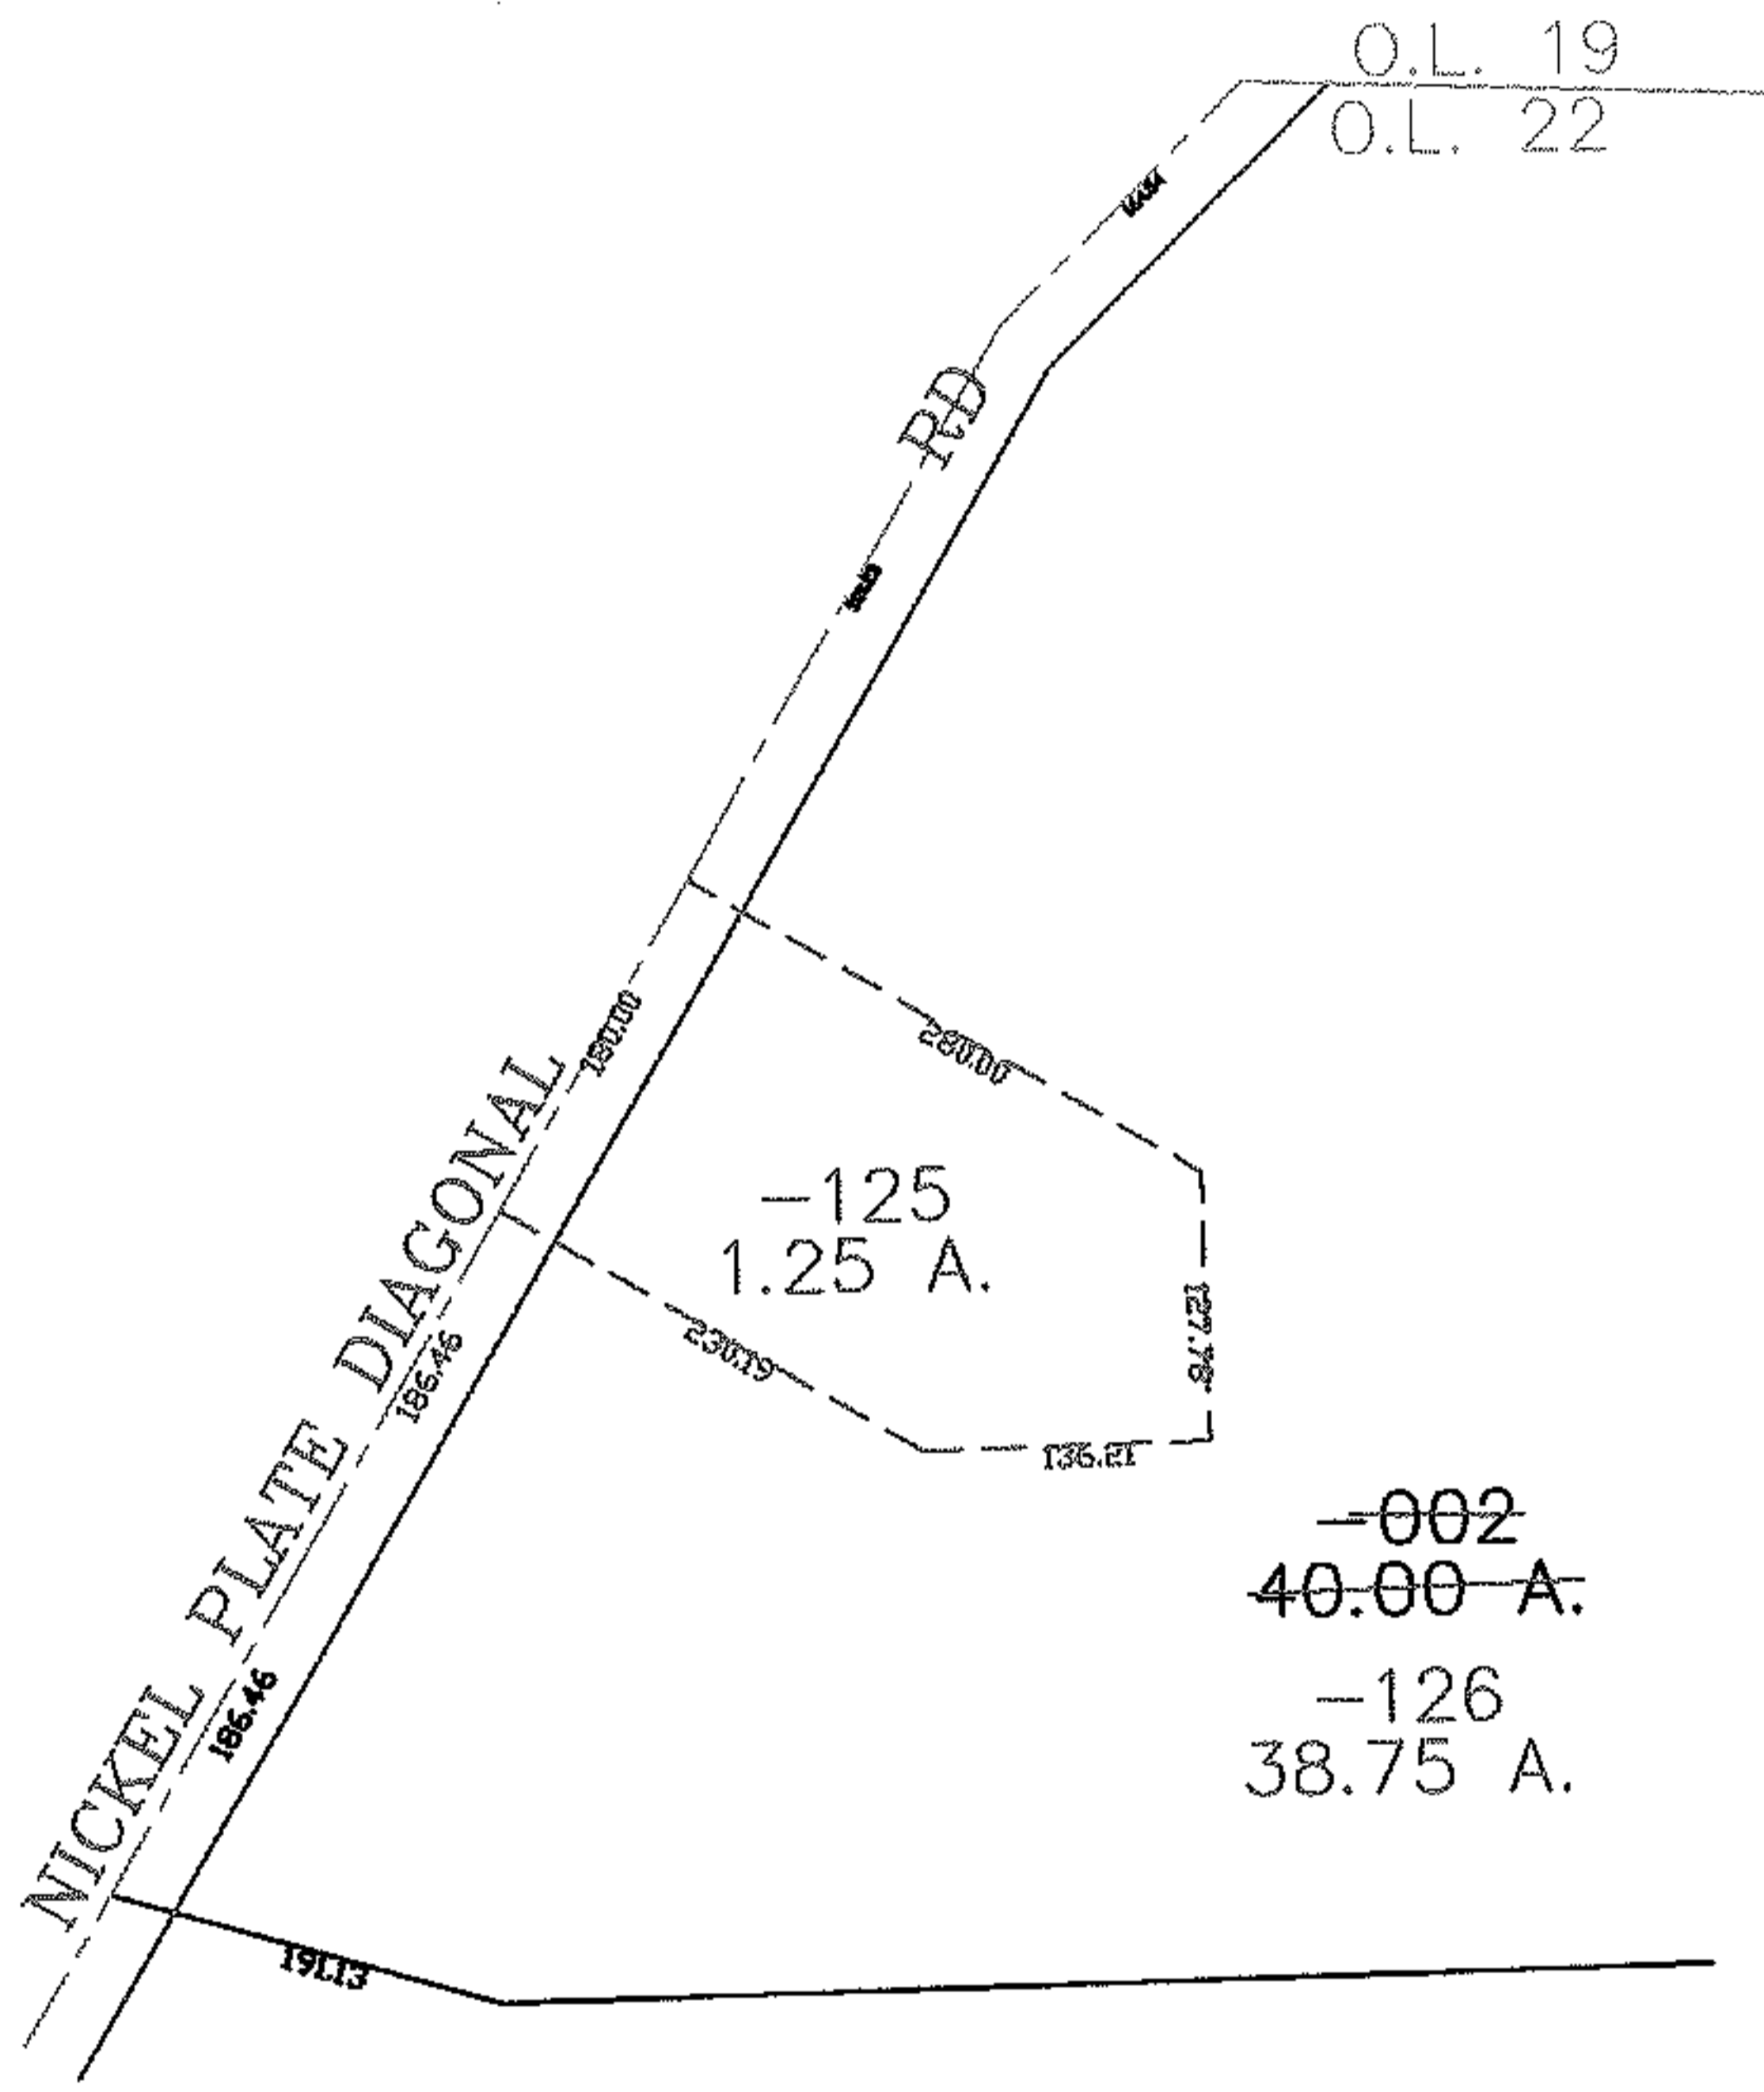


PARENT PARCEL: 10-00-022-000-002
CHILD PARCEL: 10-00-022-000-125, -126
STARTING POINT: CENTERLINE OF NICKEL PLATE DIAGONAL RD & O.L. 22

07-02367

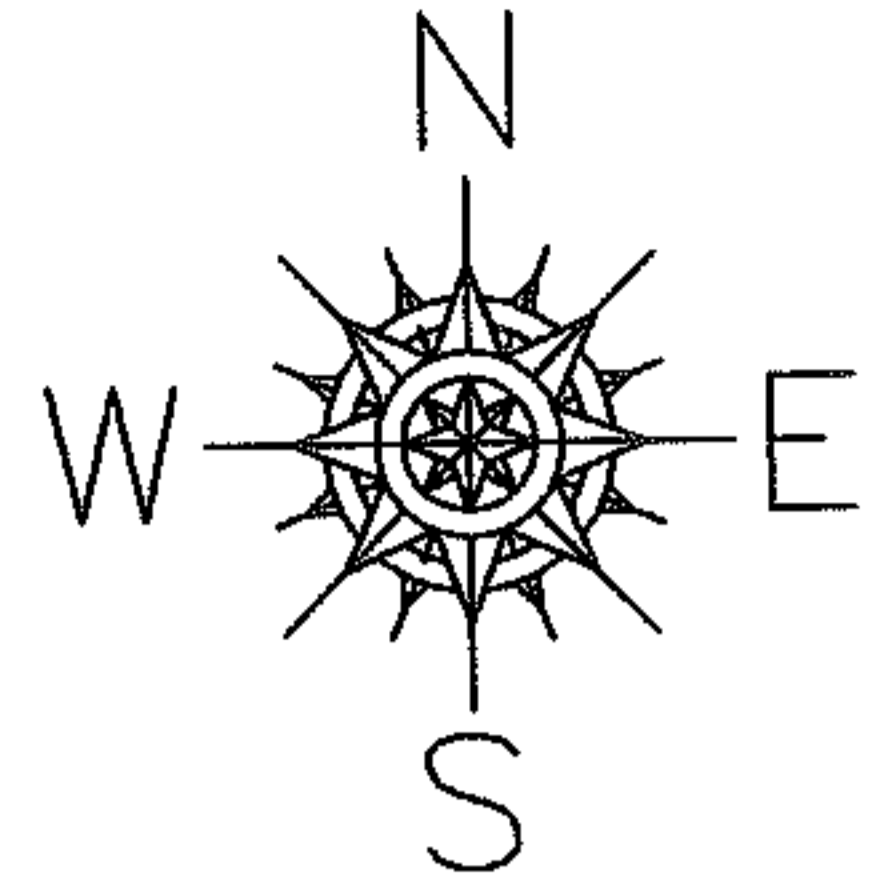

SPLITS/DEEDS PROCESSED
LORAIN COUNTY TAX MAP DEPARTMENT
226 MIDDLE AVE. ELYRIA, OHIO

SURVEYED BY: RICHARD D. CARLSON
CLOSURE: 0.00 : 10.000
MAP PAGE(S): 10-00-022-B
APPROVED BY: JAH DATE: 5-2-07
SCALE: 1" = 200 PRIOR INSTRUMENT: 20050103258