




MASTER

PARENT PARCEL: 12-00-016-000-023

CHILD PARCEL: 12-00-016-000-060, -061

STARTING POINT: CENTERLINE OF ELYRIA TWINSBURG RD & BOONE RD

07-02368

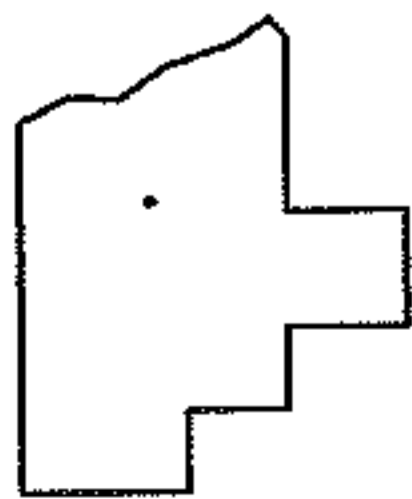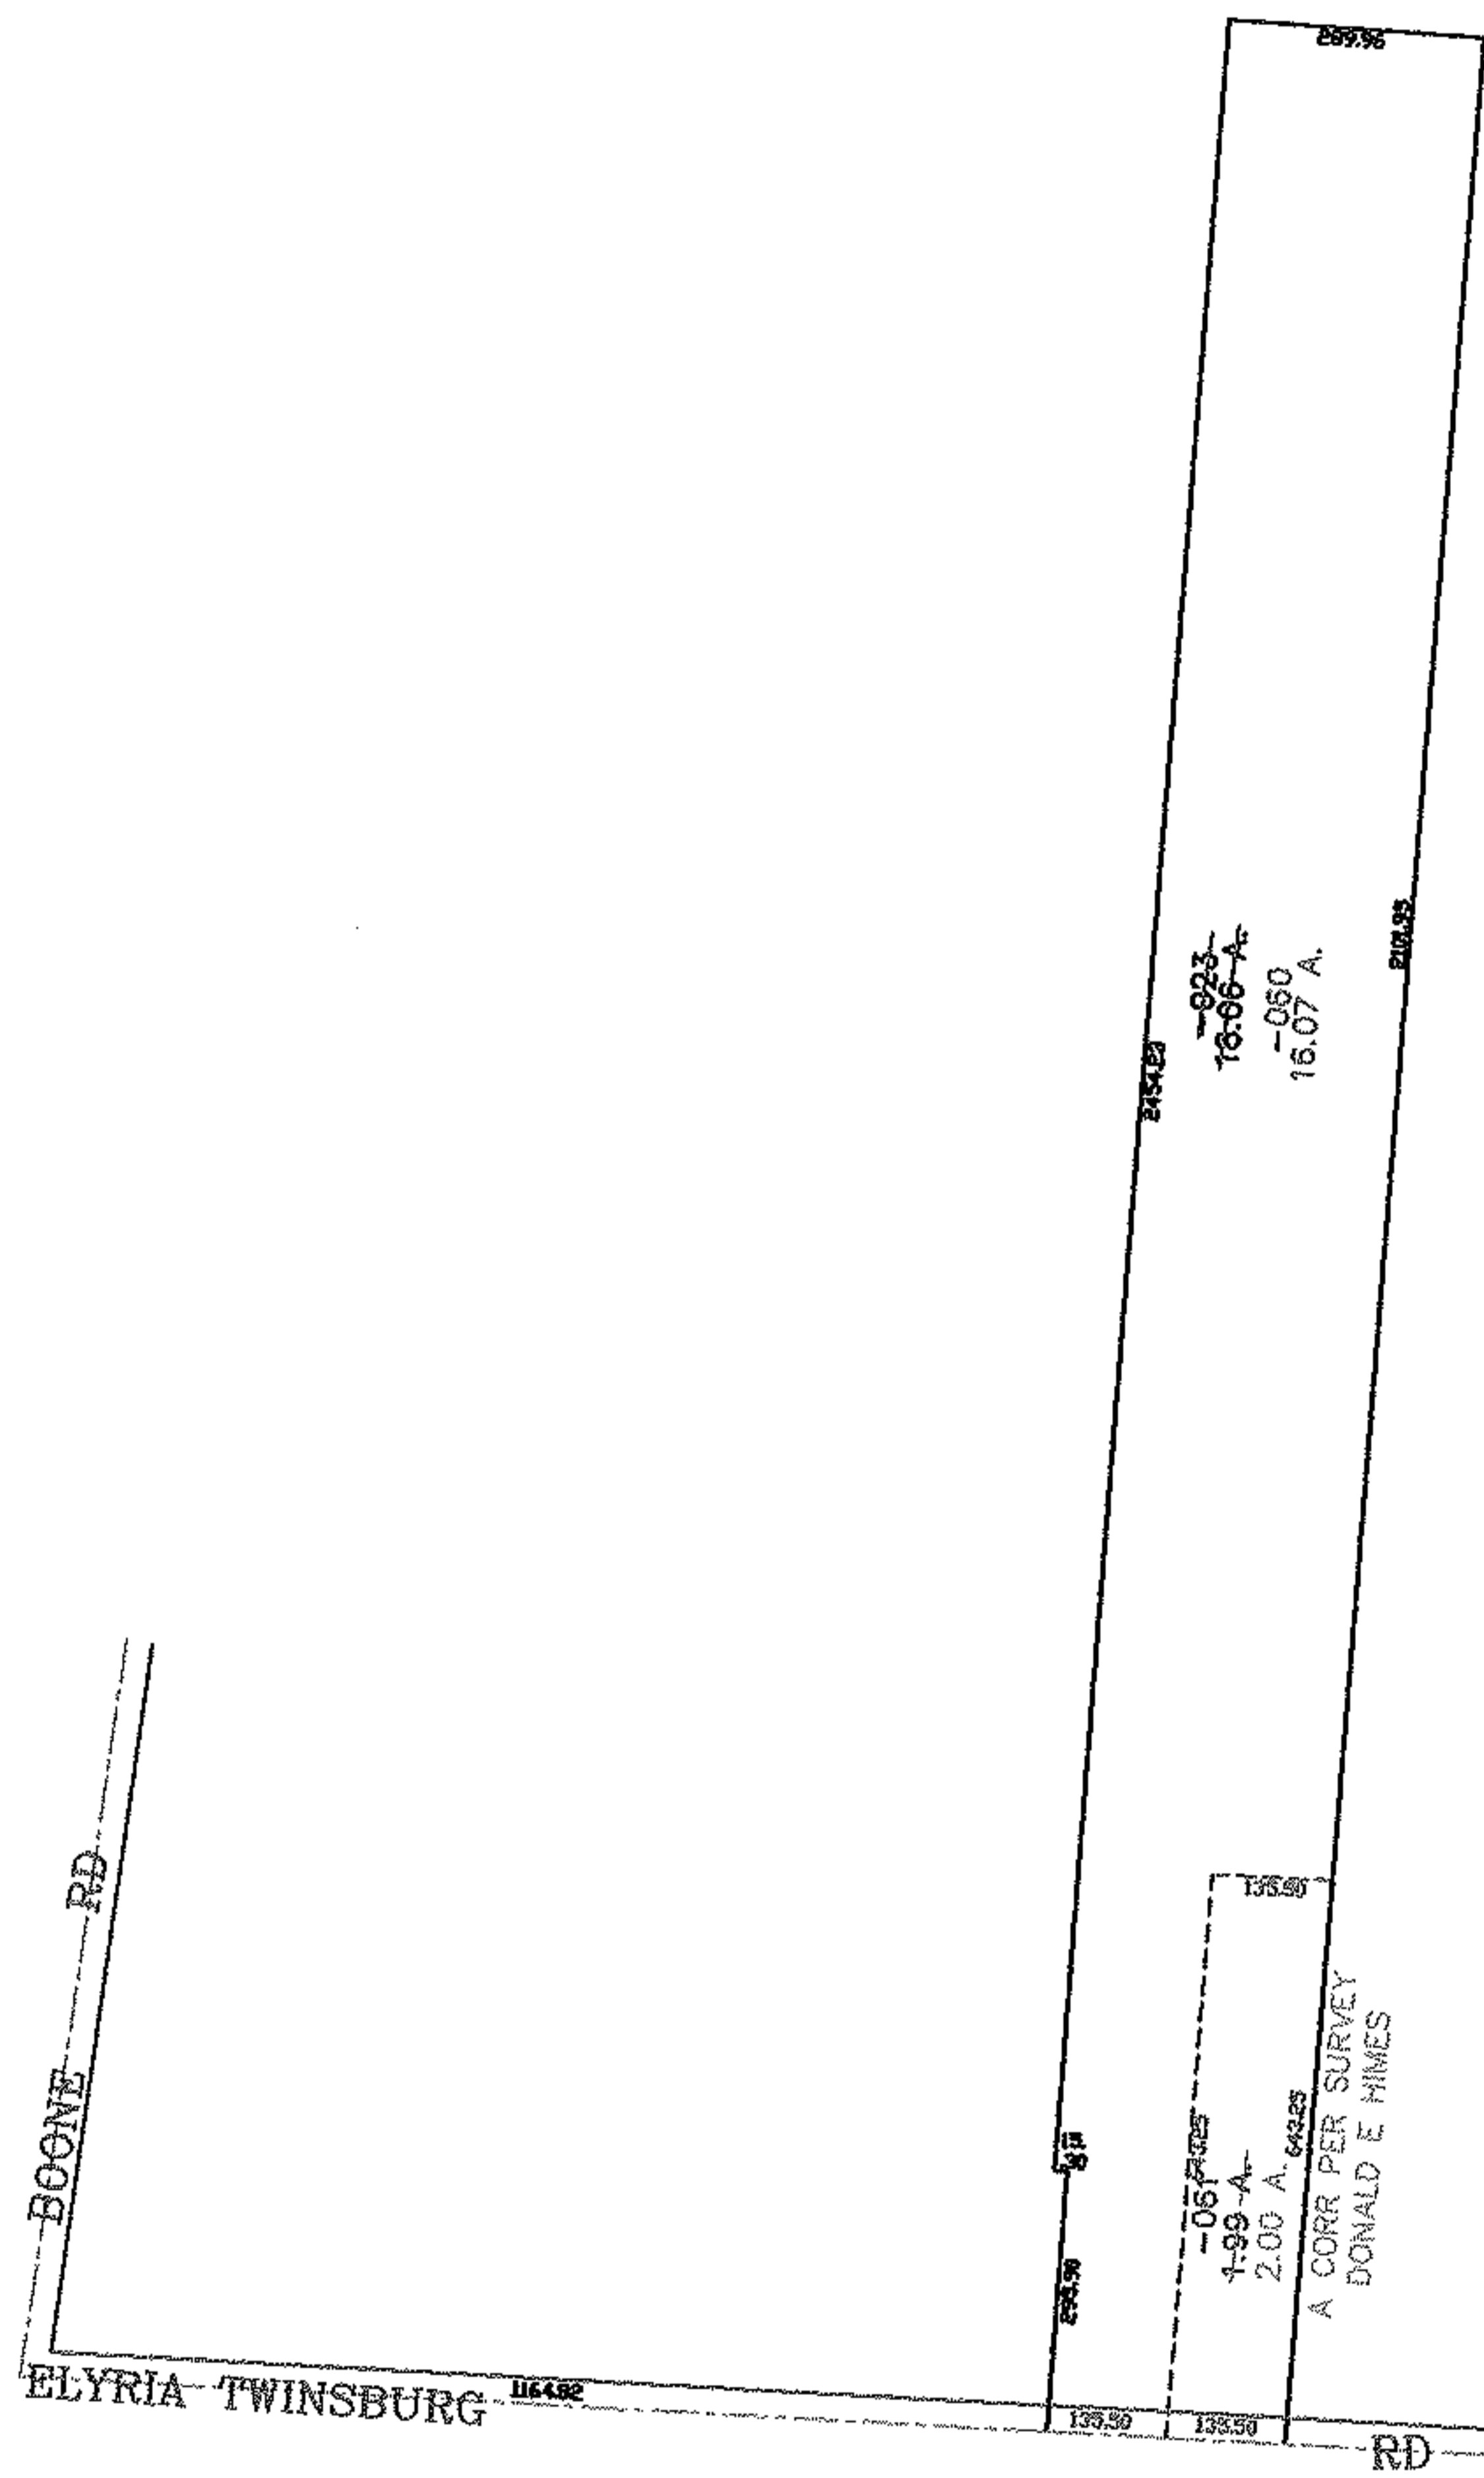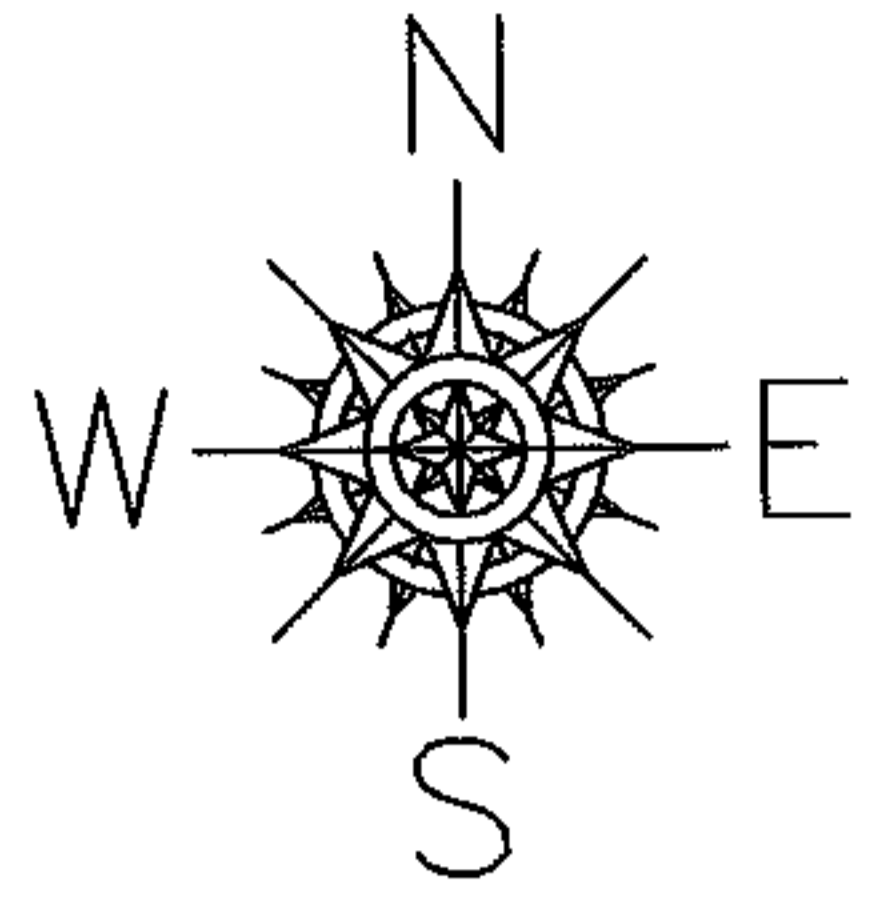

SPLITS/DEEDS PROCESSED

LORAIN COUNTY TAX MAP DEPARTMENT
226 MIDDLE AVE. ELYRIA, OHIO

SURVEYED BY: DONALD E HIMES
CLOSURE: 0.00 : 10,000
MAP PAGE(S): 12-00-016-A
APPROVED BY: JAH DATE: 5-7-07
SCALE: 1" = 100 PRIOR INSTRUMENT: 970487623