
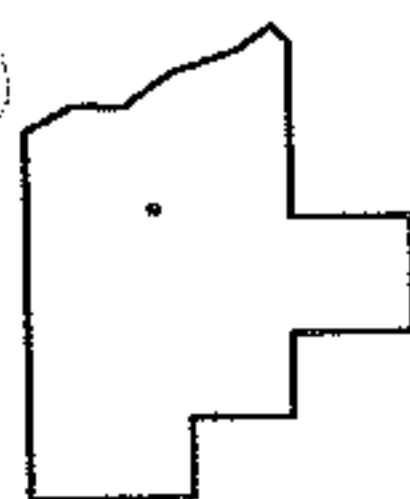
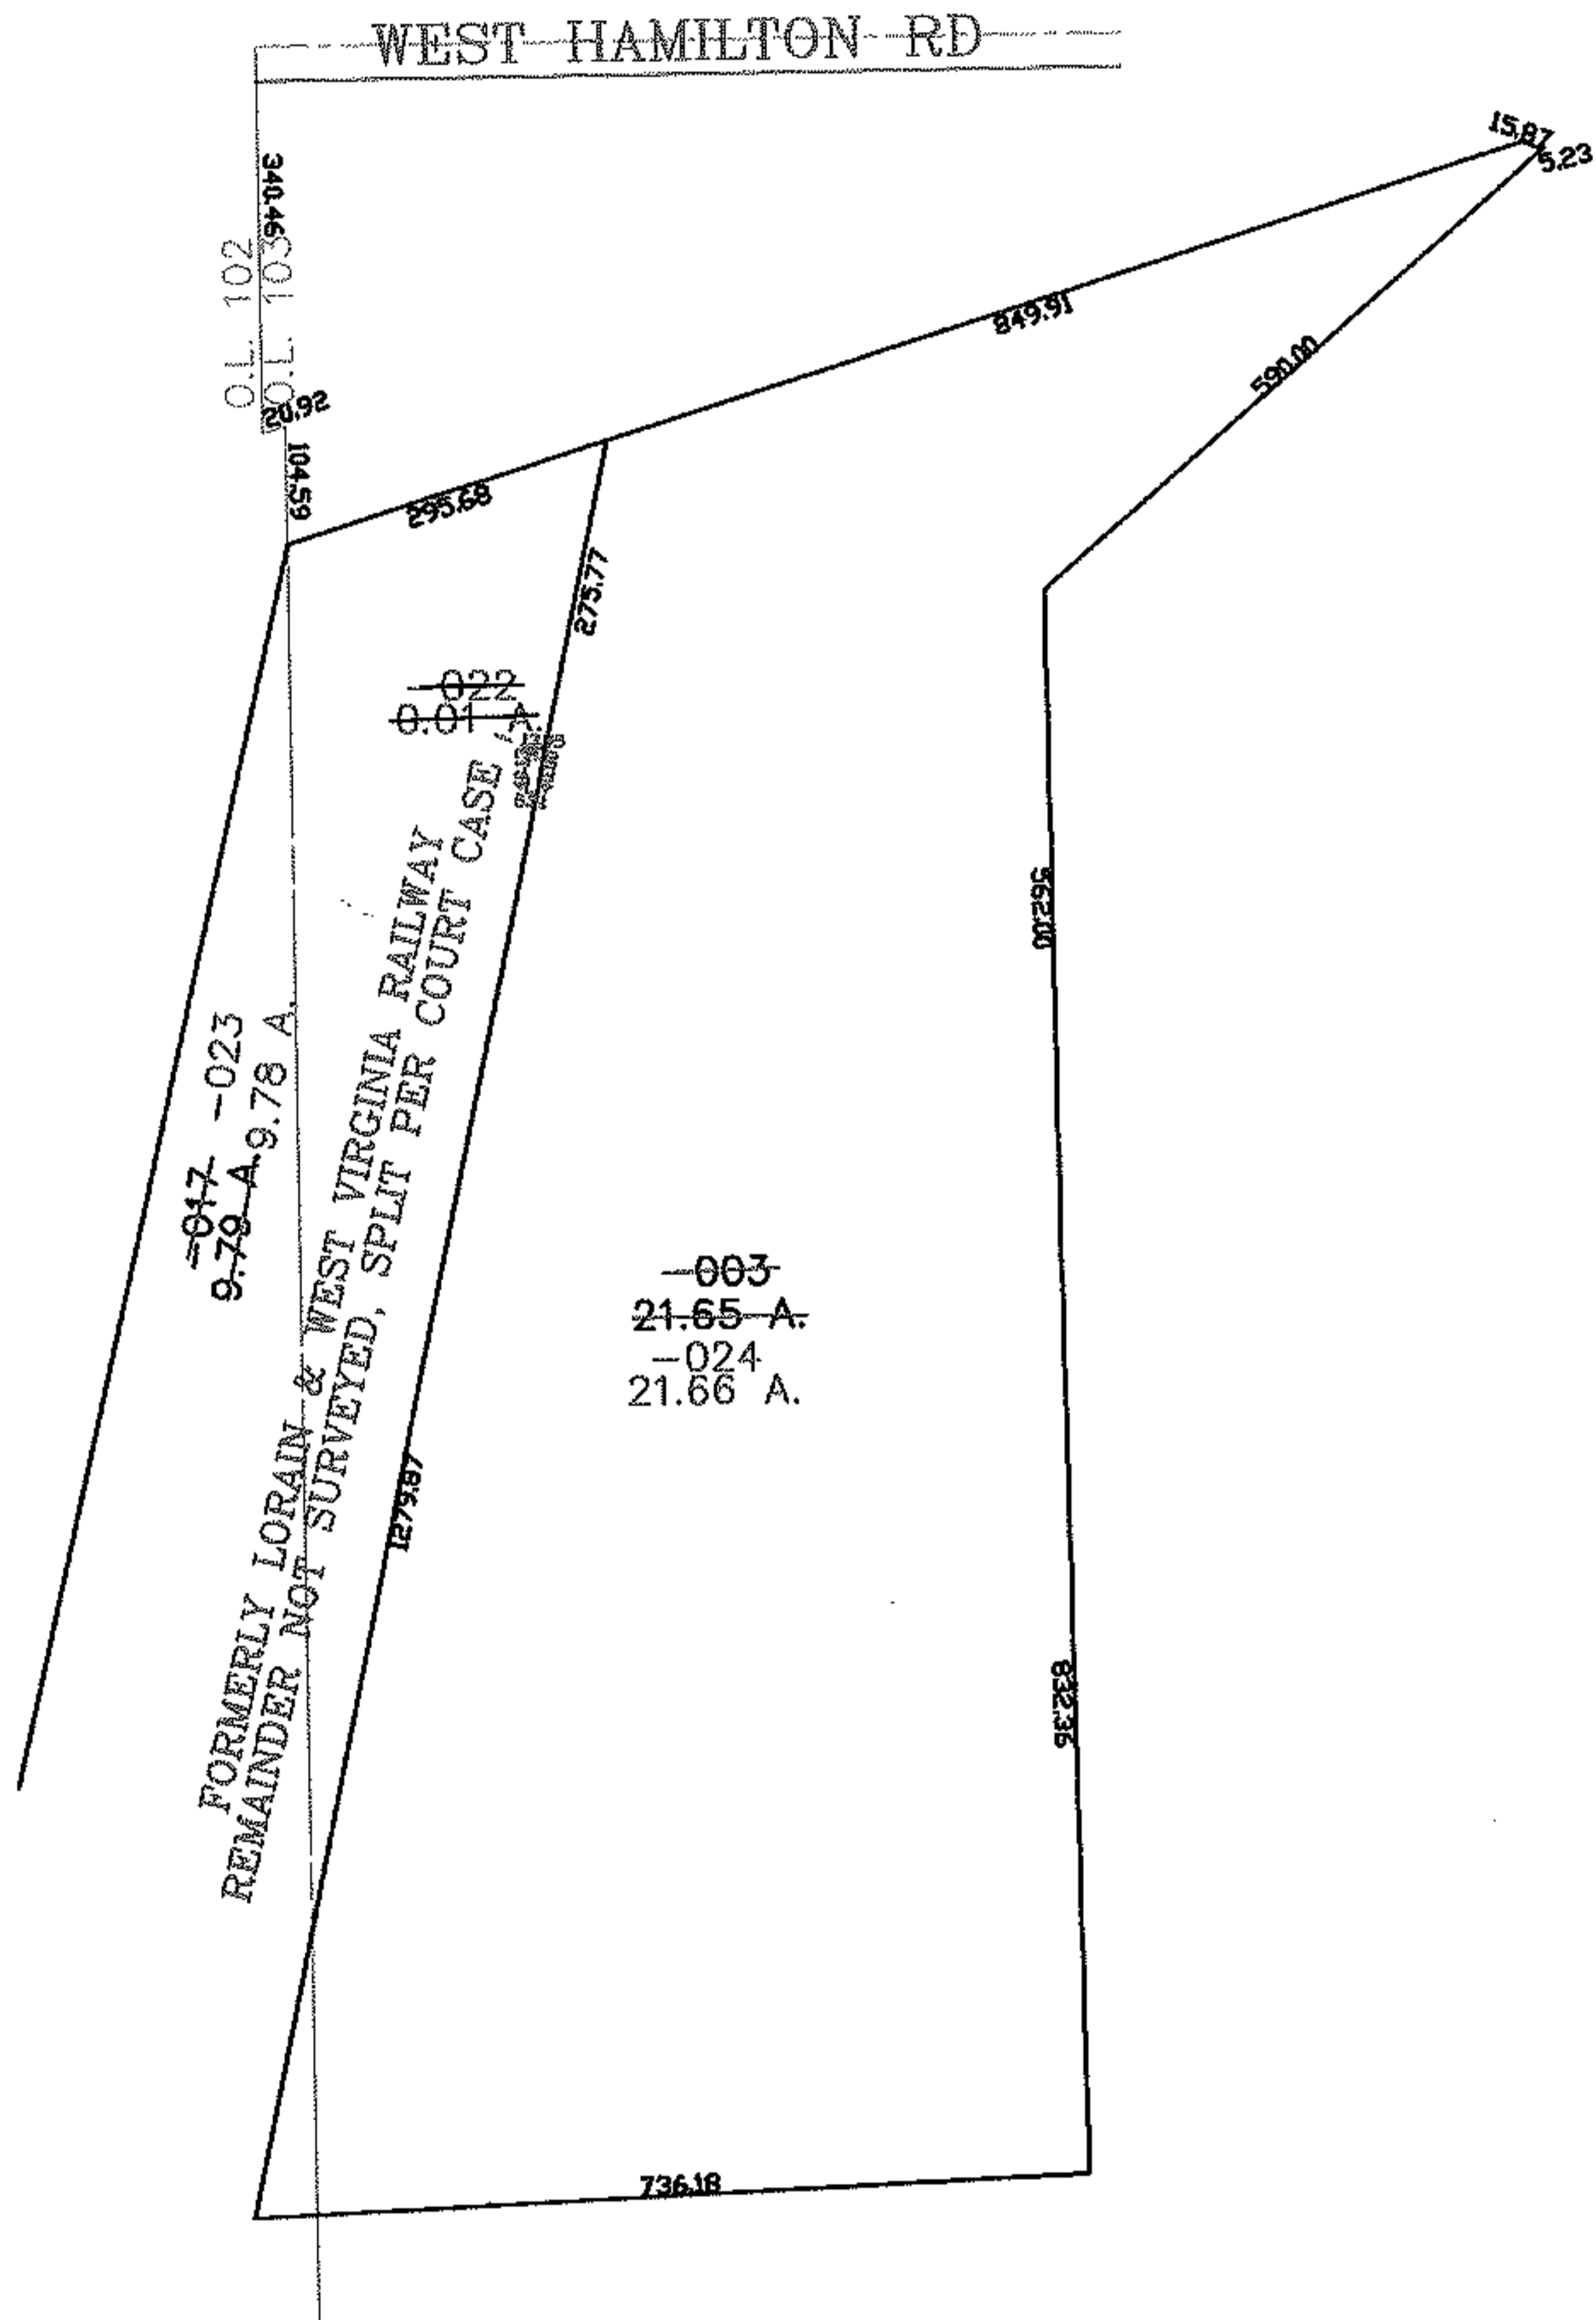


PARENT PARCEL: 09-00-103-000-017, -003

CHILD PARCEL: 09-00-103-022 THRU -024

STARTING POINT: CENTERLINE OF WEST HAMILTON RD & O.L. 103

07-02370

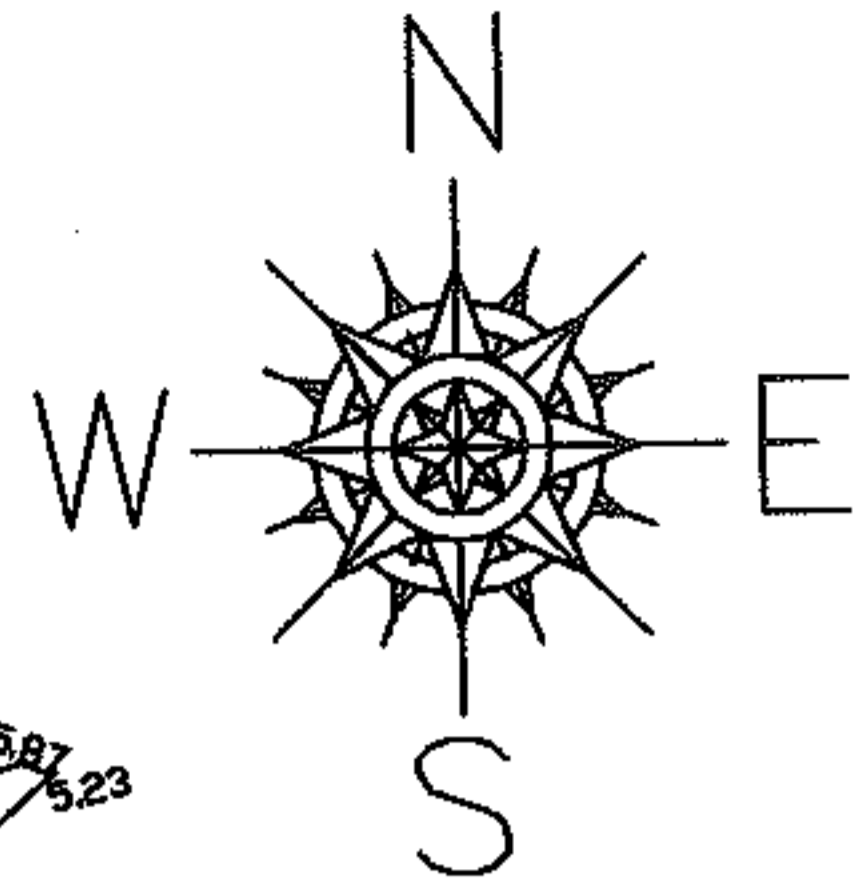

SPLITS/DEEDS PROCESSED
 LORAIN COUNTY TAX MAP DEPARTMENT
 226 MIDDLE AVE. ELYRIA, OHIO

SURVEYED BY: EDWARD DUDLEY
 CLOSURE: 0.00 : 10.000
 MAP PAGE(S): 09-00-102-B
 APPROVED BY: JAH DATE: 5-9-07
 SCALE: 1" = 300 PRIOR INSTRUMENT: 20060140334