
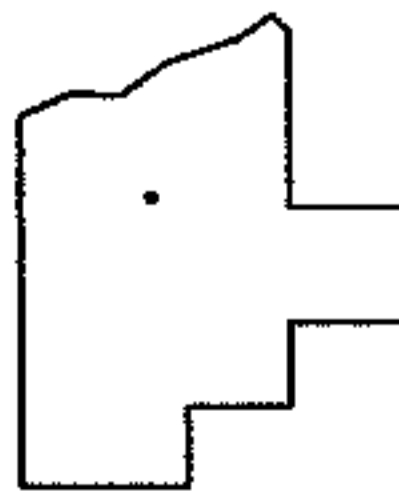
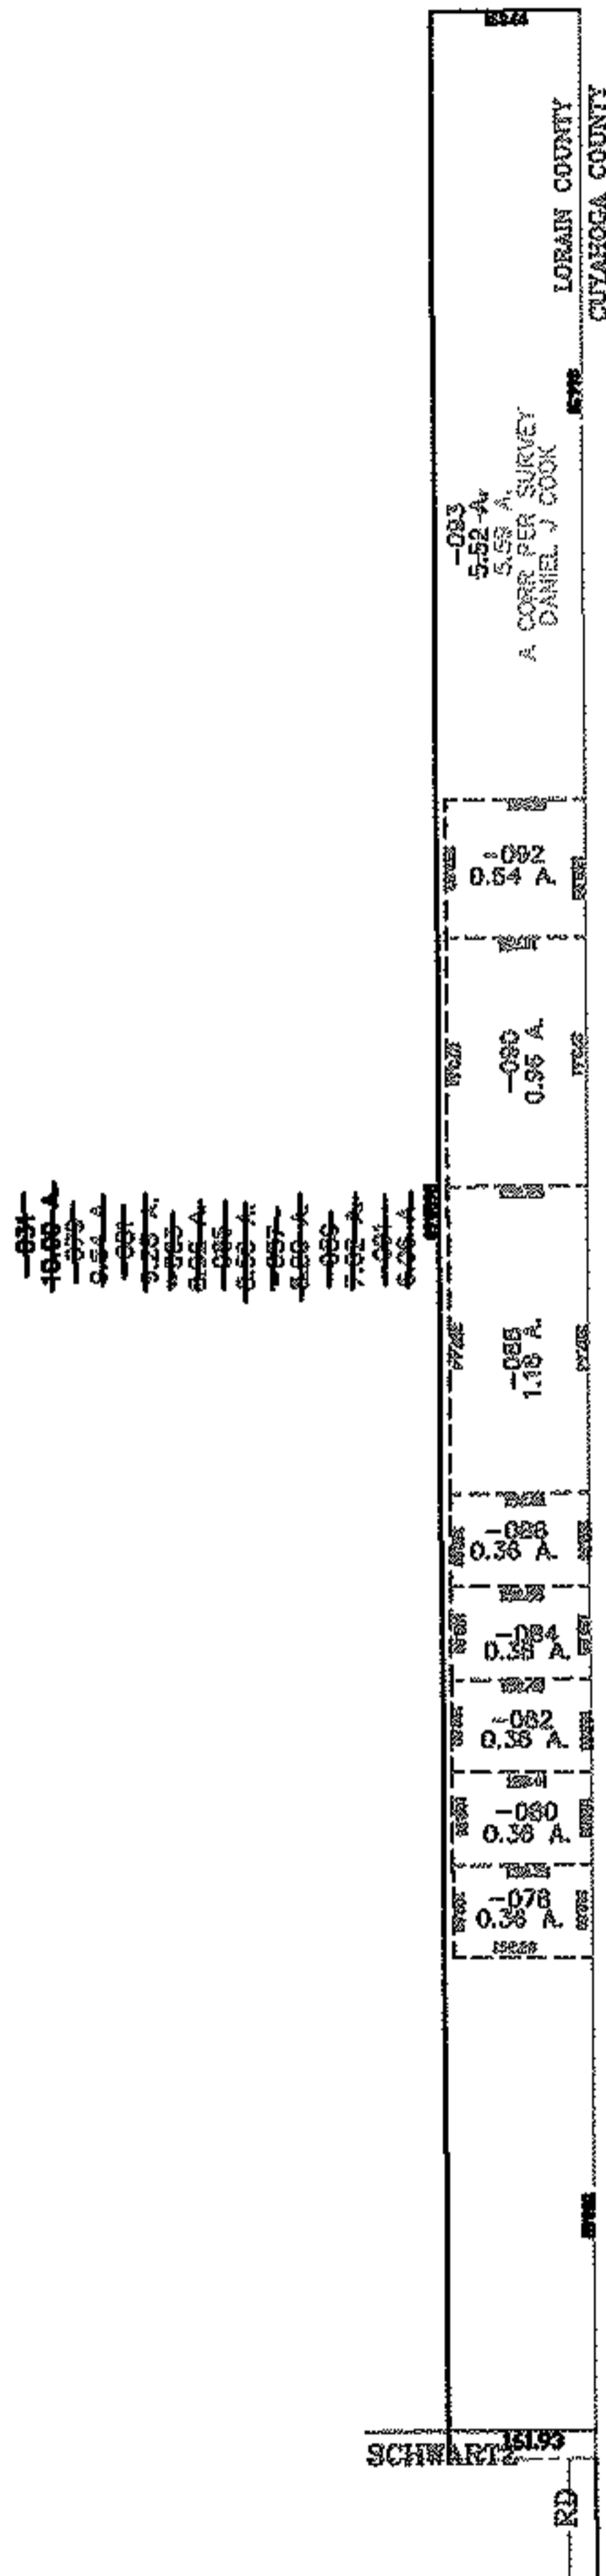


PARENT PARCEL: 04-00-026-108-031

CHILD PARCEL: 04-00-026-108-078 THRU -093

STARTING POINT: COUNTY LINE OF LORAIN/CUYHOGA & CENTERLINE OF SCHWARTZ RD

07-02371

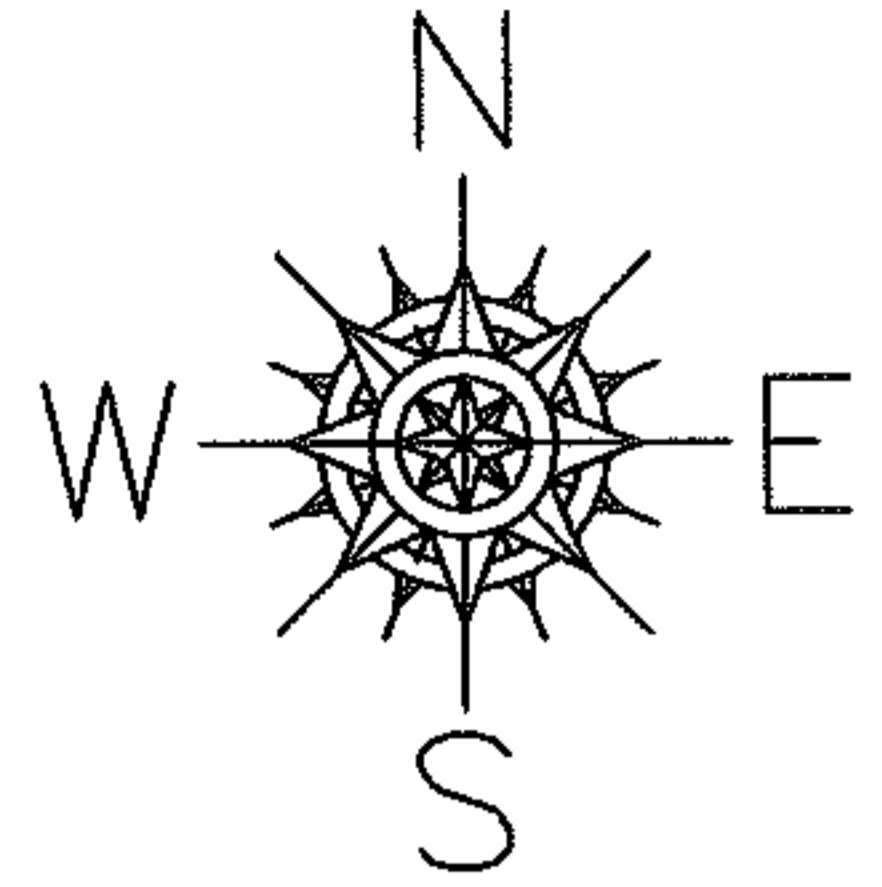

SPLITS/DEEDS PROCESSED

LORAIN COUNTY TAX MAP DEPARTMENT
226 MIDDLE AVE. ELYRIA, OHIO

SURVEYED BY: DANIEL J COOK
 CLOSURE: 0.00 : 10.000
 MAP PAGE(S): 04-00-026-D
 APPROVED BY: JAH DATE: 5-11-07
 SCALE: 1" = 400' PRIOR INSTRUMENT: DV 1296/657