


PARENT PARCEL: 07-00-028-103-095


CHILD PARCEL: 07-00-028-103-133 THRU -135

STARTING POINT: NORTHWEST CORNER OF S/L 1 ON CRESTVIEW SUB NO 1

07-02374

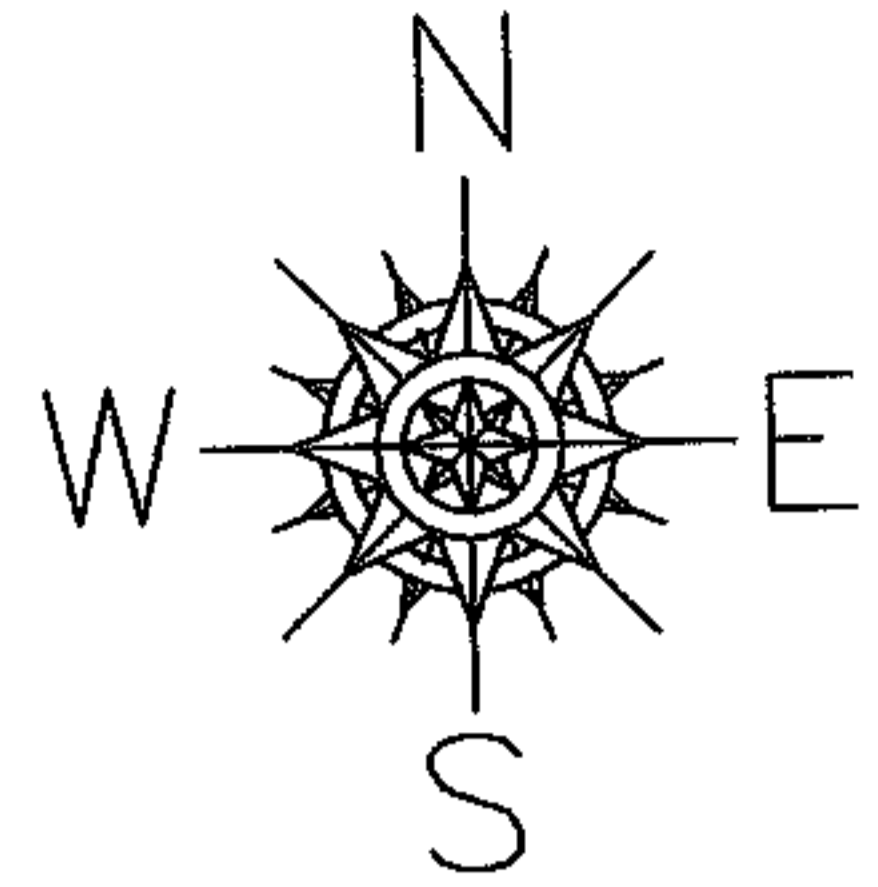

CENTER RIDGE RD

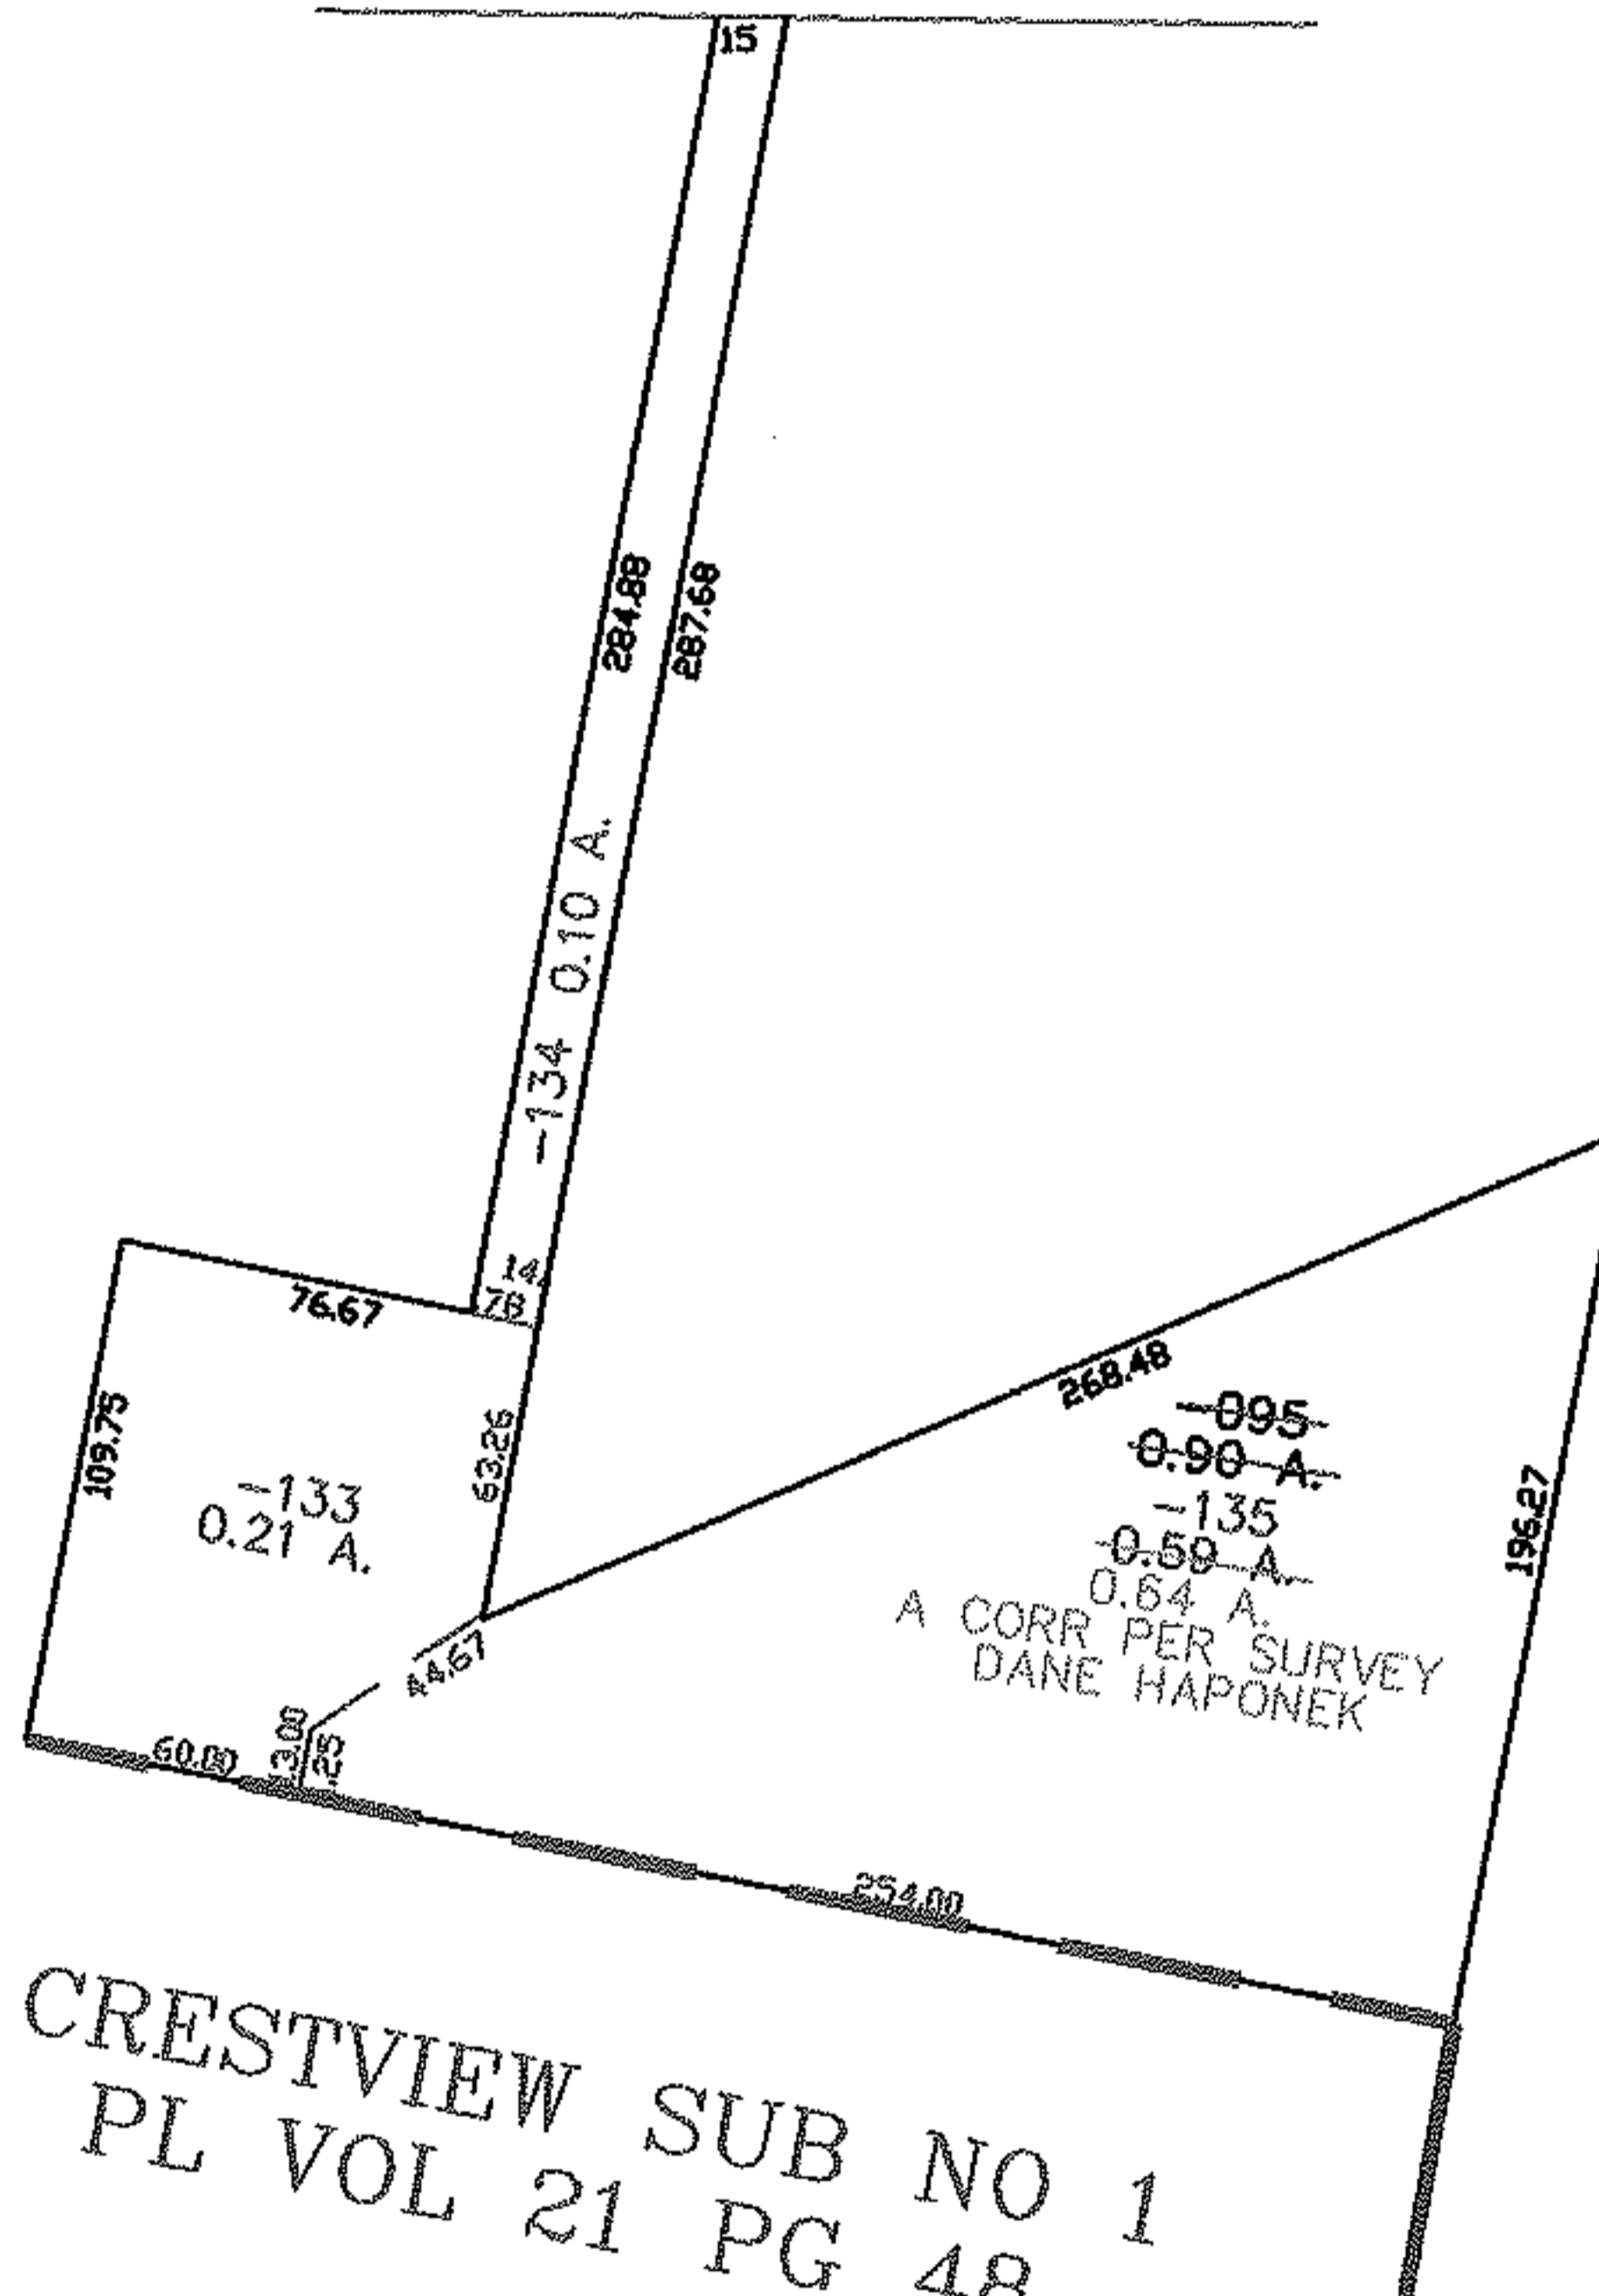

CRESTVIEW SUB NO 1  
PL VOL 21 PG 48

SPLITS/DEEDS PROCESSED

LORAIN COUNTY TAX MAP DEPARTMENT  
226 MIDDLE AVE. ELYRIA, OHIO

SURVEYED BY: DANE HAPONEK

CLOSURE: 0.00 : 10.000

MAP PAGE(S): 07-00-028-D

APPROVED BY: JAH DATE: 5-18-07

SCALE: 1" = 100 PRIOR INSTRUMENT: DV 1116/310