
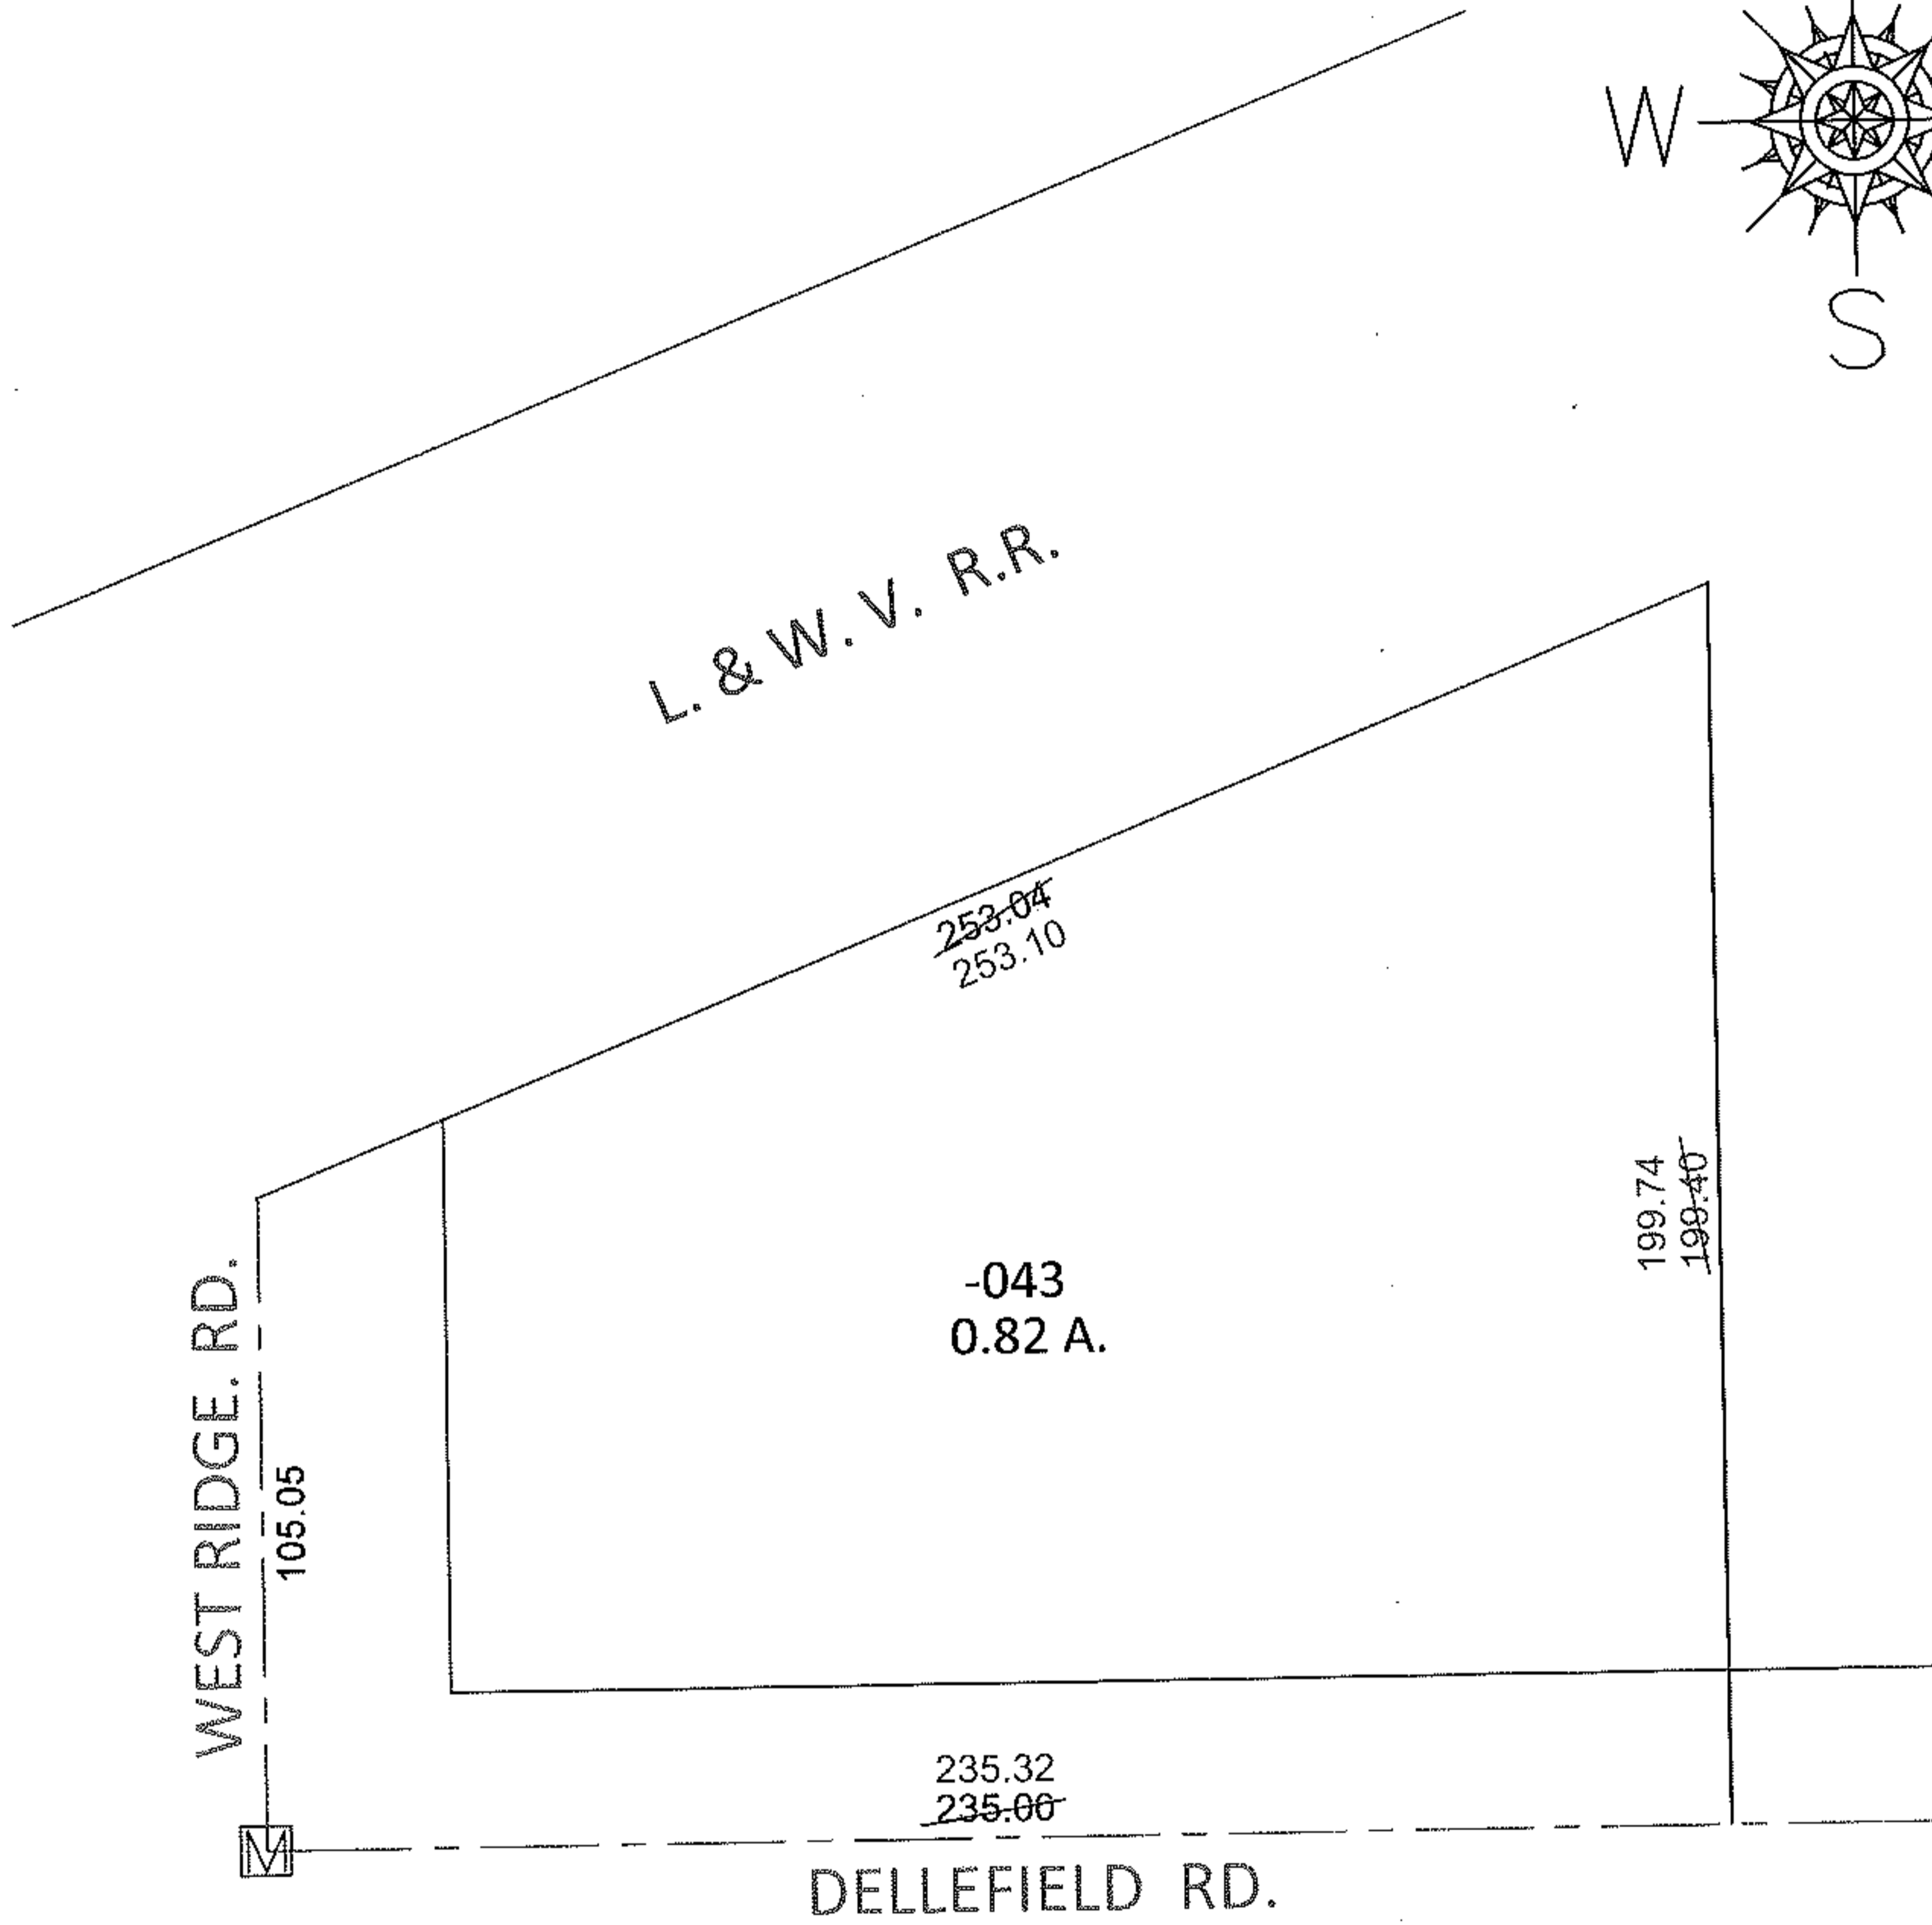


PARENT PARCEL: 06-23-001-102-043

11-02376-A


CHILD PARCEL: _____

STARTING POINT: AT A MON BOX AT INTERSECTION OF C/L OF WEST RIDGE RD. AND C/L OF DELLEFIELD RD

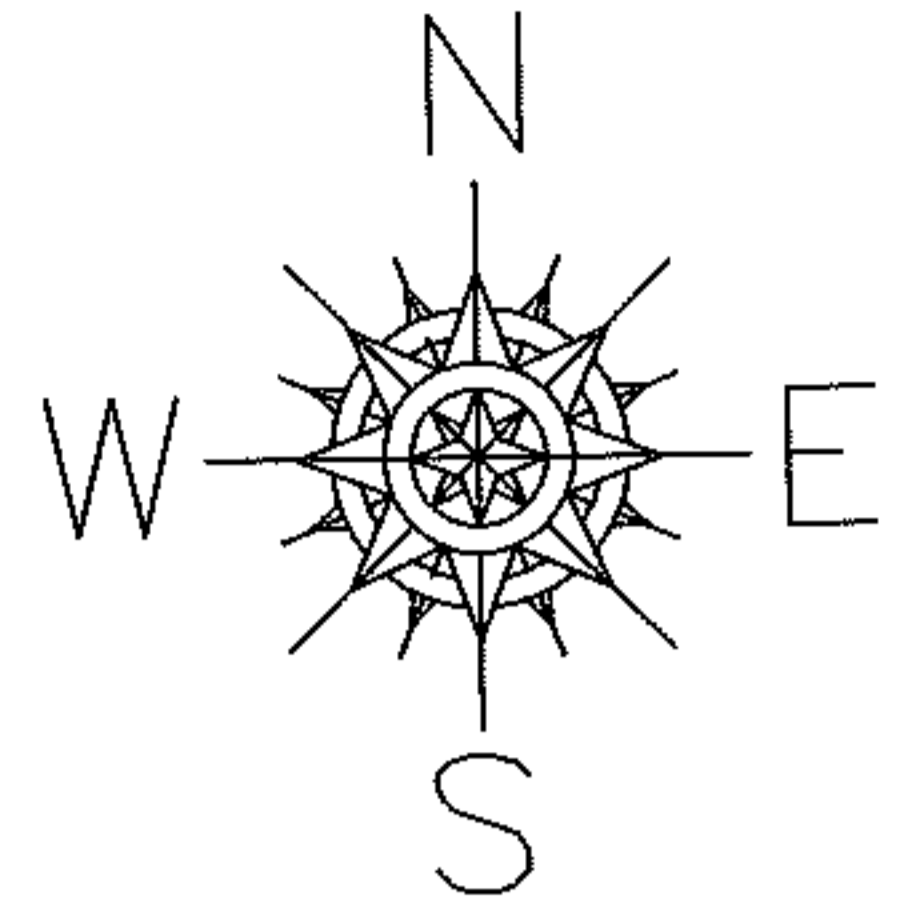

MAP CORRECTION ONLY

PER SURV. R. DORNER

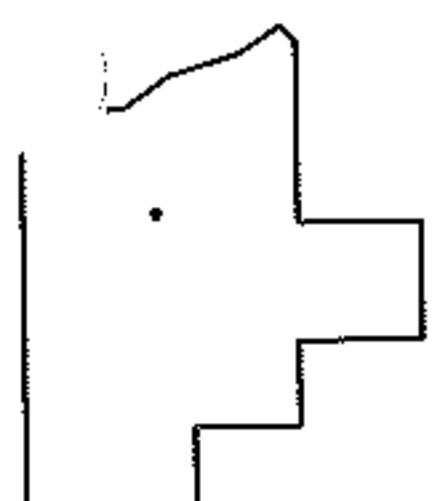

SPLITS/DEEDS PROCESSED

LORAIN COUNTY TAX MAP DEPARTMENT
226 MIDDLE AVE. ELYRIA, OHIO

SURVEYED BY: ROBERT A. DORNER

CLOSURE: .01:10,000

MAP PAGE(S): 6-19

APPROVED BY: RRM DATE: 10-27-11

SCALE: 1" = 50' PRIOR INST.: 20110360226