
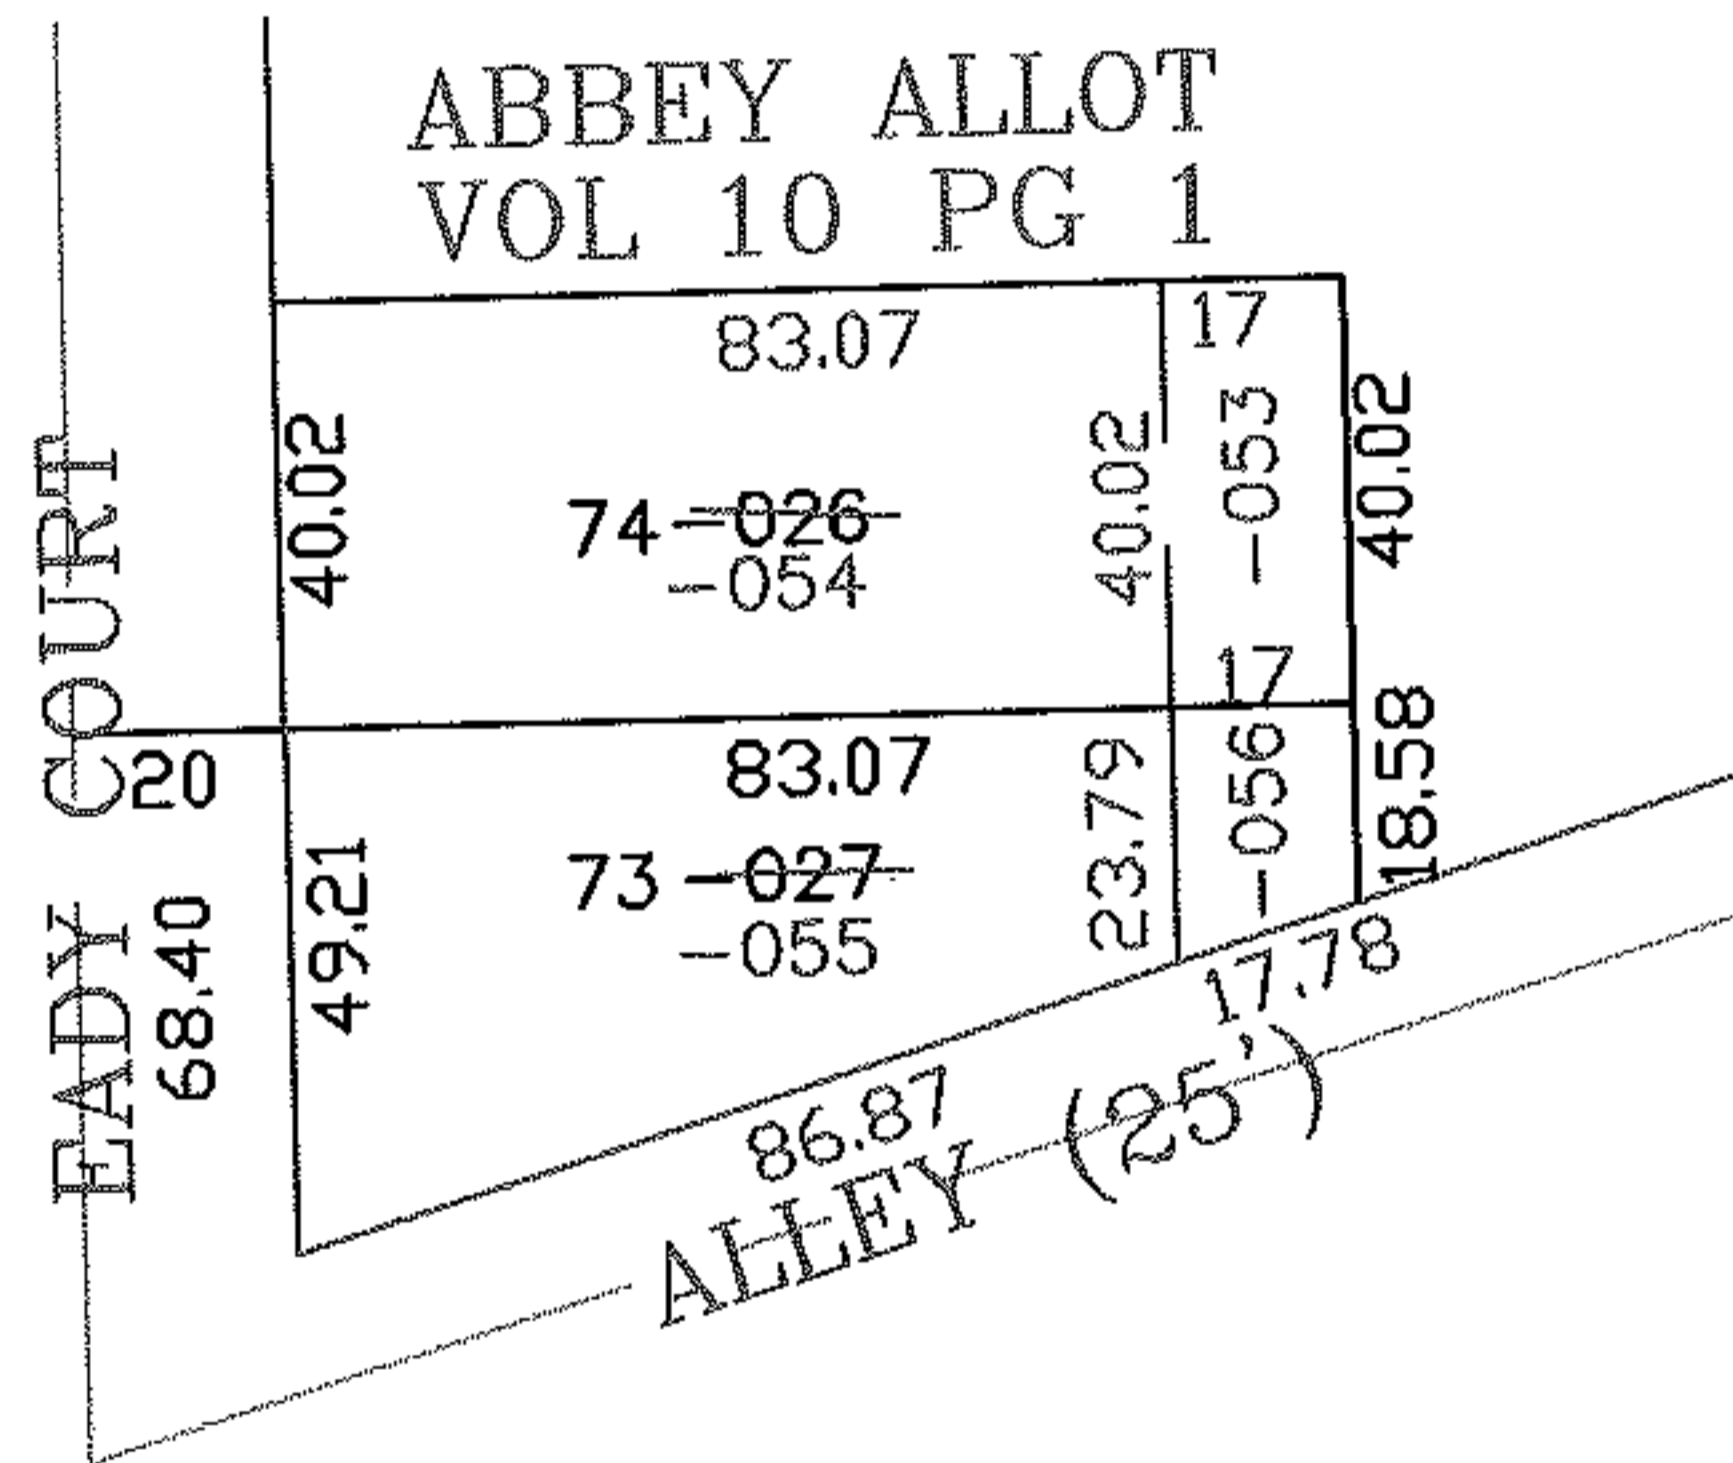


PARENT PARCEL: 06-25-012-102-026, -027  
CHILD PARCEL: 06-25-012-102-053 THRU -056  
STARTING POINT: CENTERLINE OF AN ALLEY AND EADY COURT

07-02376

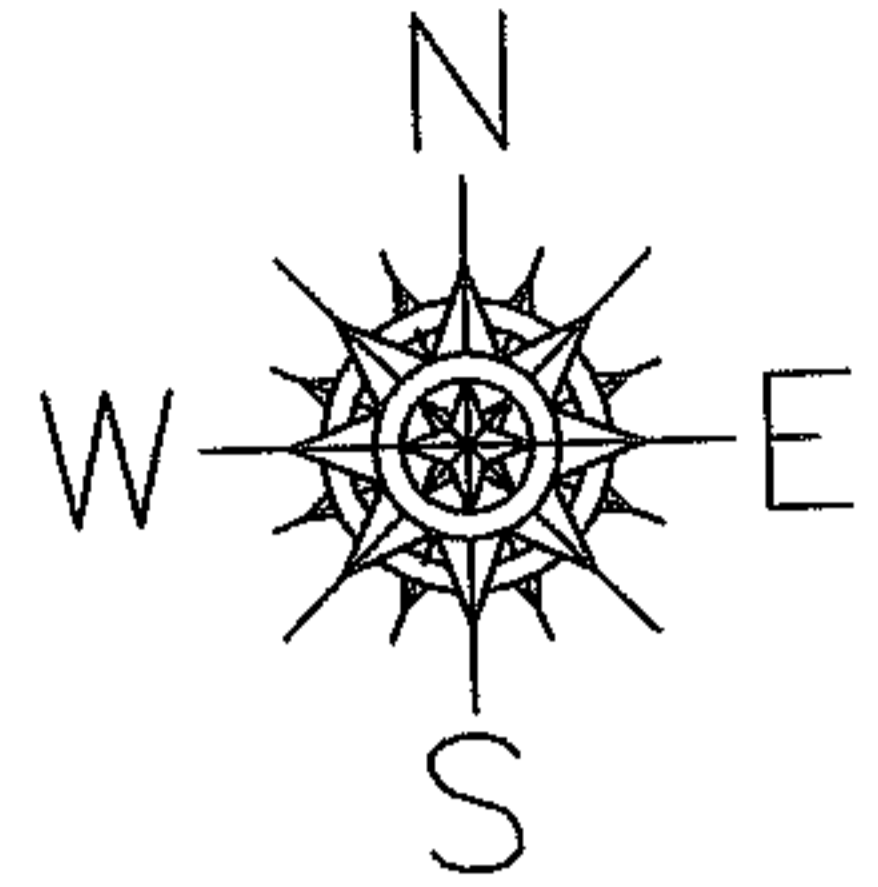

SPLITS/DEEDS PROCESSED

LORAIN COUNTY TAX MAP DEPARTMENT  
226 MIDDLE AVE. ELYRIA, OHIO

SURVEYED BY: THOMAS SIMON  
CLOSURE: 0.00 : 10.000  
MAP PAGE(S): 6-106  
APPROVED BY: JAH DATE: 5-23-07  
SCALE: 1" = 100' PRIOR INSTRUMENT: PL VOL 10/1