

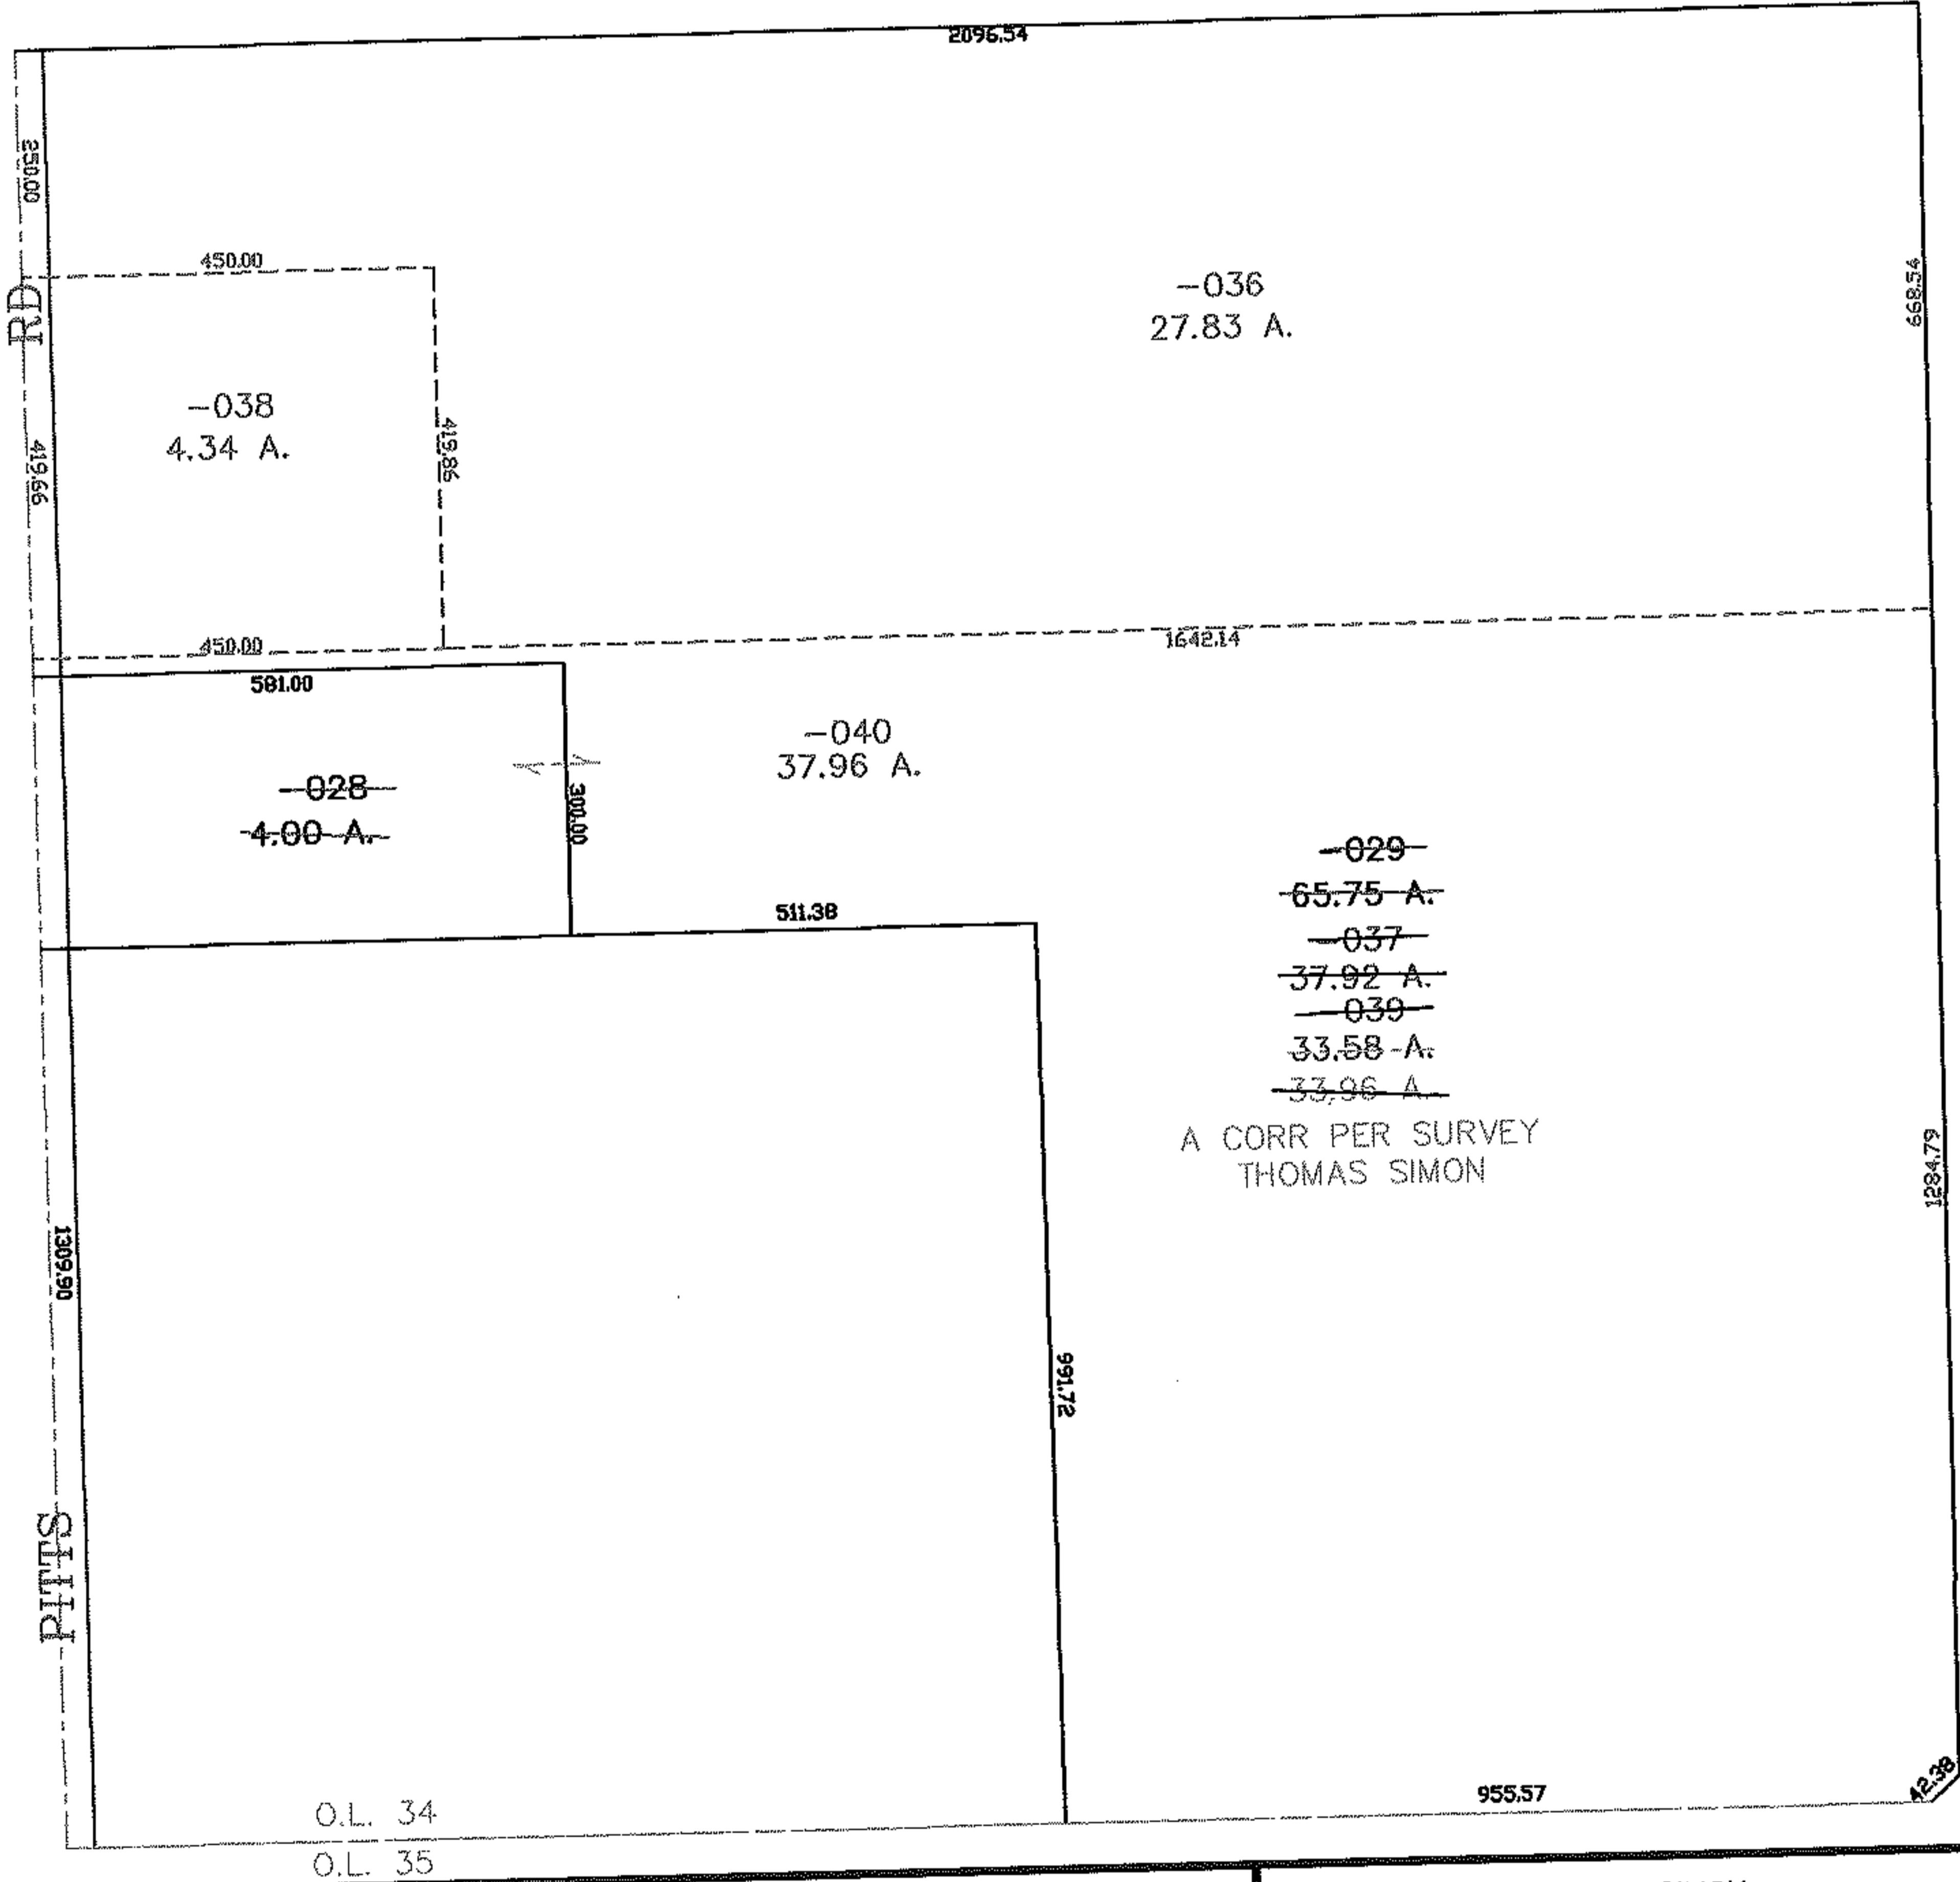


PARENT PARCEL: 18-00-034-000-029, -028
CHILD PARCEL: 18-00-034-000-036 THRU -040
STARTING POINT: CENTERLINE OF PITTS RD & O.L. 34

07-02377

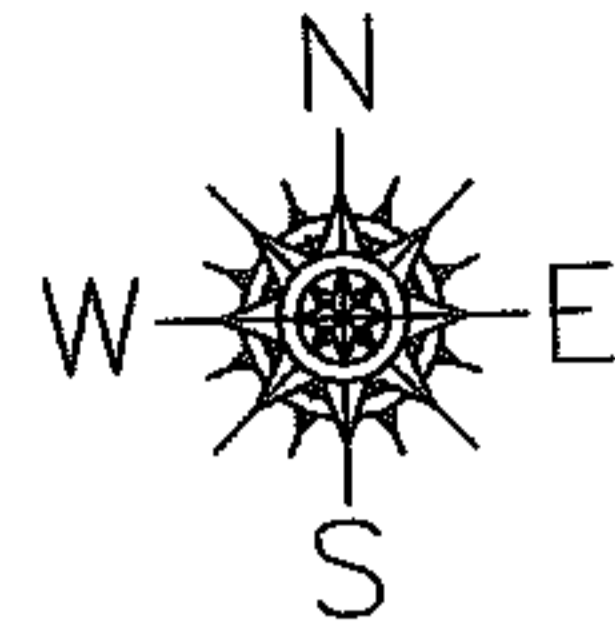

A CORR PER SURVEY
THOMAS SIMON

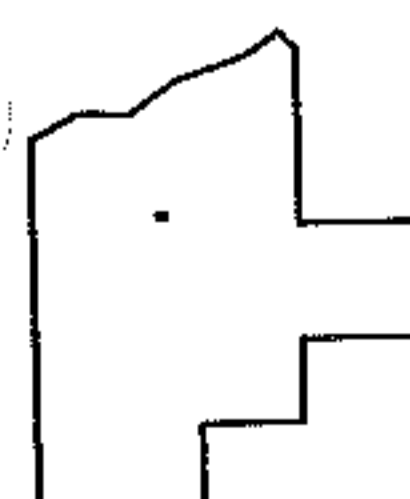

SPLITS/DEEDS PROCESSED
LORAIN COUNTY TAX MAP DEPARTMENT
226 MIDDLE AVE. ELYRIA, OHIO

SURVEYED BY: THOMAS SIMON
CLOSURE: 0.00 : 10.00
MAP PAGE(S): 18-00-034-C
APPROVED BY: JAH DATE: 5-25-07
SCALE: 1" = 300 PRIOR INSTRUMENT: DV 841/360