


PARENT PARCEL: 03-00-029-104-012


CHILD PARCEL: \_\_\_\_\_

STARTING POINT: PART OF S/L 80 & 81 IN KNICKERBOCKER SUB. NO.2 (VOL.12 PG.16)

11-02380-C

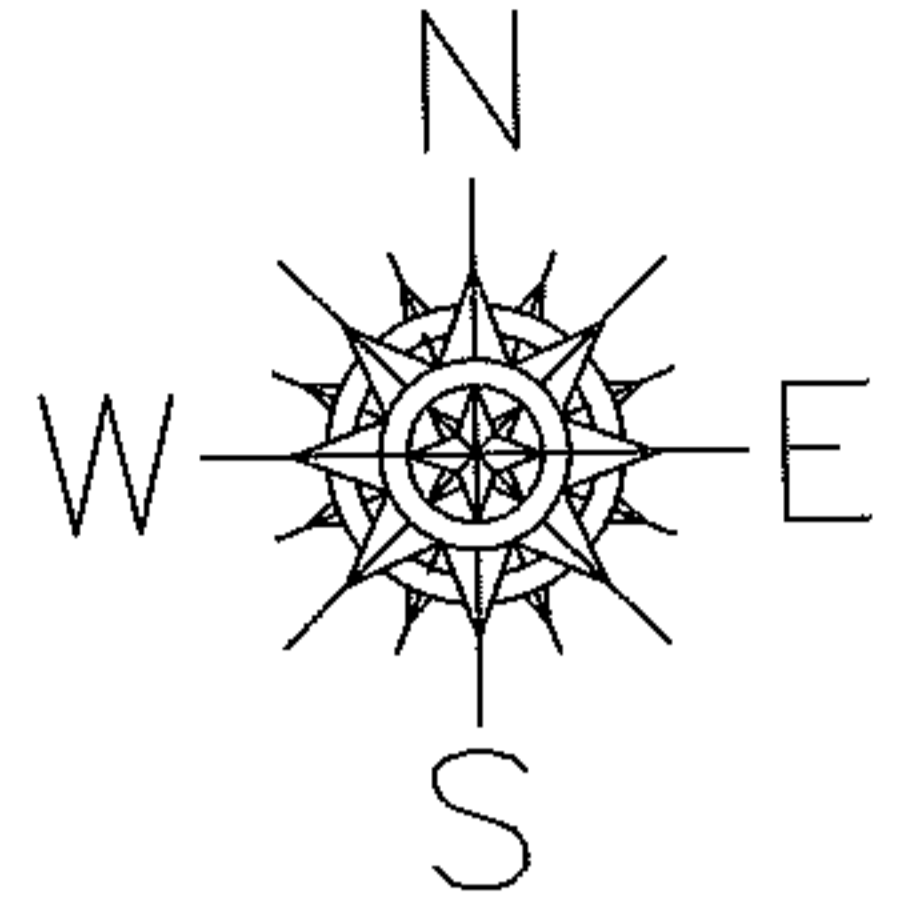

BELLE AVE.

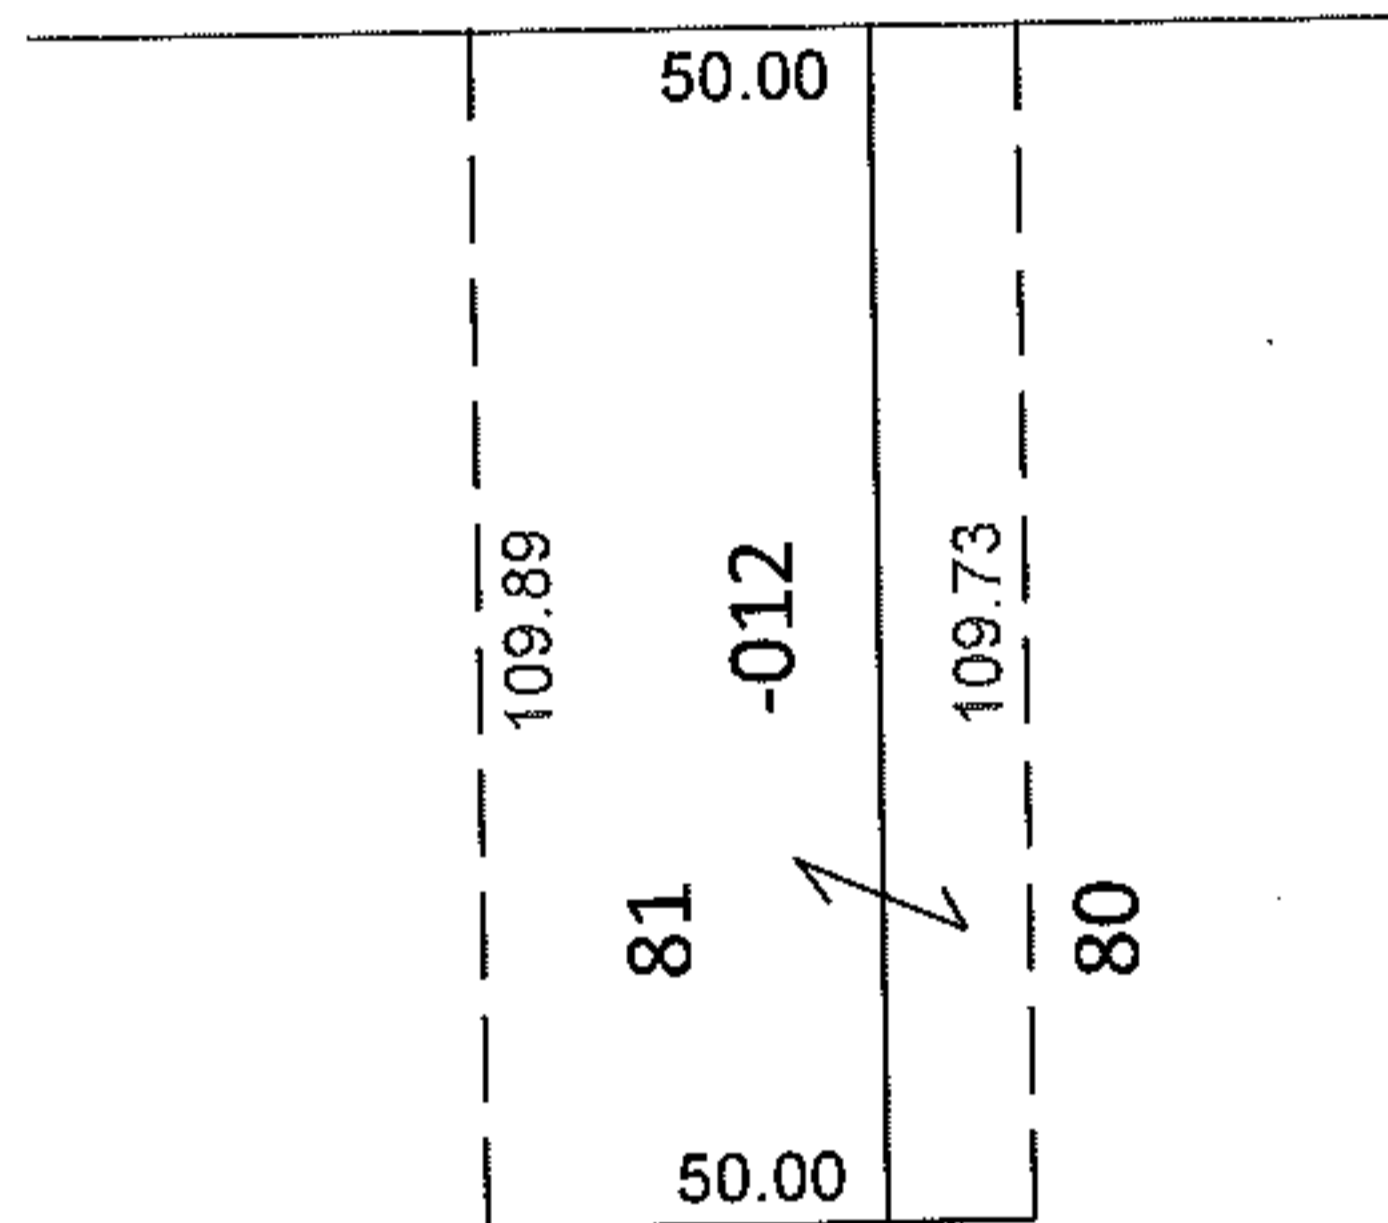


DEPTH CORRECTION

03-00-029-104-012

109.89

50 X ~~109~~

PER PRIOR DEEDS

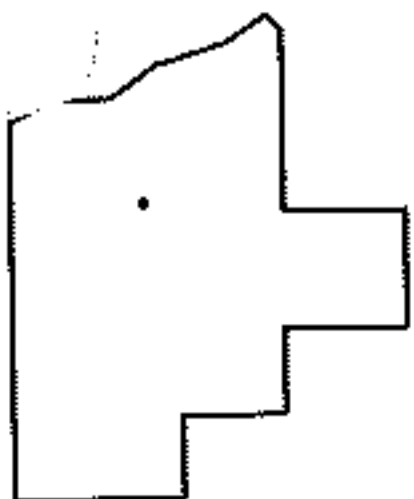

SPLITS/DEEDS PROCESSED

LORAIN COUNTY TAX MAP DEPARTMENT  
226 MIDDLE AVE. ELYRIA, OHIO

SURVEYED BY: N/A

CLOSURE: N/A

MAP PAGE(S): 3-00-029-B

APPROVED BY: RRM DATE: 11-2-11

SCALE: 1"=50' PRIOR INST.: 19970486505