


PARENT PARCEL: 01-00-044-000-024

CHILD PARCEL: 01-00-044-000-049, -050

STARTING POINT: CENTERLINE OF CLAUS RD & NORTH RIDGE RD

07-02380

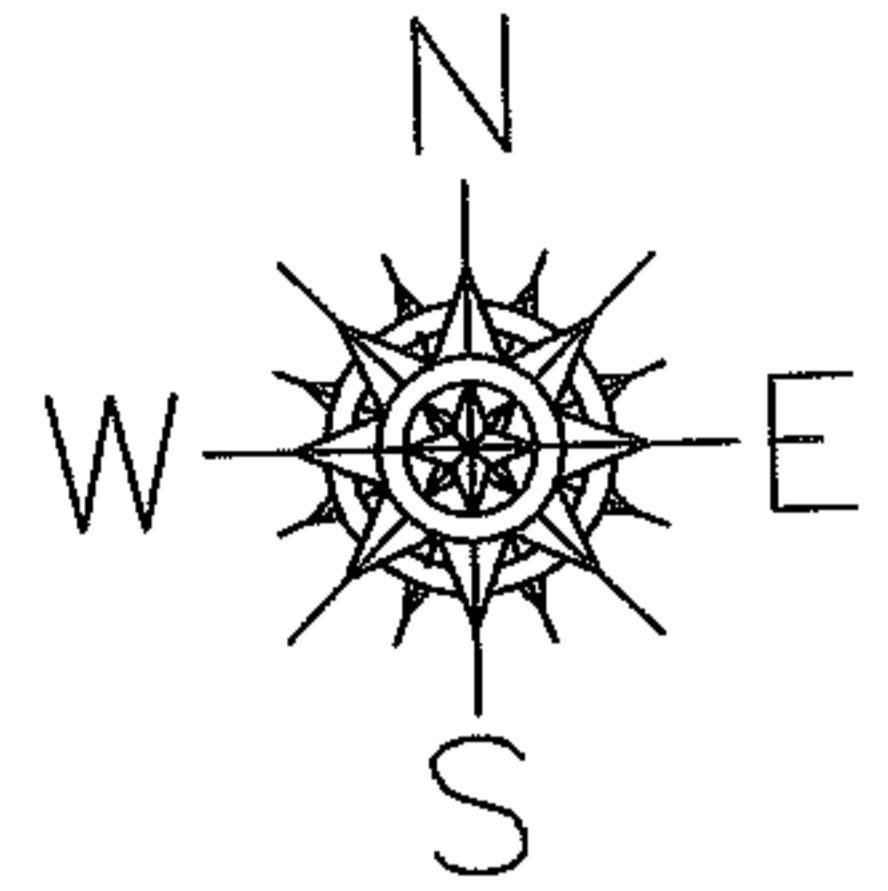

NORTH RIDGE RD

432.97

509.47

150.00

193.45

577.70

-049
1.99 A.

577.70

132.30

150.00

343.39

~~-024~~
~~5.70 A.~~
~~-050~~
~~3.71 A.~~
3.60 A.

A CORR PER SURVEY
CHARLES WARYU

708.25

CLAUS RD

SPLITS/DEEDS PROCESSED

LORAIN COUNTY TAX MAP DEPARTMENT
226 MIDDLE AVE. ELYRIA, OHIO

SURVEYED BY: CHARLES WARYU

CLOSURE: 0.00 : 10.000

MAP PAGE(S): 01-00-044-B

APPROVED BY: JAH DATE: 5-29-07

SCALE: 1" = 100 PRIOR INSTRUMENT: OR 380/215