
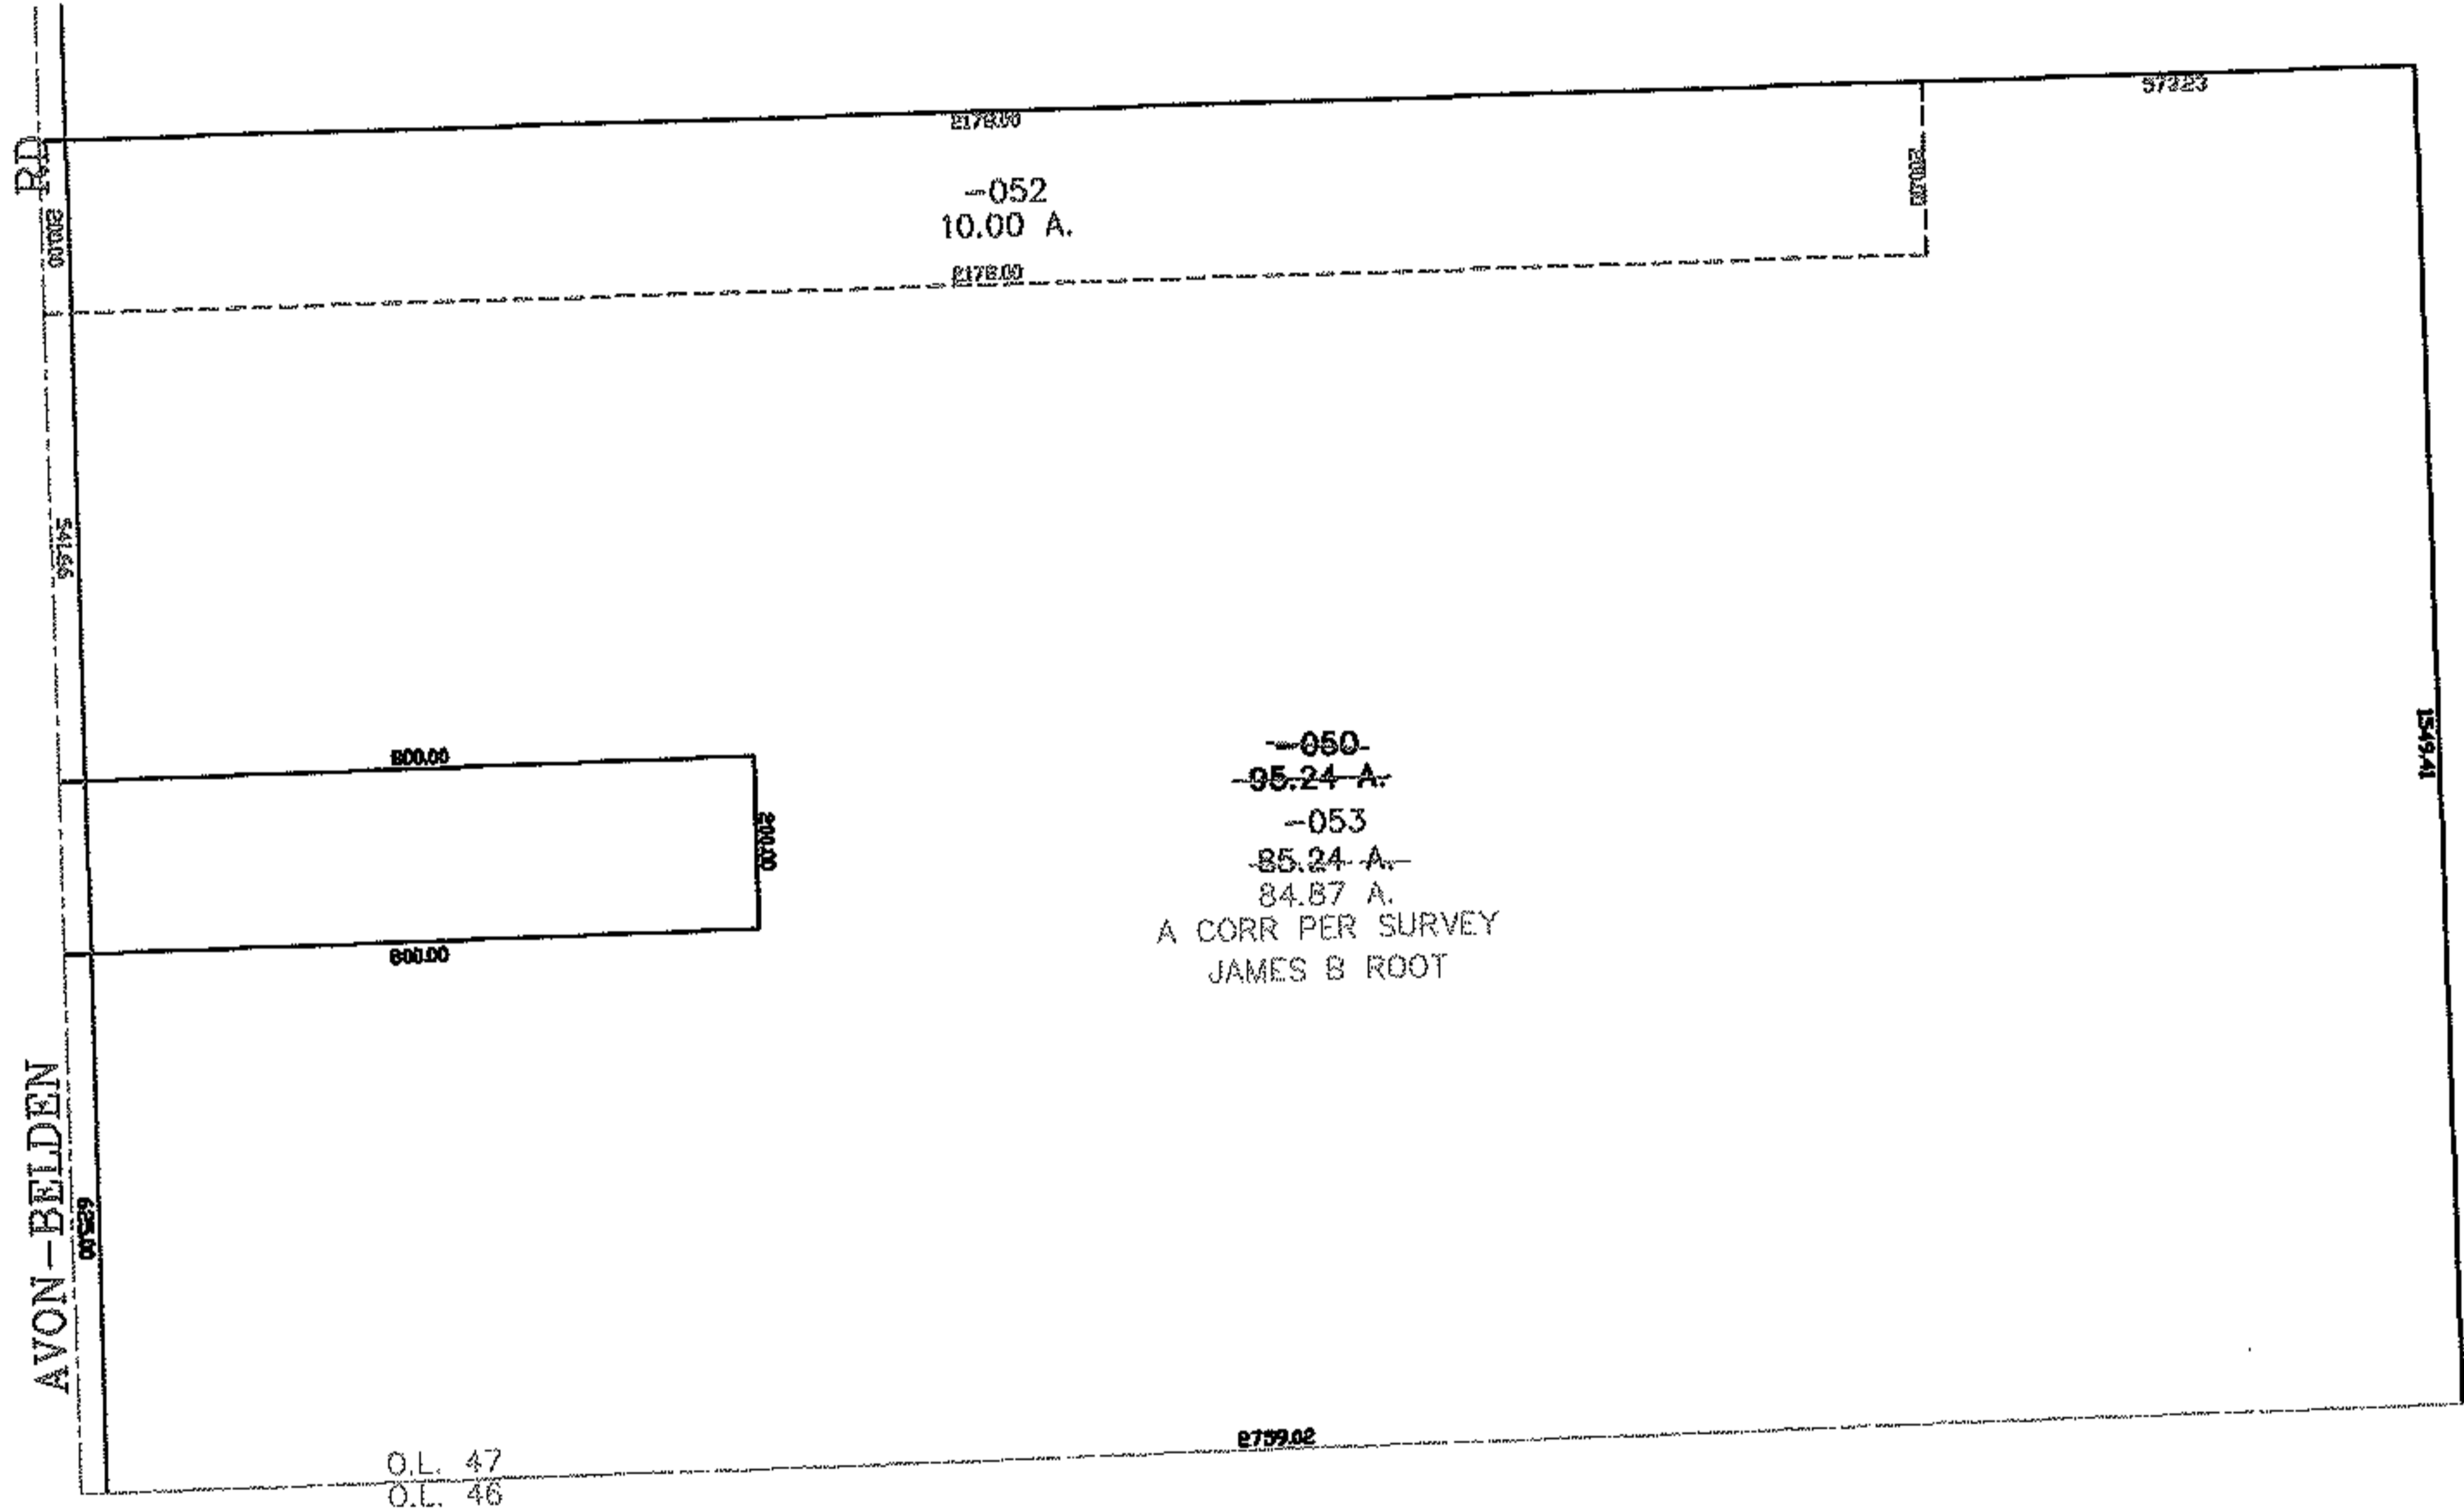


PARENT PARCEL: 11-00-047-000-050

CHILD PARCEL: 11-00-047-000-052, -053

STARTING POINT: CENTERLINE OF AVON BELDEN RD & O.L. 47

07-02381

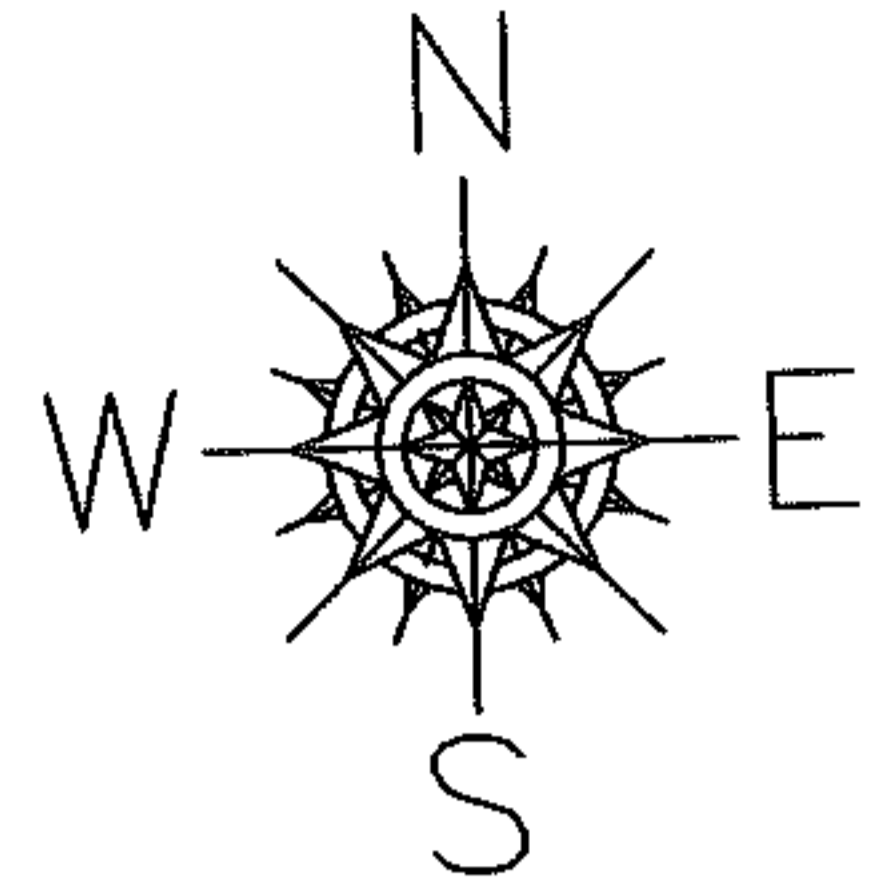

SPLITS/DEEDS PROCESSED

LORAIN COUNTY TAX MAP DEPARTMENT
226 MIDDLE AVE. ELYRIA, OHIO

SURVEYED BY: JAMES B ROOT

CLOSURE: 0.00 : 10.000

MAP PAGE(S): 11-00-047-B

APPROVED BY: JAH DATE: 5-29-07

SCALE: 1" = 400 PRIOR INSTRUMENT: 2003090555B