
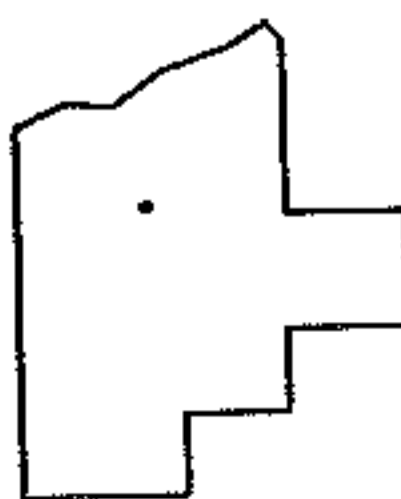
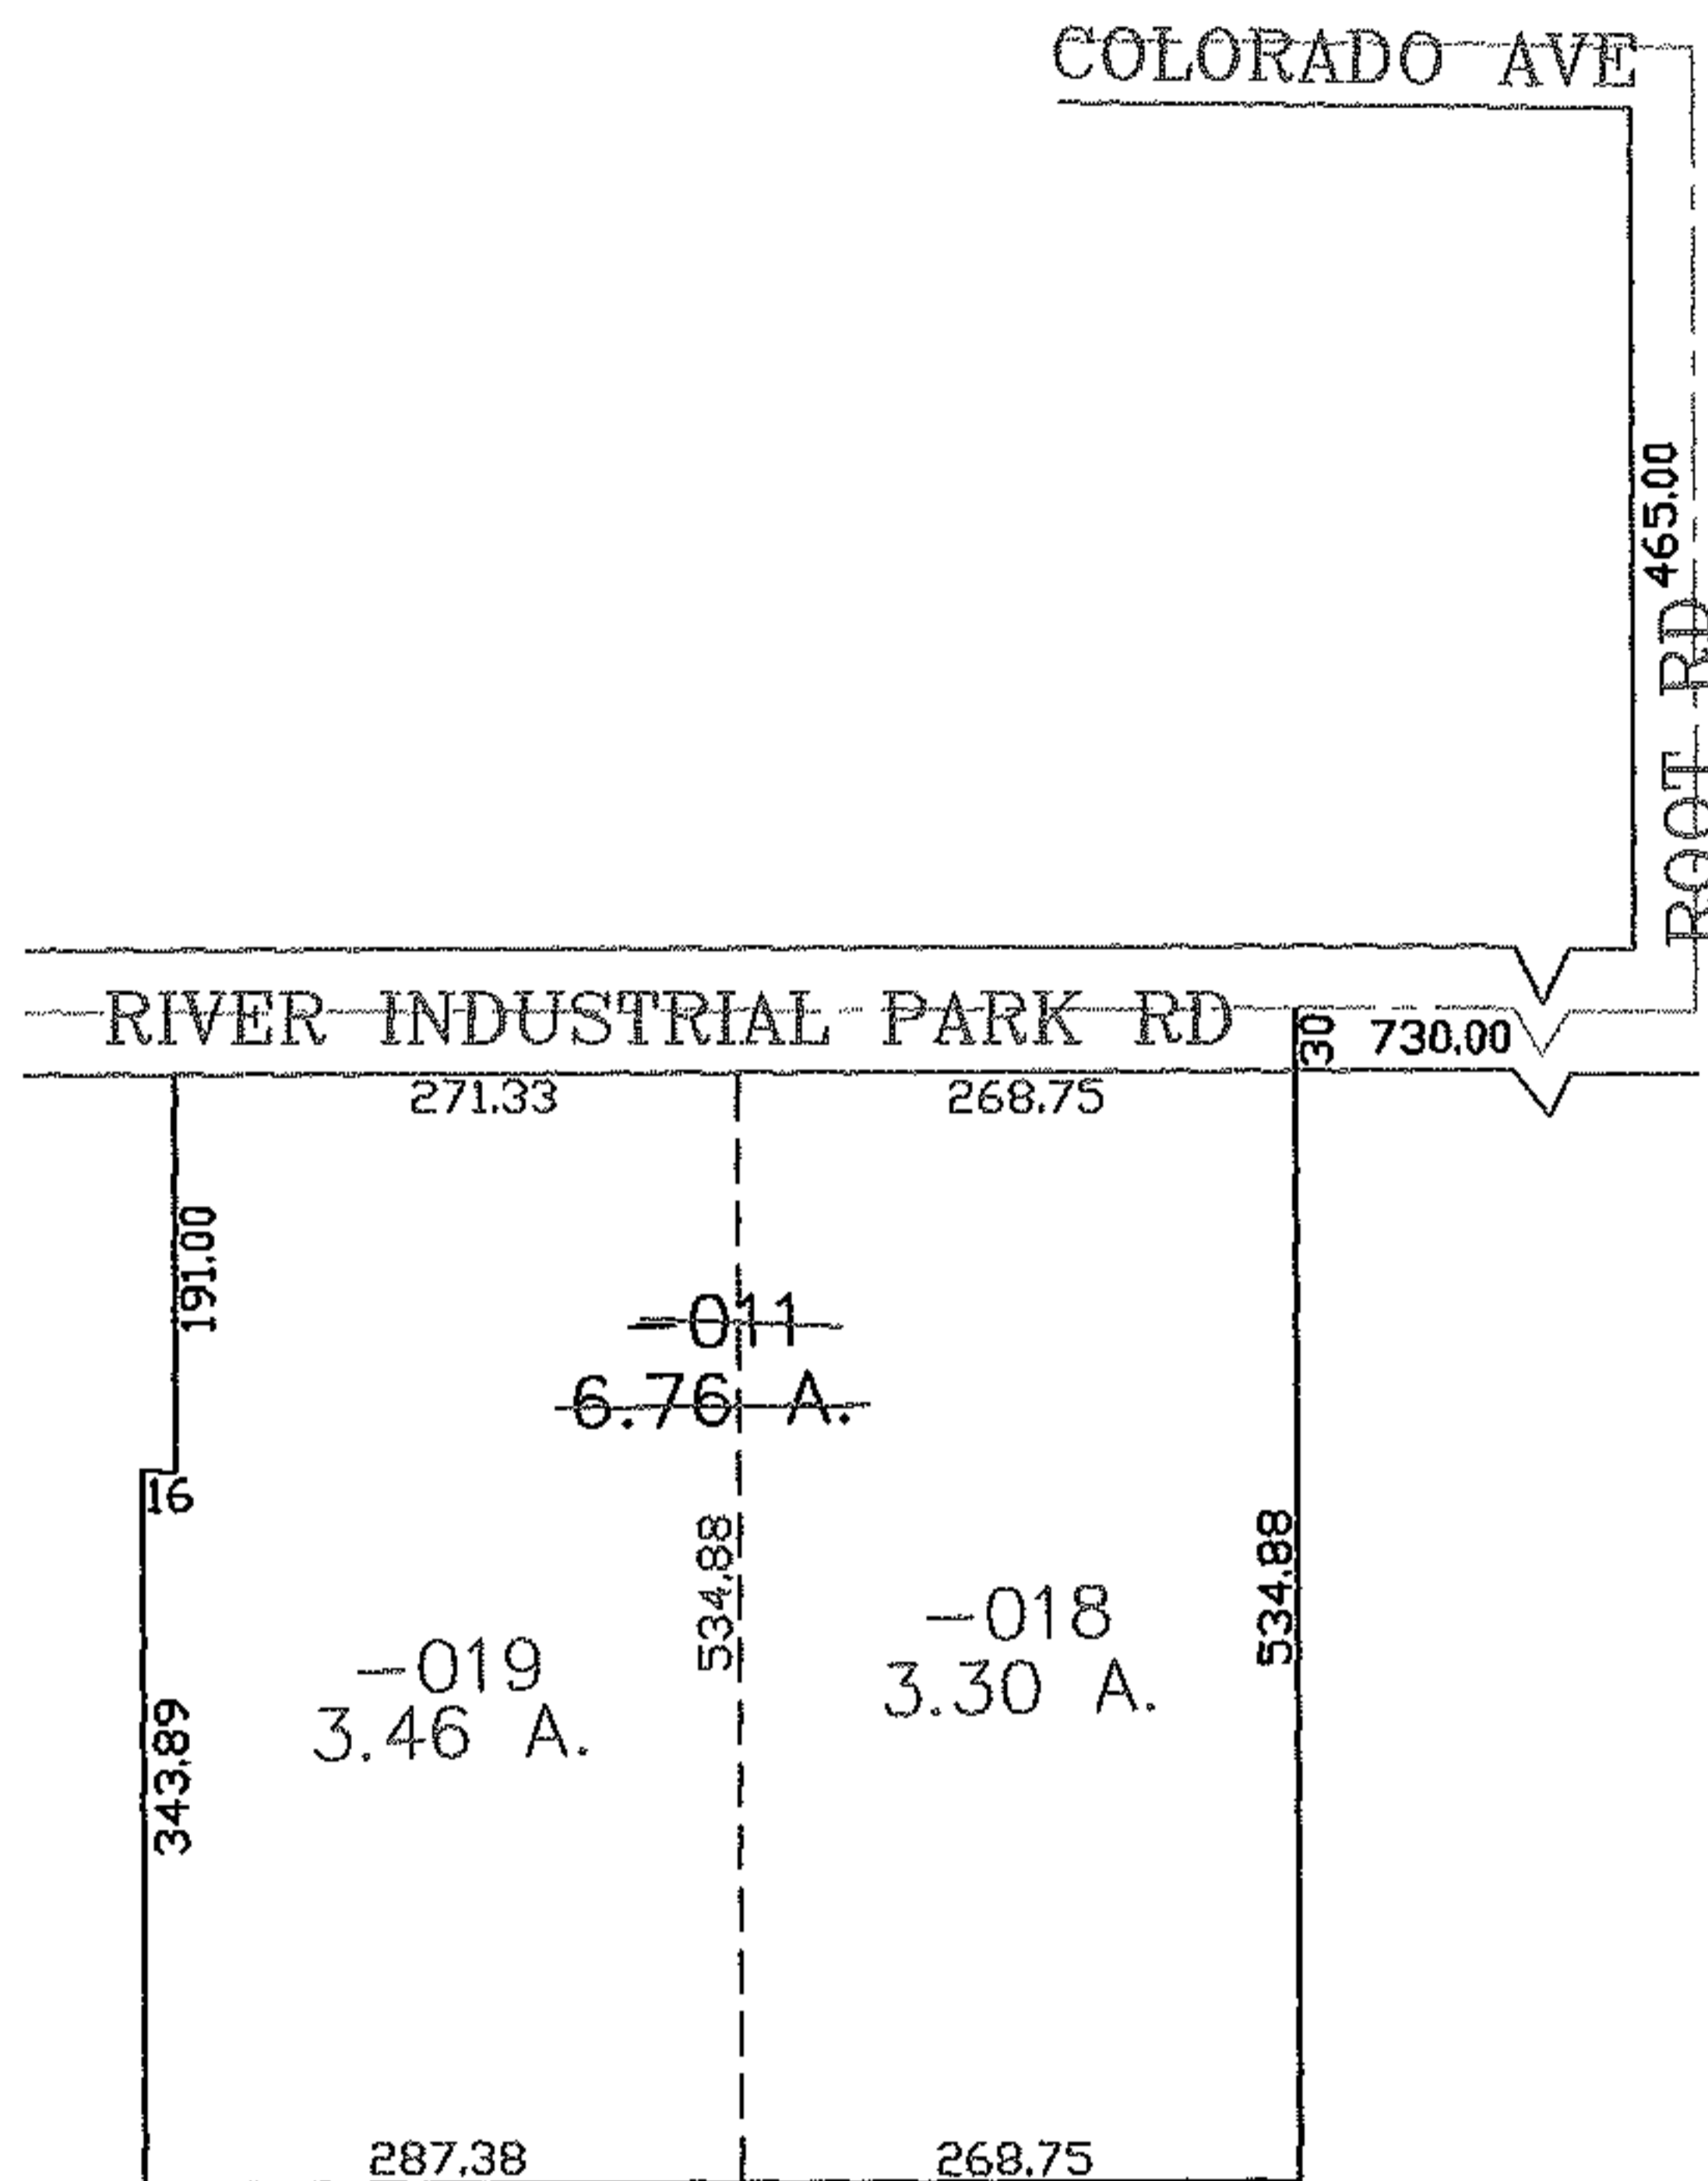


PARENT PARCEL: 03-00-057-112-011

CHILD PARCEL: 03-00-057-112-018, -019

STARTING POINT: CENTERLINE OF COLORADO AVE & ROOT RD

07-02382

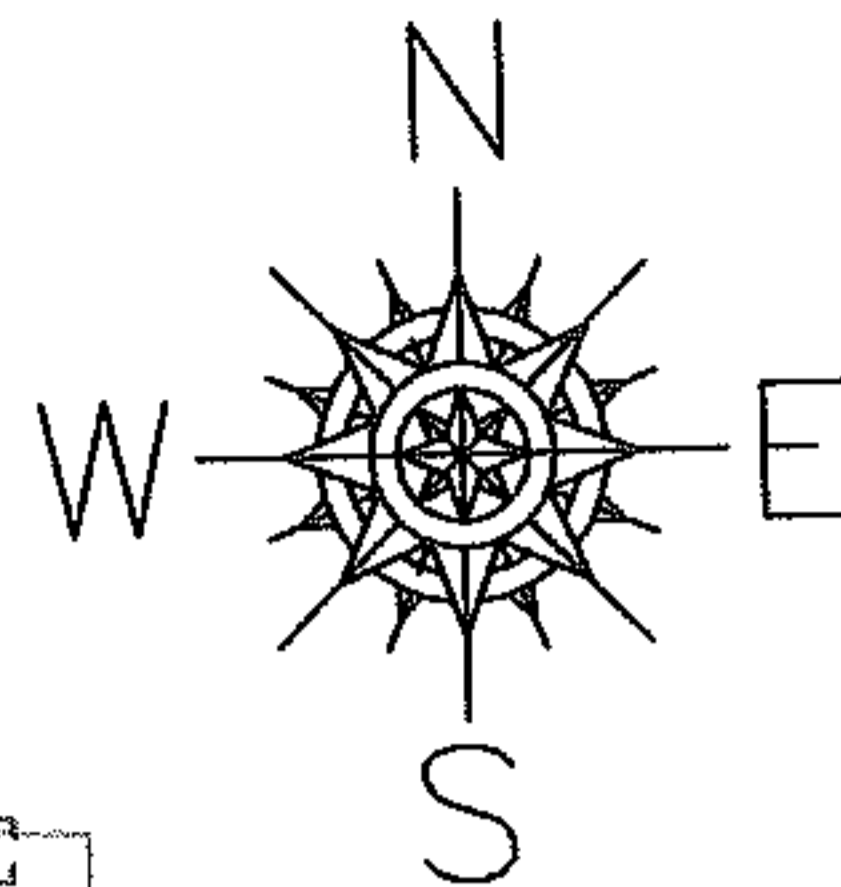

**SPLITS/DEEDS PROCESSED**

LORAIN COUNTY TAX MAP DEPARTMENT  
226 MIDDLE AVE. ELYRIA, OHIO

SURVEYED BY: THOMAS SIMON

CLOSURE: 0.00 : 10,000

MAP PAGE(S): 03-00-057-B

APPROVED BY: JAH DATE: 5-31-07

SCALE: 1" = 200 PRIOR INSTRUMENT: PL VOL 62/13