



ROSTER

PARENT PARCEL: 18-00-022-103-014

11-02385-C

CHILD PARCEL: _____

STARTING POINT: INTERSECTION OF THE NORTH LINE OF DICKSON ST. AND EAST LINE OF FORREST ST.

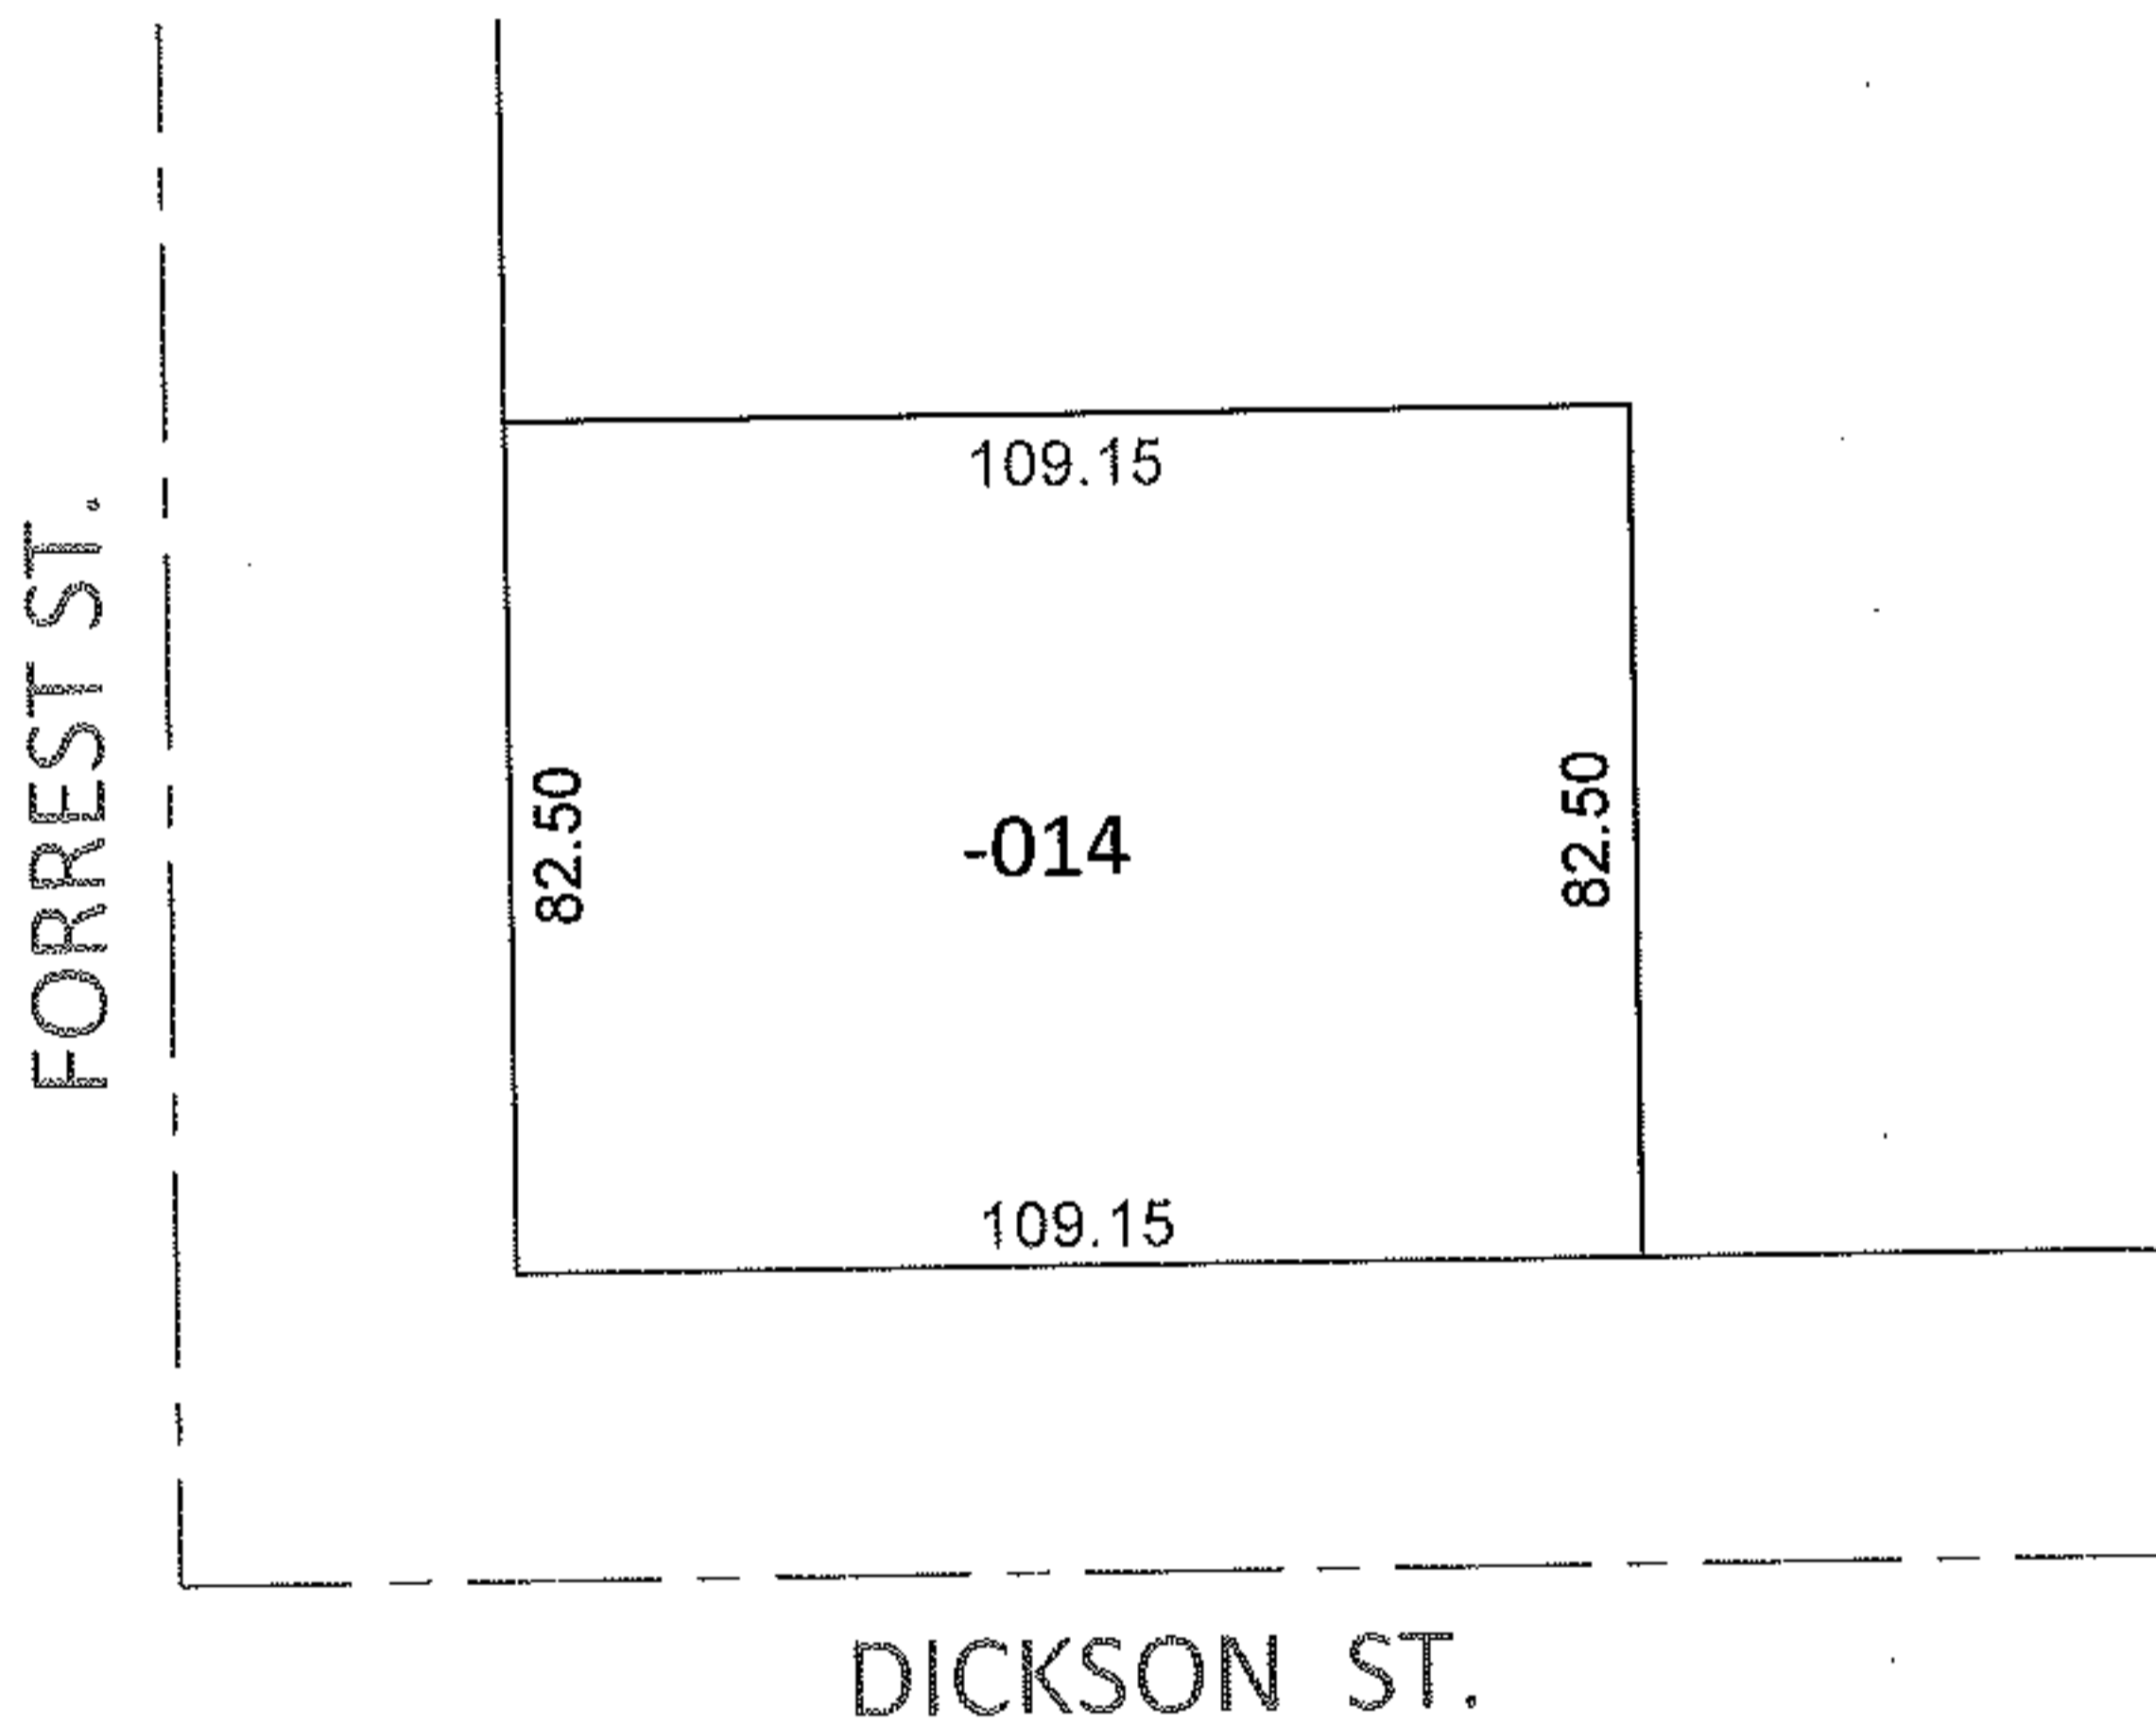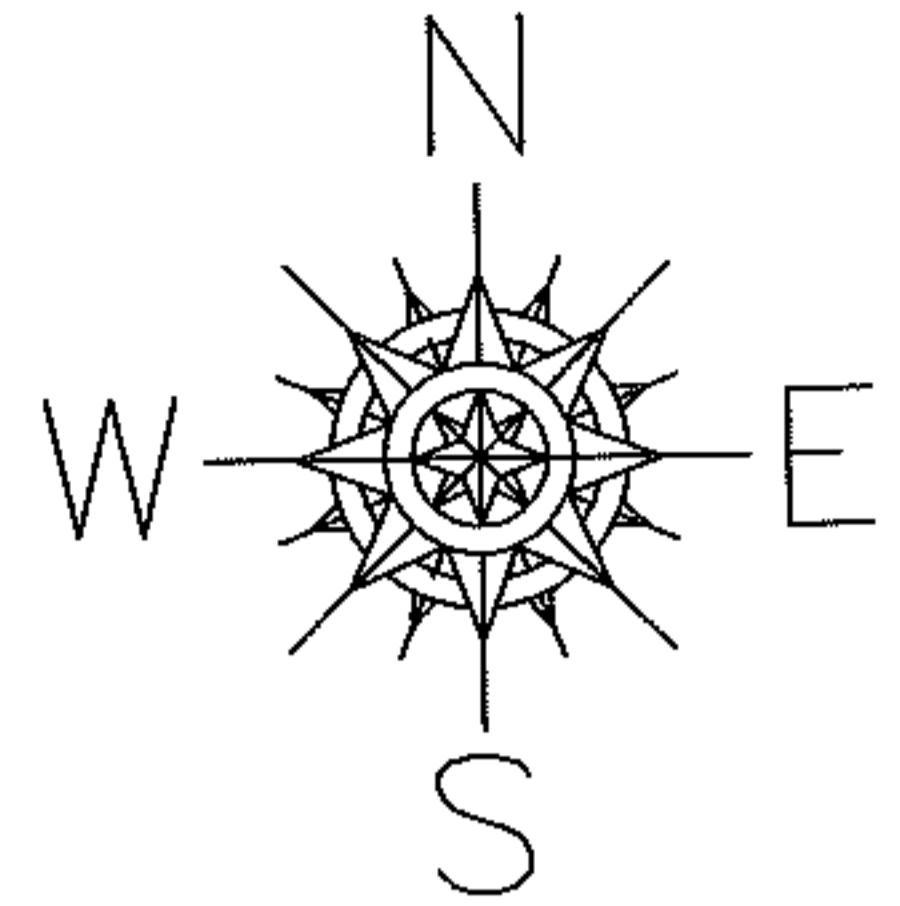


FRONTAGE & DEPTH CORRECTION

18-00-022-103-014

82.50 X 109.15

~~82 X 109~~

PER PRIOR DEEDS

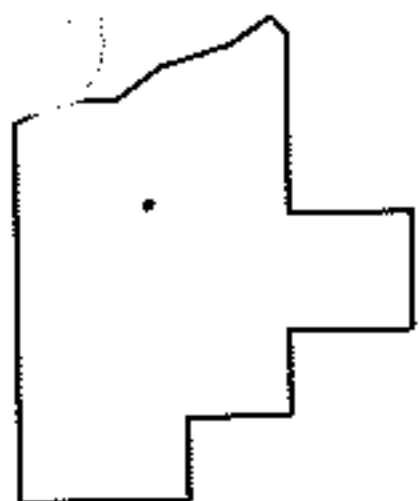

SPLITS/DEEDS PROCESSED

LORAIN COUNTY TAX MAP DEPARTMENT
226 MIDDLE AVE. ELYRIA, OHIO

SURVEYED BY: N/A

CLOSURE: N/A

MAP PAGE(S): 18-00-022-A

APPROVED BY: RRM DATE: 11-7-11

SCALE: 1"= 50' PRIOR INST.: 20100344046