


ROSTER

PARENT PARCEL: 15-00-052-000-078



11-02388-A

CHILD PARCEL:

STARTING POINT: INTERSECTION OF C/L OF S.R. 303 AND C/L OF VERMONT ST.

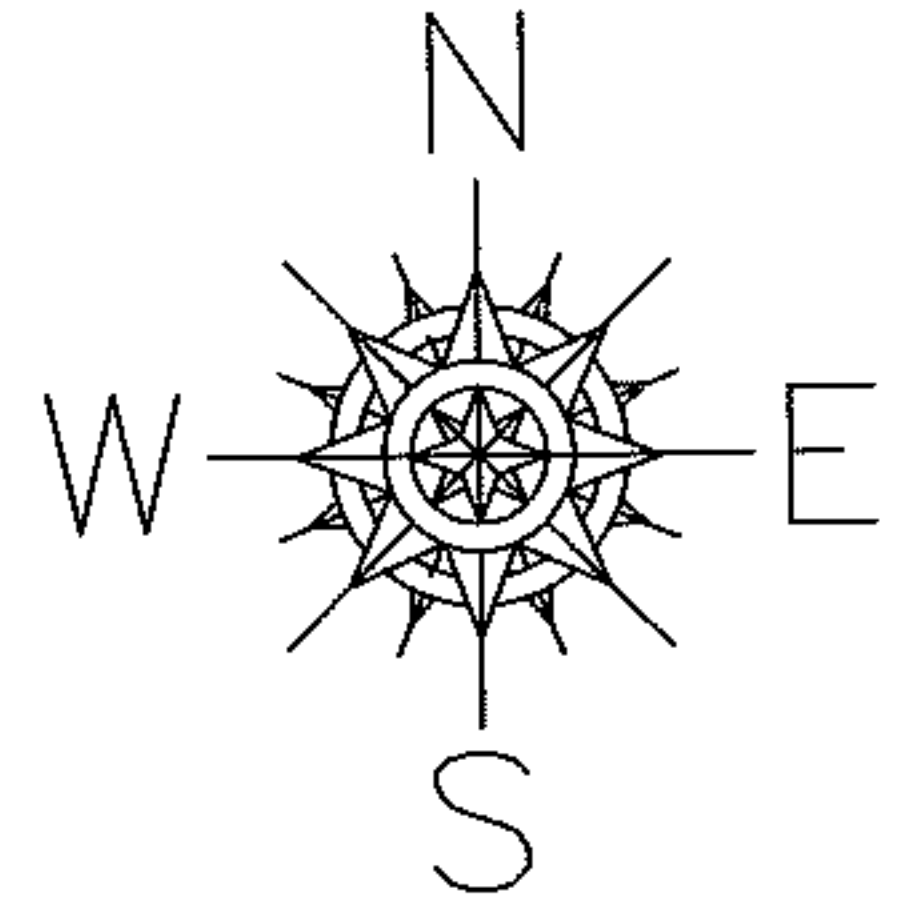

WAKEMAN - BELDEN RD. (S.R. 303)

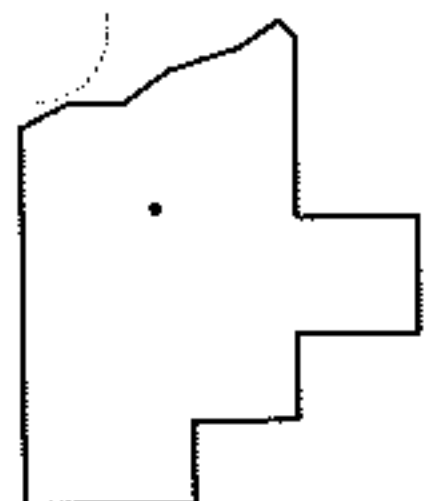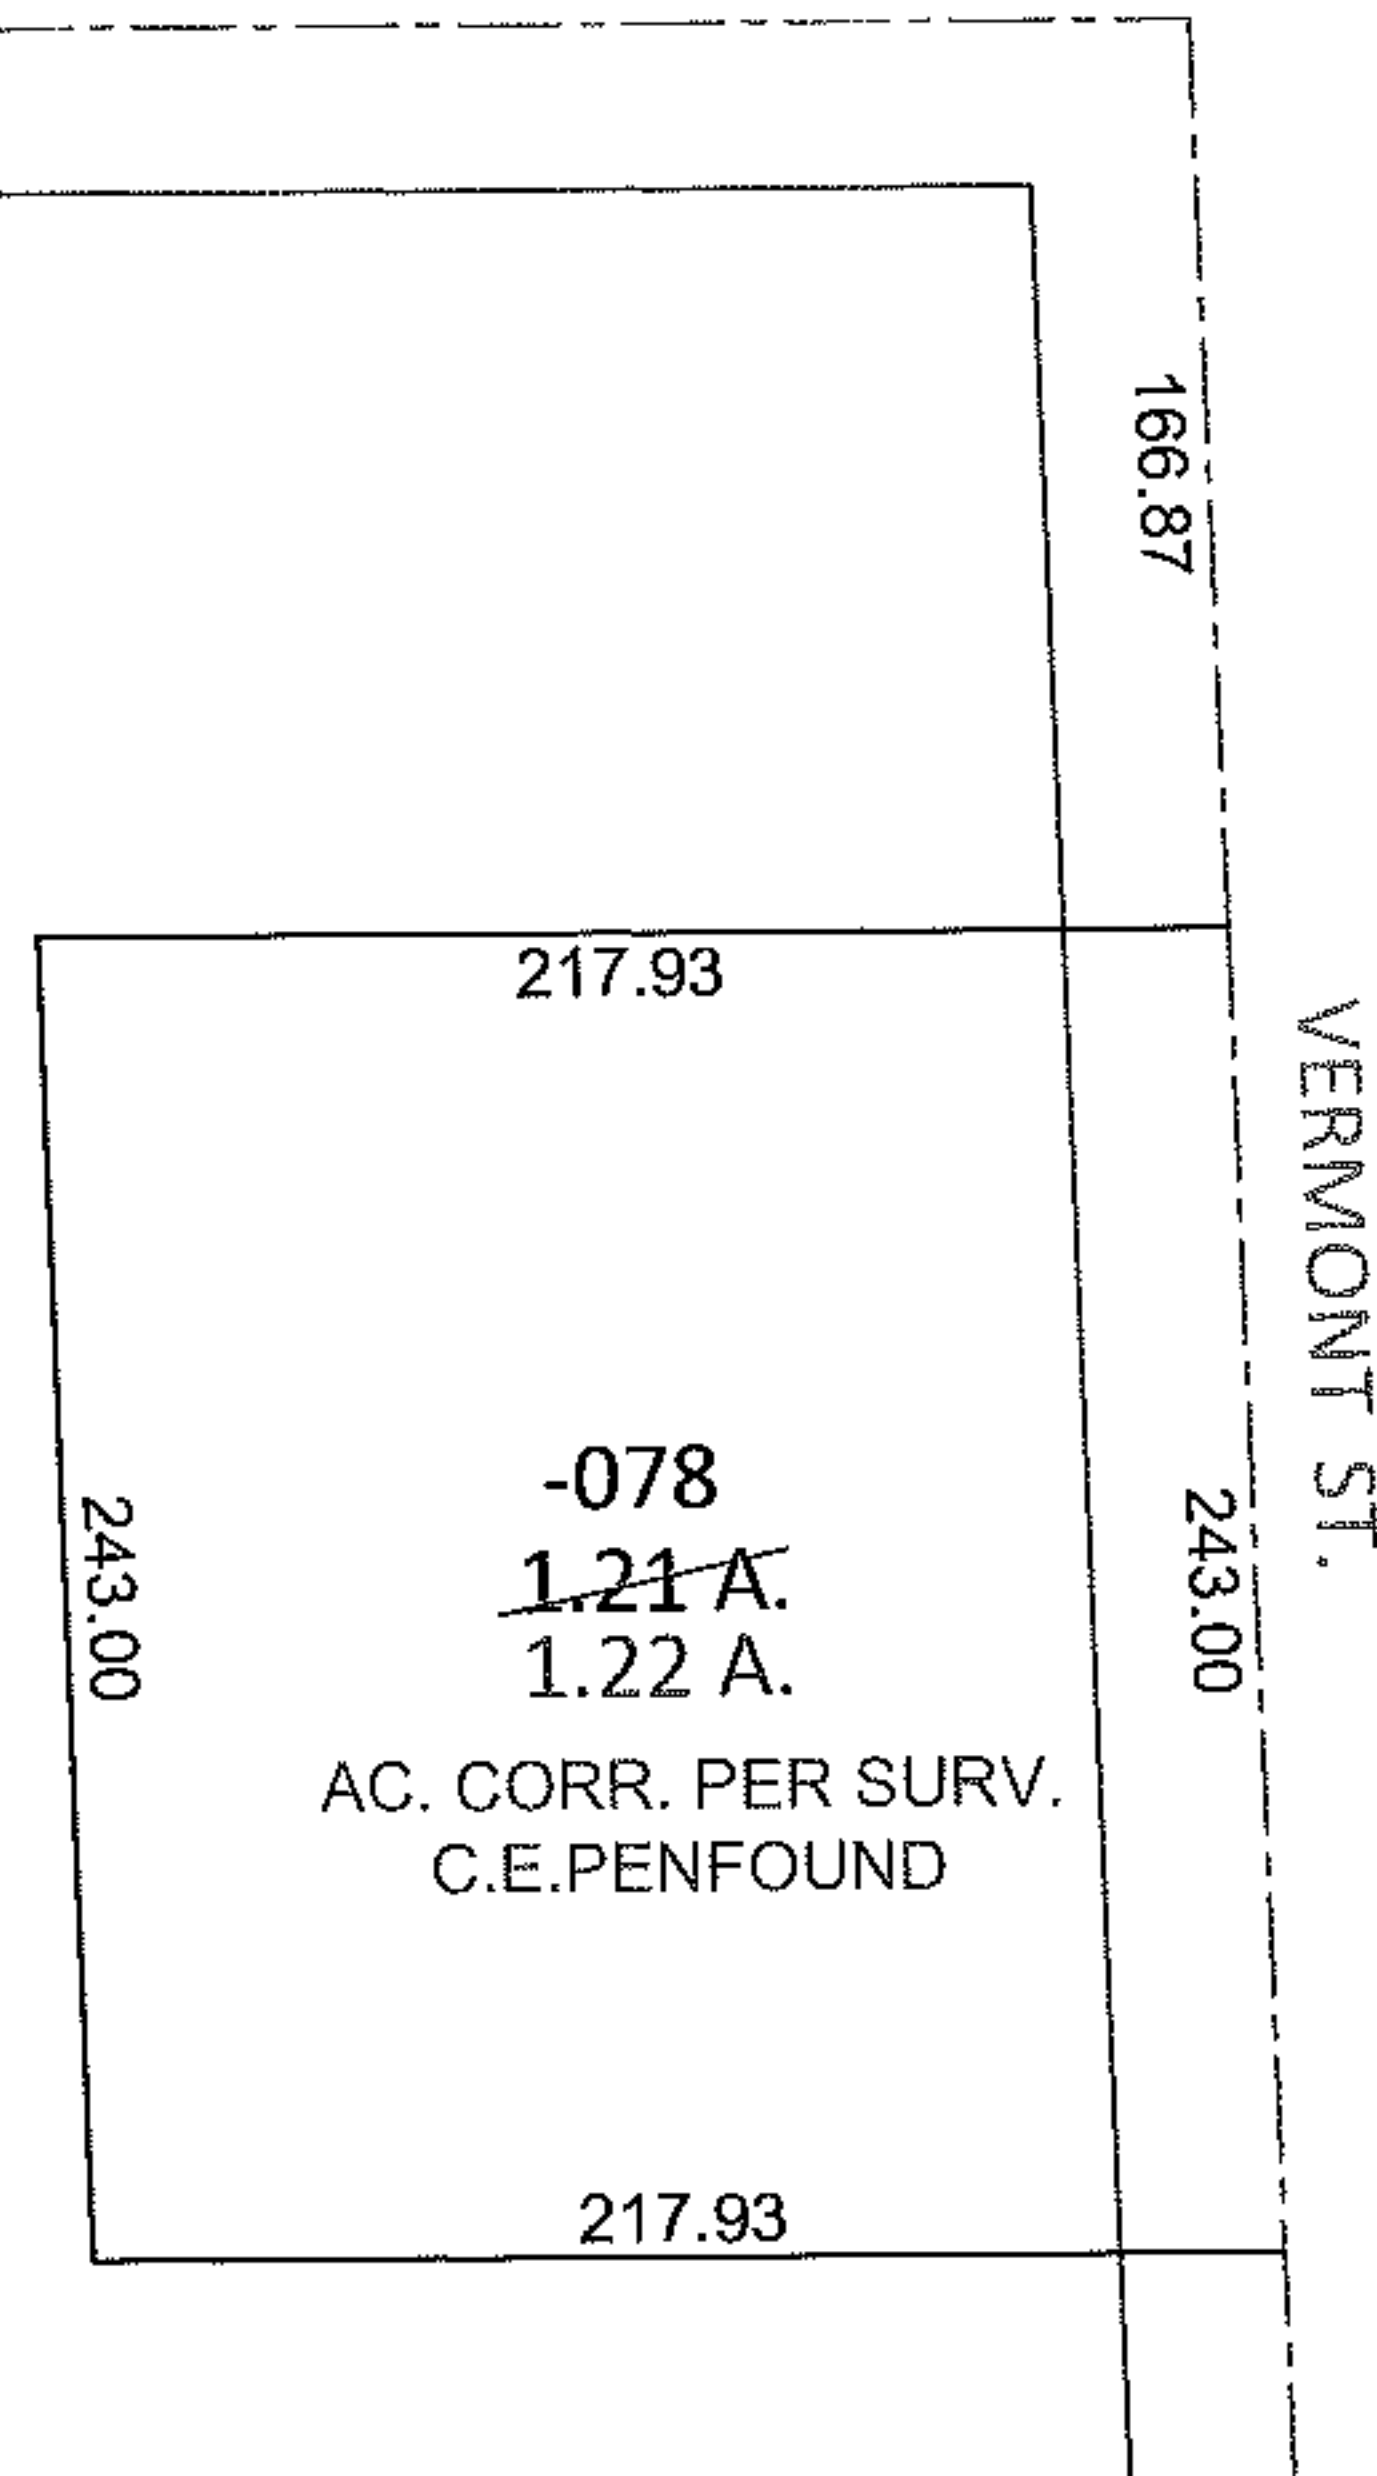

**SPLITS/DEEDS PROCESSED**

LORAIN COUNTY TAX MAP DEPARTMENT  
226 MIDDLE AVE. ELYRIA, OHIO

SURVEYED BY: C.E. PENFOUND

CLOSURE: .00:10,000

MAP PAGE(S): 15-H

APPROVED BY: RRM DATE: 11-8-11

SCALE: 1"= 100 PRIOR INST.: 20090306708