



RASTER

PARENT PARCEL: 02-01-003-193-006, -007

11-02390-C

CHILD PARCEL: _____

STARTING POINT: S/L 21 & 22 IN W.A. BRAMAN'S TRUSTEE'S PLAT (VOL. 3 PG. 41)

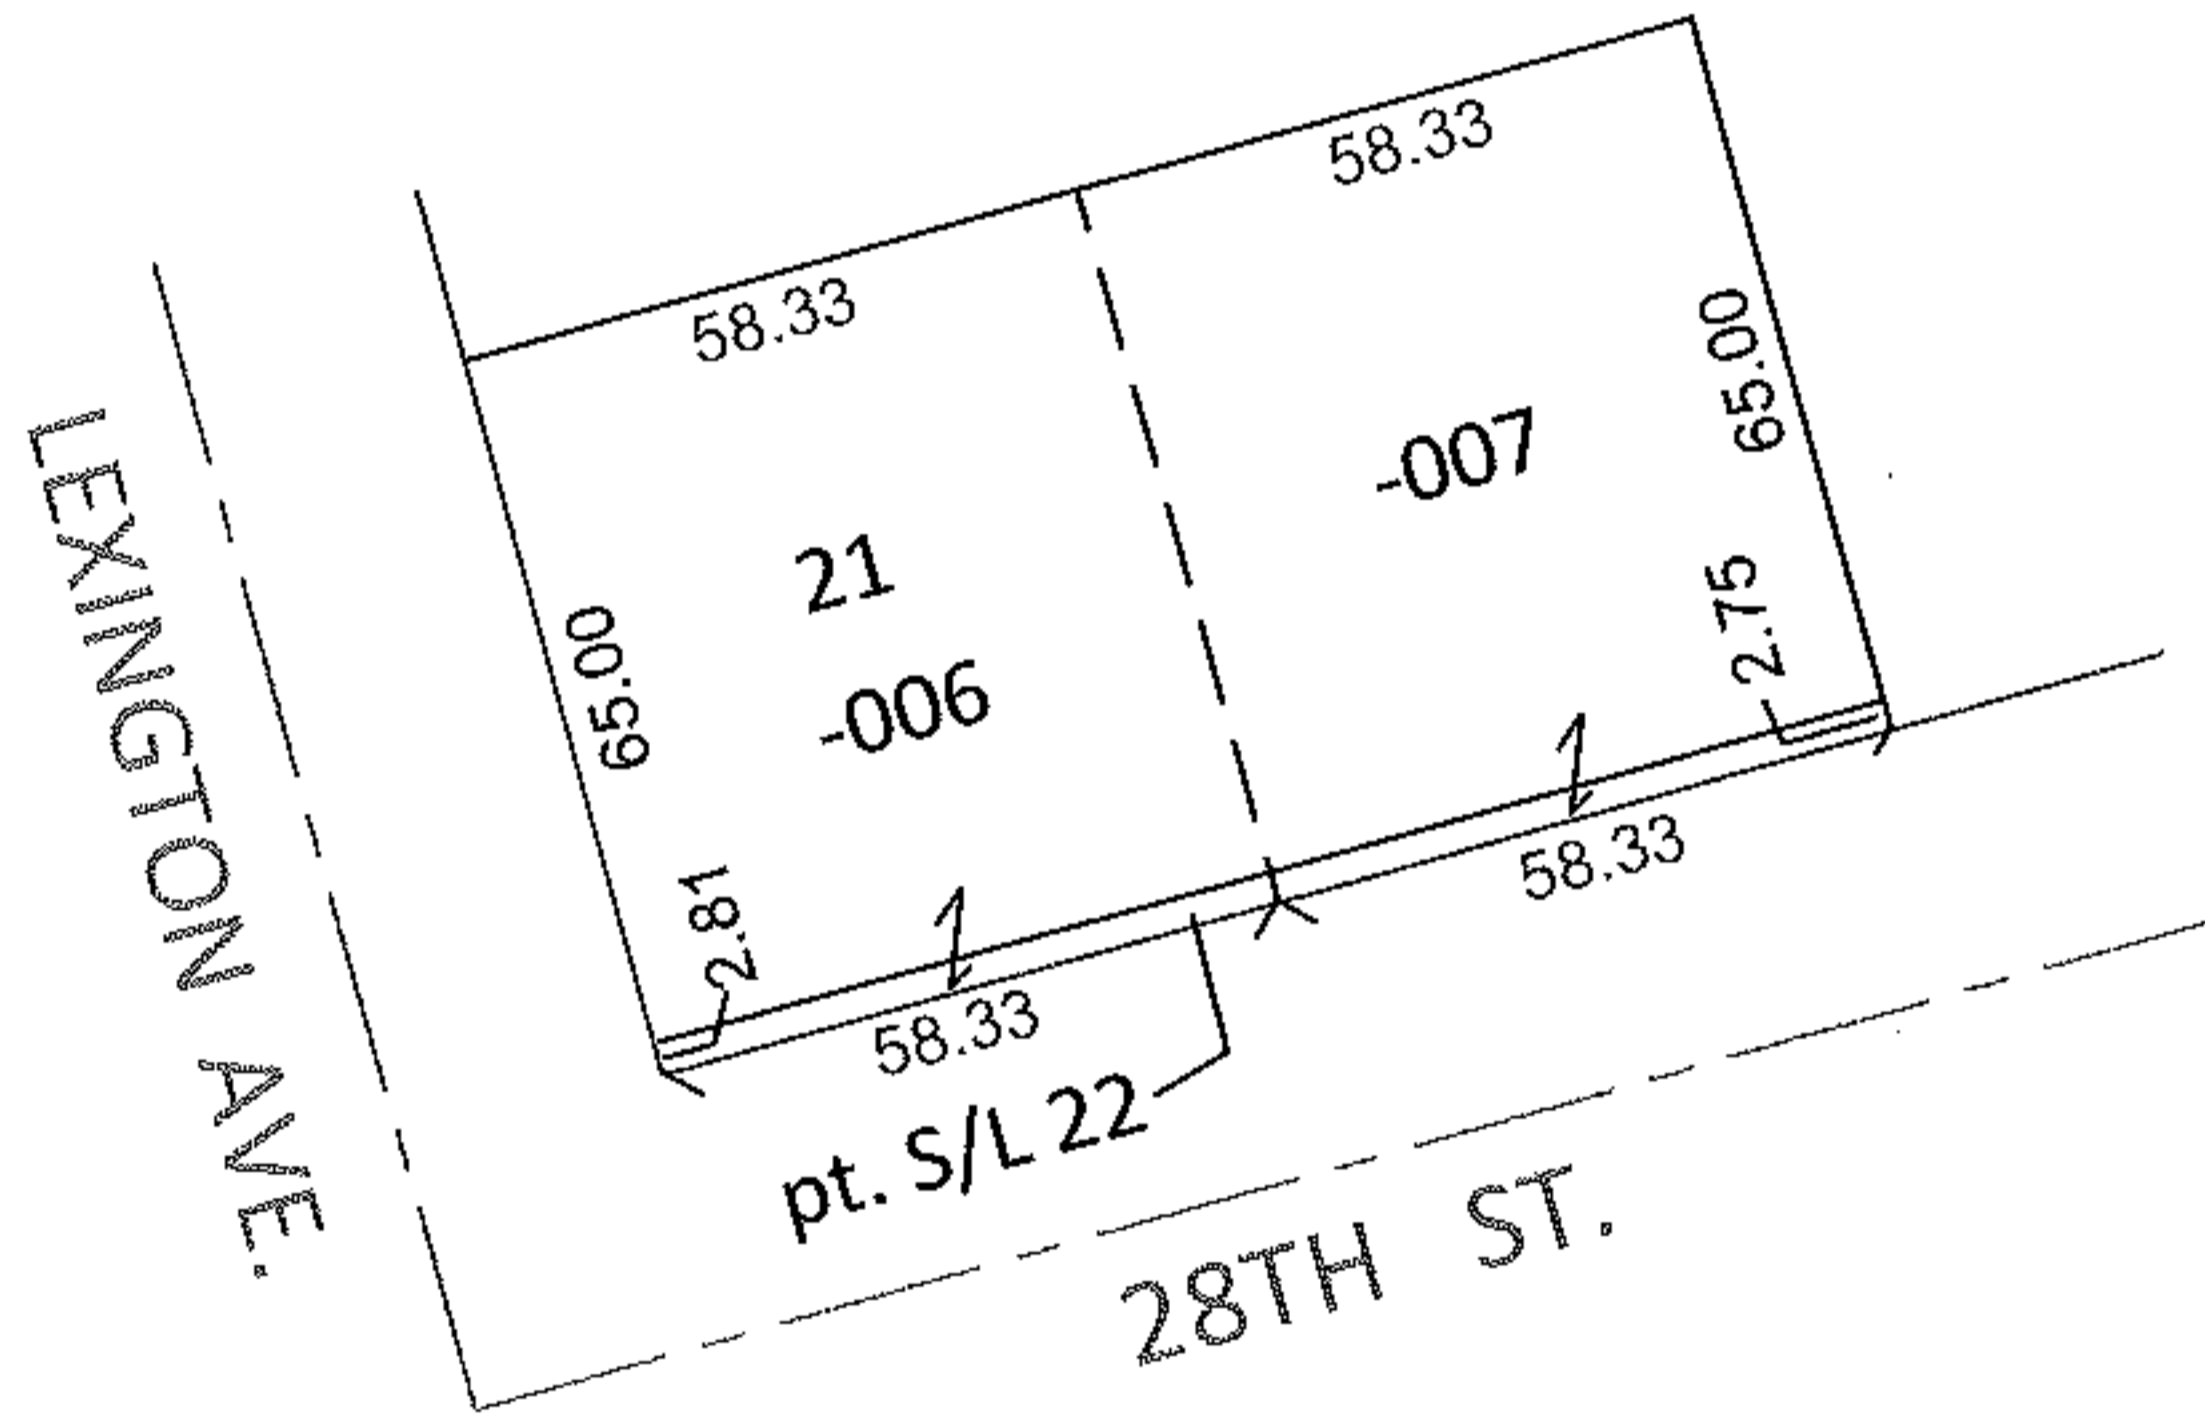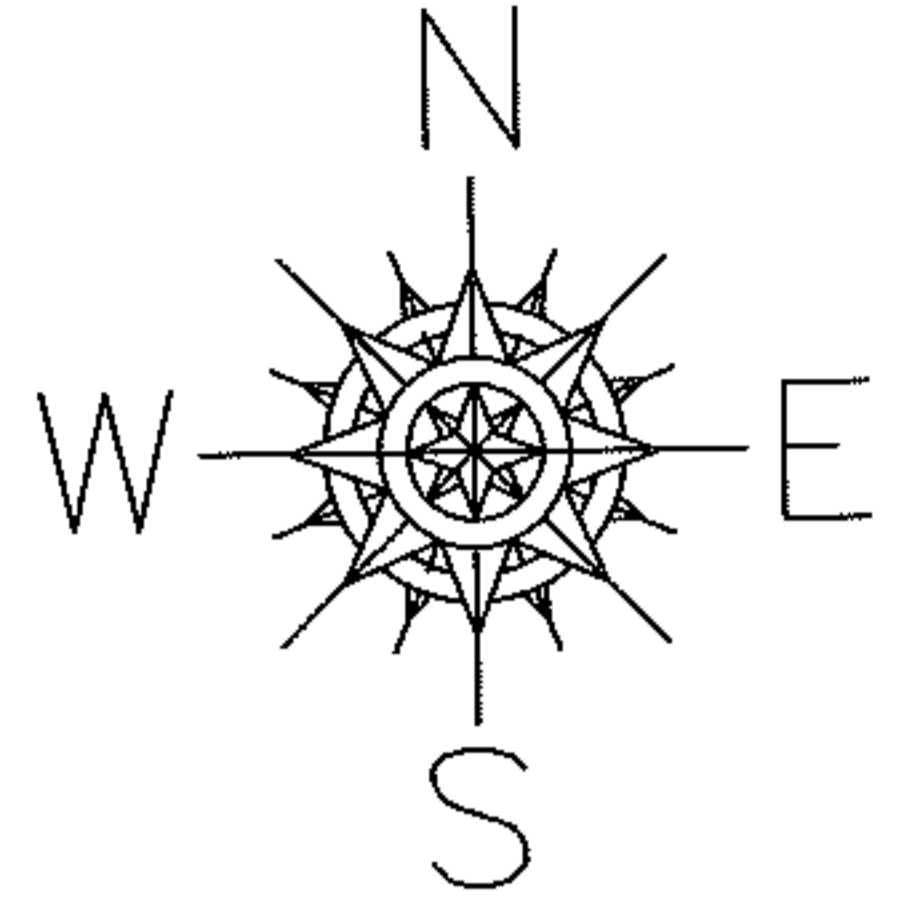

FRONTAGE AND DEPTH CORRECTION


02-01-003-193-006

02-01-003-193-007

58.33
~~58 X 67.81~~

58.33 X 67.75
~~65 X 58 X 2.81 X 58~~

PER PRIOR DEEDS

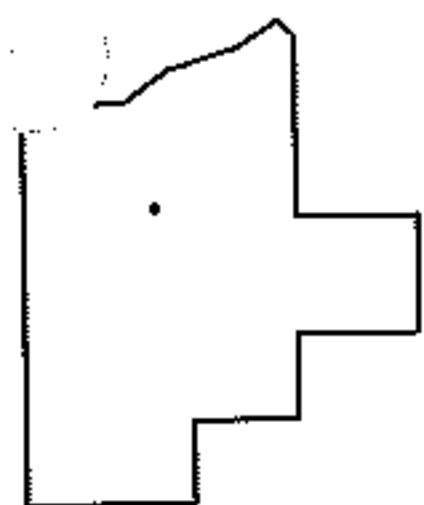

SPLITS/DEEDS PROCESSED

LORAIN COUNTY TAX MAP DEPARTMENT
226 MIDDLE AVE. ELYRIA, OHIO

SURVEYED BY: N/A

CLOSURE: N/A

MAP PAGE(S): 2-01-003-G

APPROVED BY: RRM DATE: 11-14-11

SCALE: 1"= 50' PRIOR INST.: OR 330/710