



MASTER

PARENT PARCEL: 18-00-029-000-104

CHILD PARCEL: 18-00-029-000-106, -107

STARTING POINT: CENTERLINE OF HERITAGE DR & PATRIOT DR

07-02391

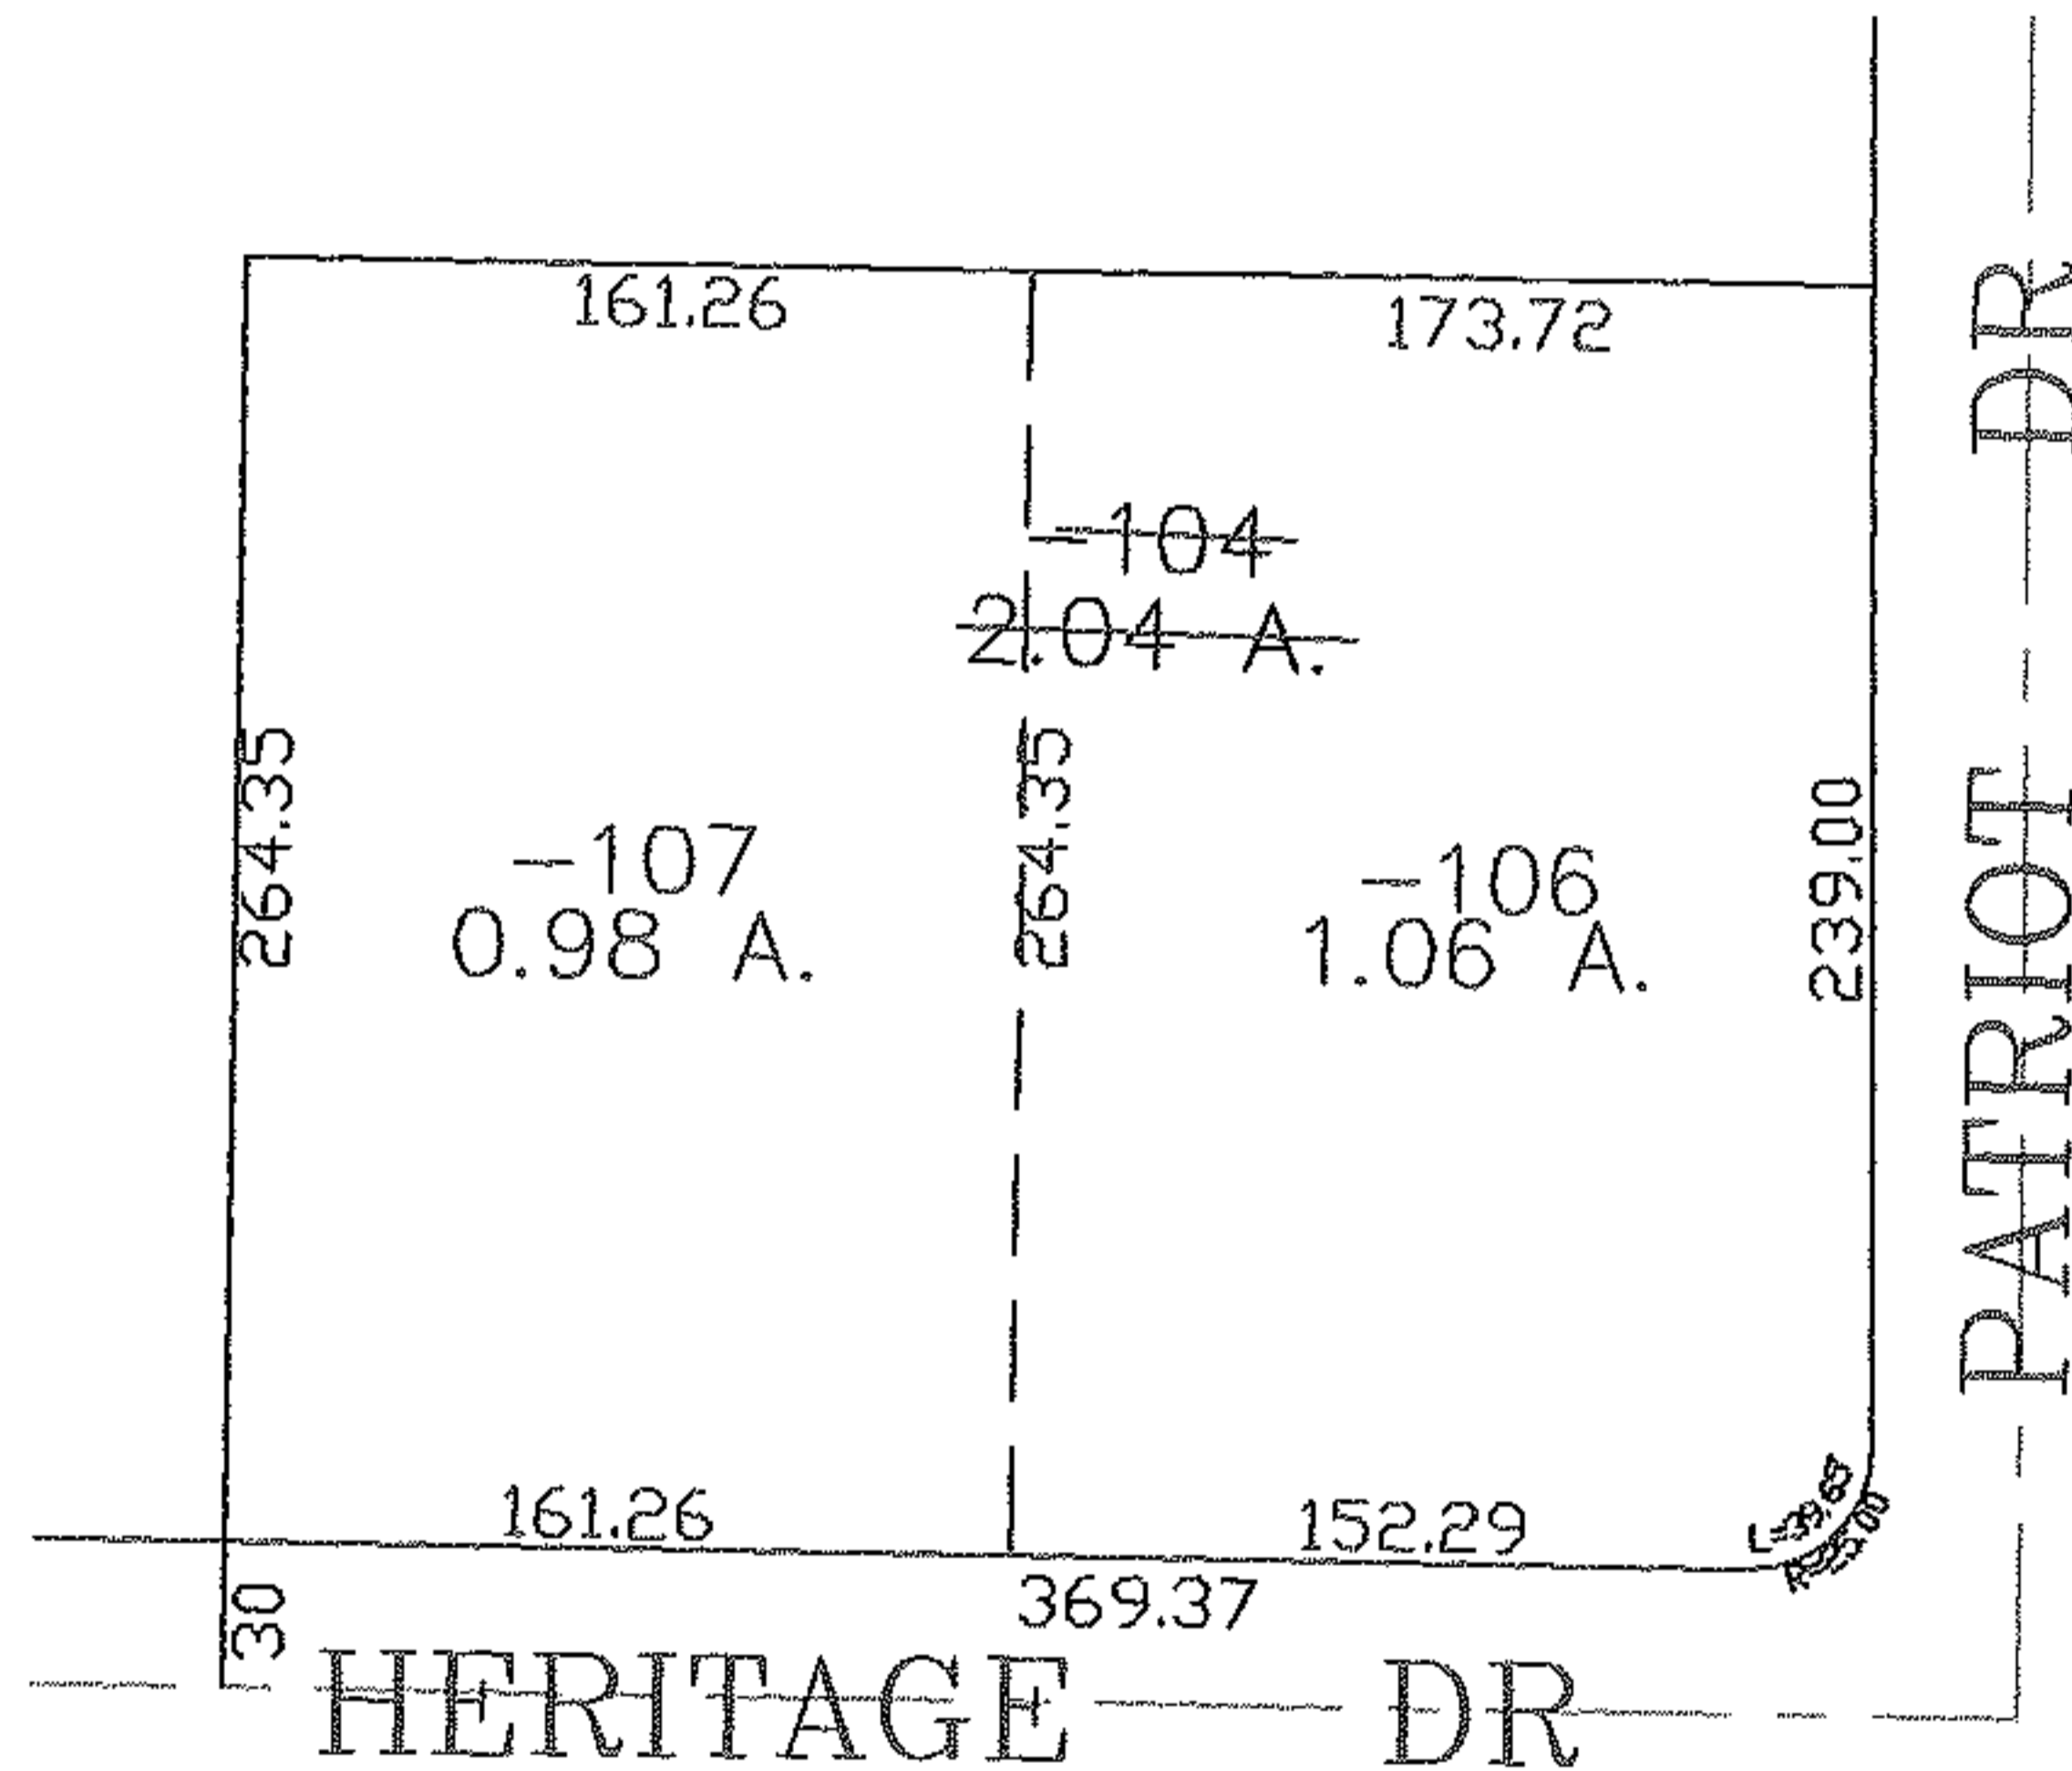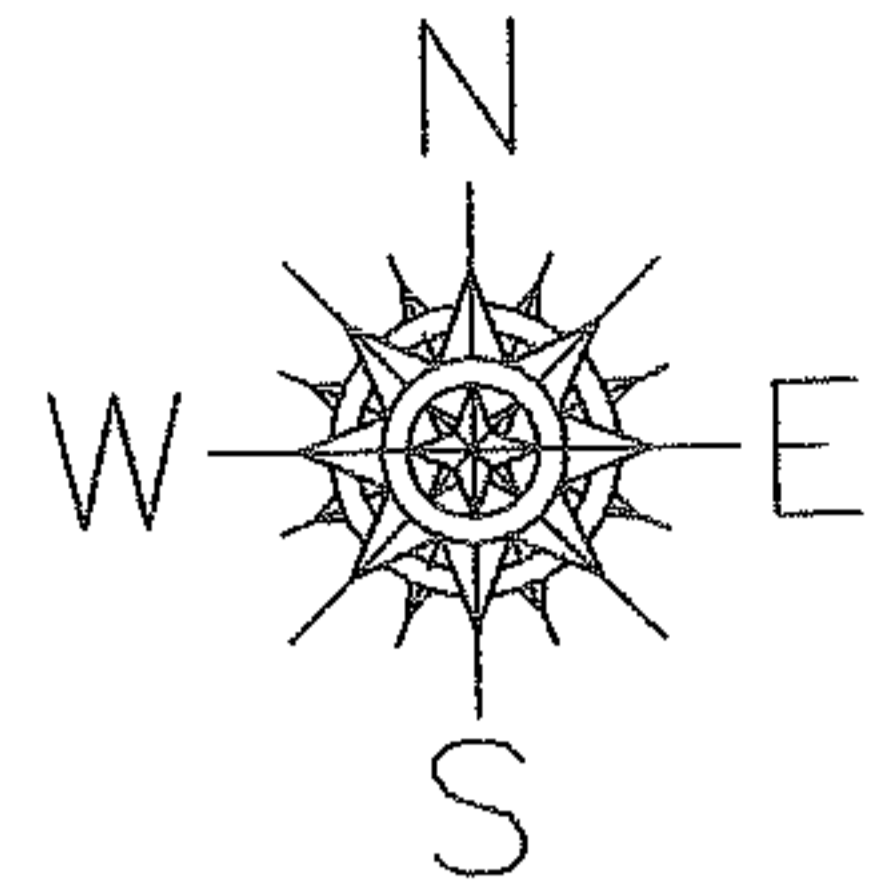

SPLITS/DEEDS PROCESSED

LORAIN COUNTY TAX MAP DEPARTMENT
226 MIDDLE AVE. ELYRIA, OHIO

SURVEYED BY: H. DAVID LAURILA

CLOSURE: 0.00 : 10.000

MAP PAGE(S): 18-00-029-D

APPROVED BY: JAH DATE: 6-11-07

SCALE: 1" = 100 PRIOR INSTRUMENT: 20060173348