


RASTER

07-02392


PARENT PARCEL: 04-00-030-125-028

CHILD PARCEL: 04-00-030-125-037, -038

STARTING POINT: SIDELINE OF CLIFTON DR & FOREST BLVD

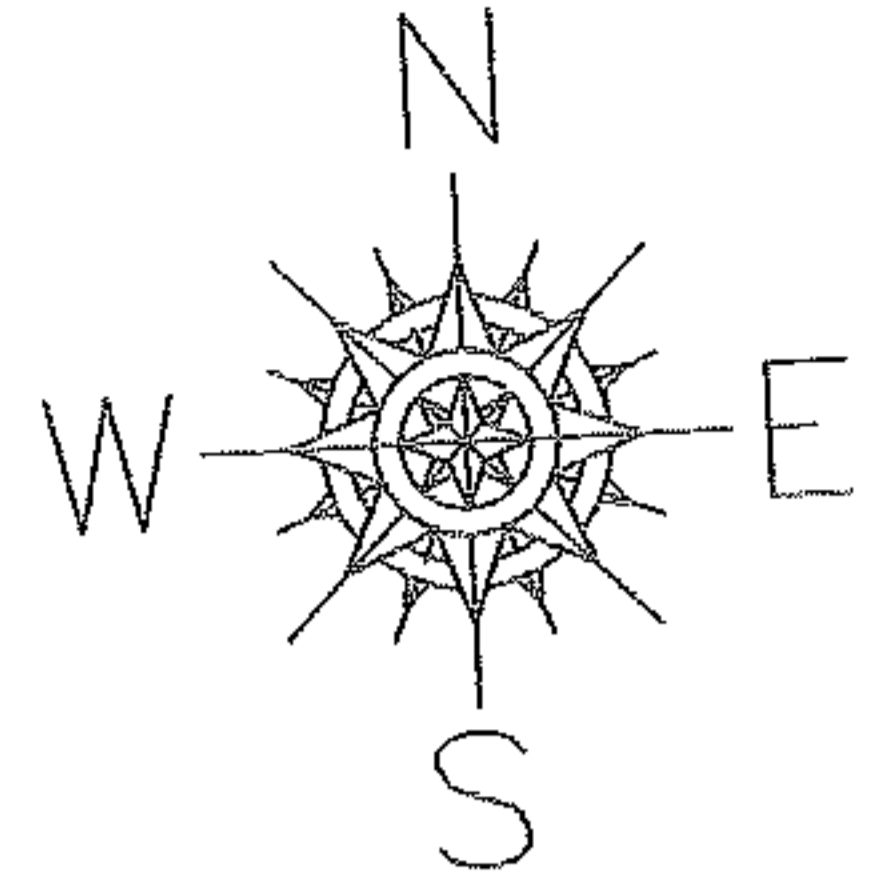

CLIFTON DR

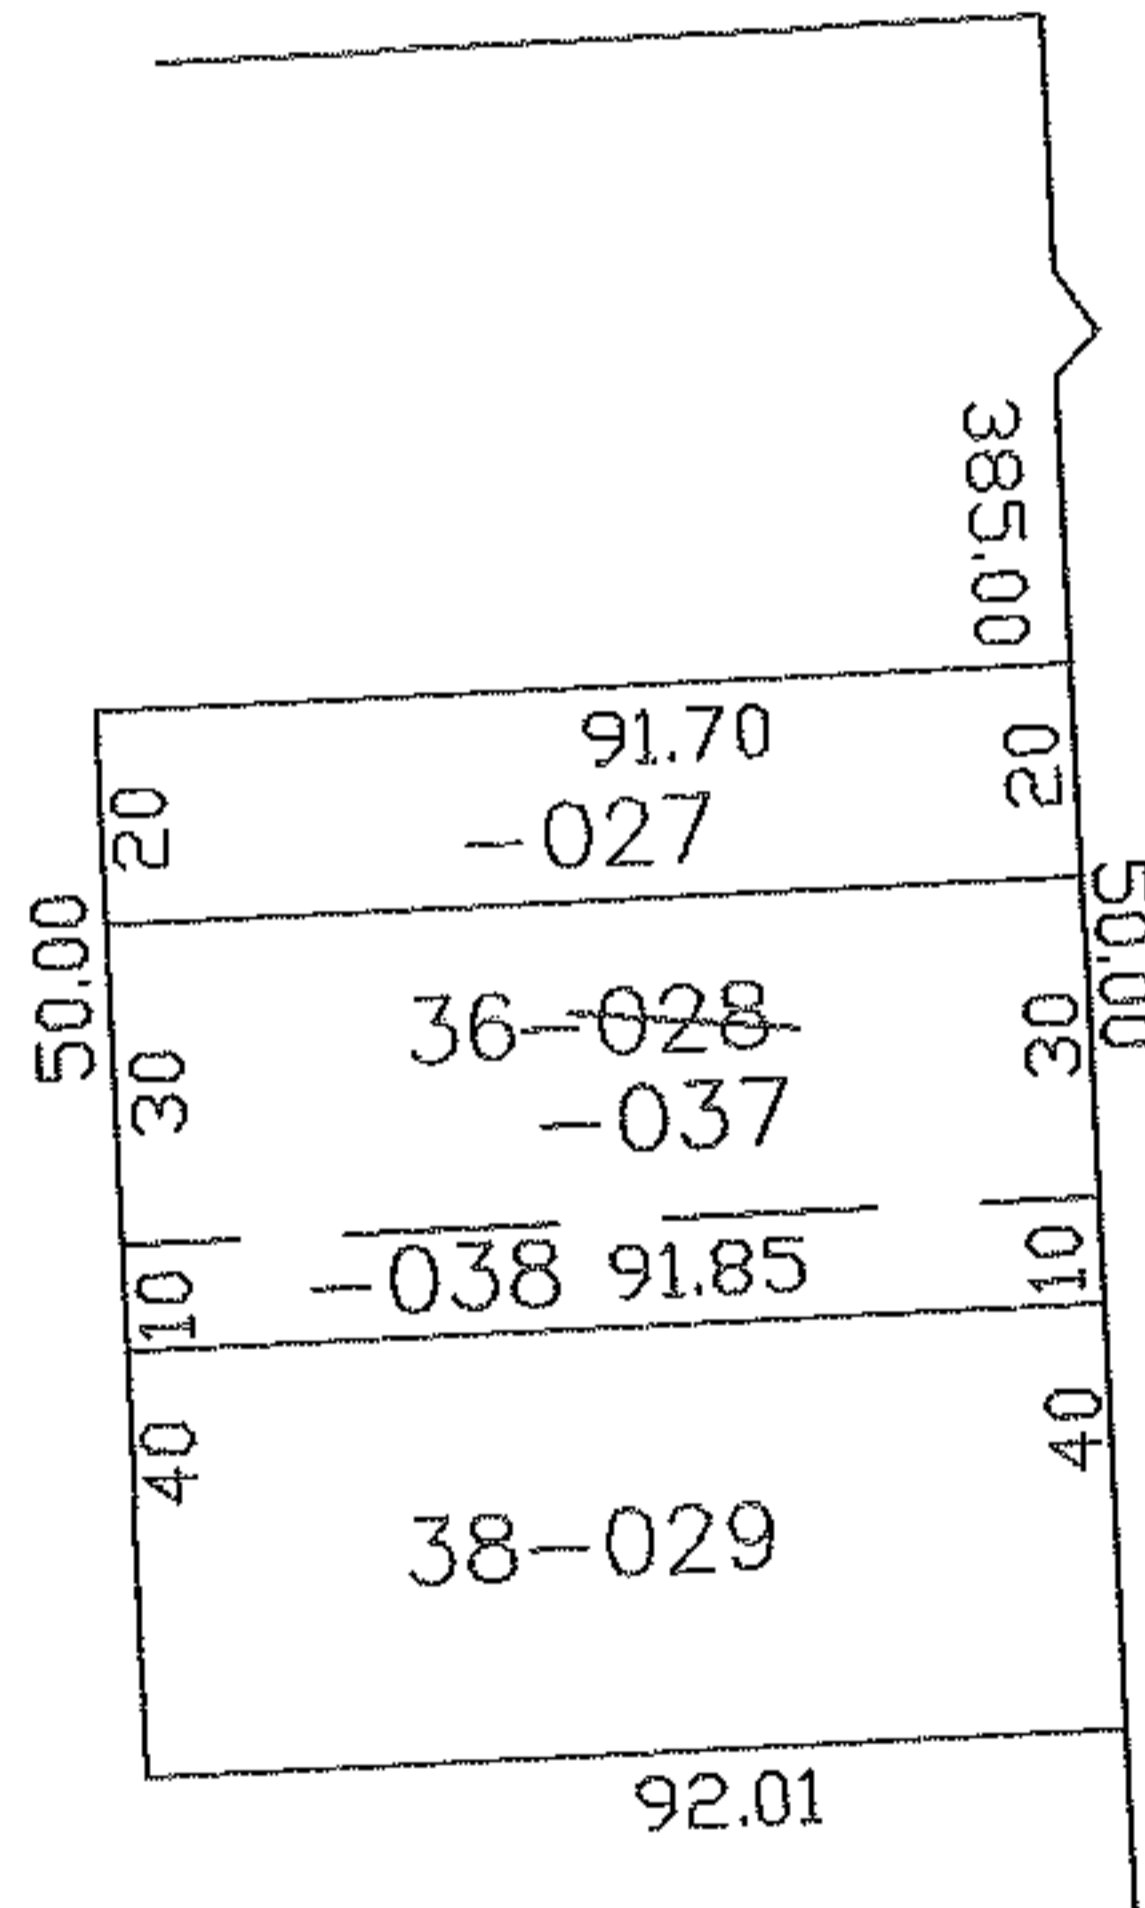

FOREST BLVD

SPLITS/DEEDS PROCESSED

LORAIN COUNTY TAX MAP DEPARTMENT
226 MIDDLE AVE. ELYRIA, OHIO

SURVEYED BY: DAVID ELWELL

CLOSURE: 0.00 : 10.000

MAP PAGE(S): 04-00-030-A

APPROVED BY: JAH DATE: 6-11-07

SCALE: 1" = 100 PRIOR INSTRUMENT: 20070196823