


PARENT PARCEL: 11-00-005-000-045

CHILD PARCEL: 11-00-005-000-080, -081

STARTING POINT: CENTERLINE OF COWLEY RD & O.L. 5

07-02398

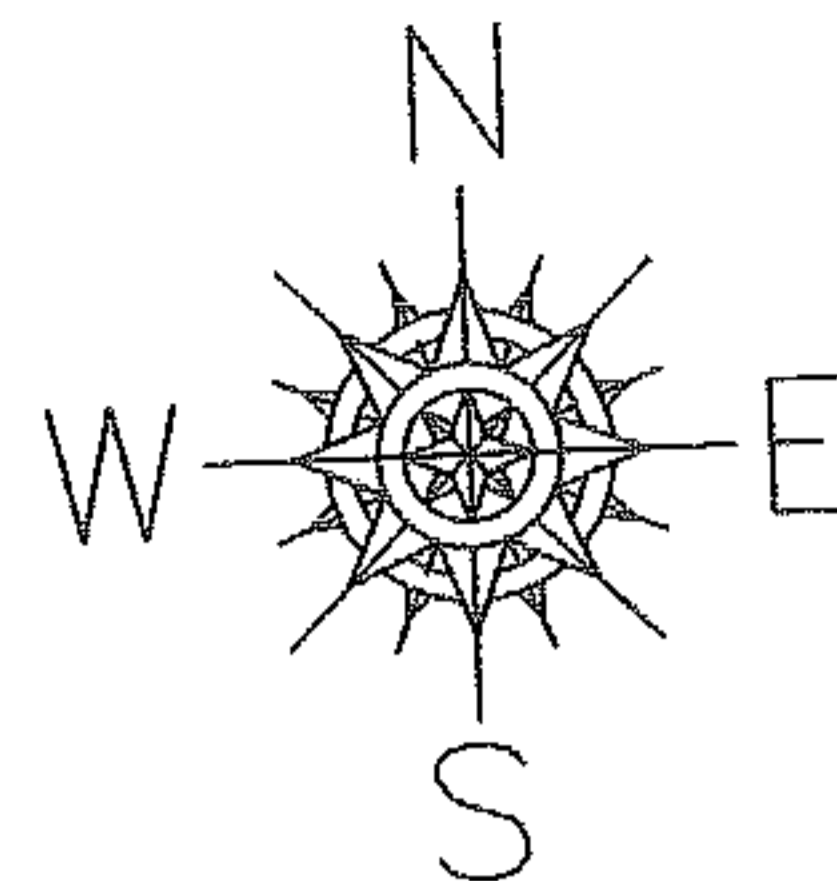

COWLEY RD

220.00

284.24

250.00

-080
1.26 A.

220.00

250.00

~~-045~~
~~25.48 A.~~
-081
24.22 A.

O.L. 5

O.L. 4

SPLITS/DEEDS PROCESSED

LORAIN COUNTY TAX MAP DEPARTMENT
226 MIDDLE AVE. ELYRIA, OHIO

SURVEYED BY: RICHARD CARLSON

CLOSURE: 0.00 : 10,000

MAP PAGE(S): 11-00-005-H

APPROVED BY: JAH DATE: 6-15-07

SCALE: 1" = 100 PRIOR INSTRUMENT: 20050099958