


RASTER

PARENT PARCEL: 02-01-006-189-034


CHILD PARCEL:

11-02399-D

STARTING POINT: SOUTHEAST CORNER OF FALBO SUB. (VOL.18 PG.17)

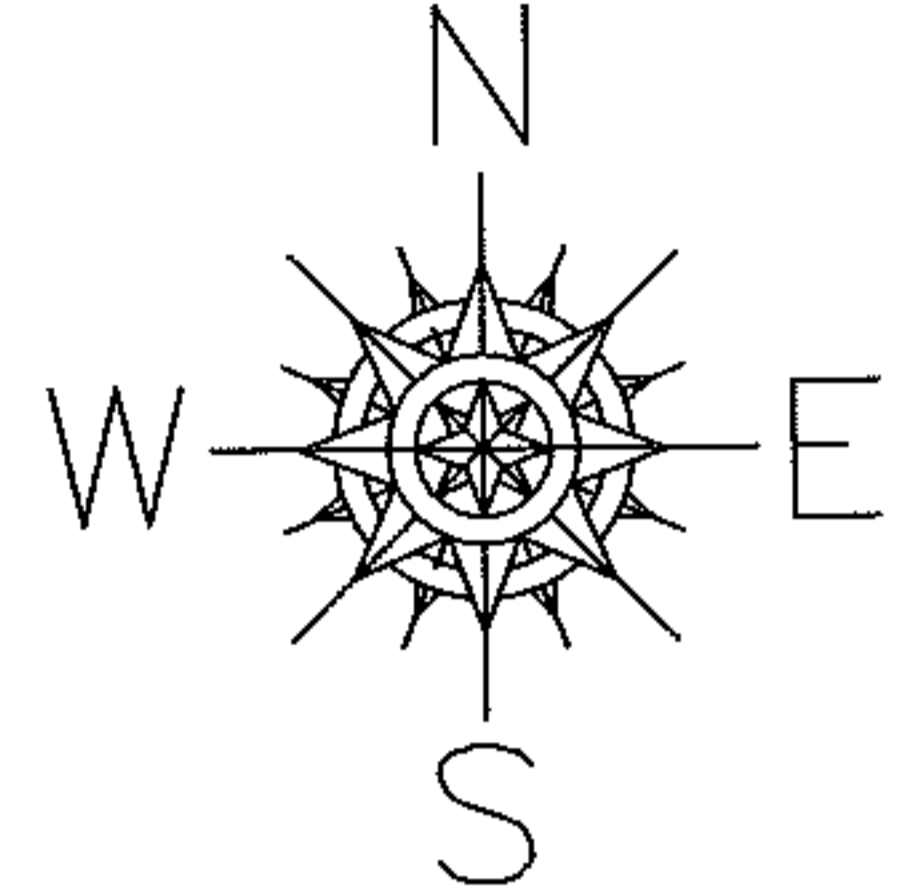

FALBO SUB.  
VOL.18 PG.17

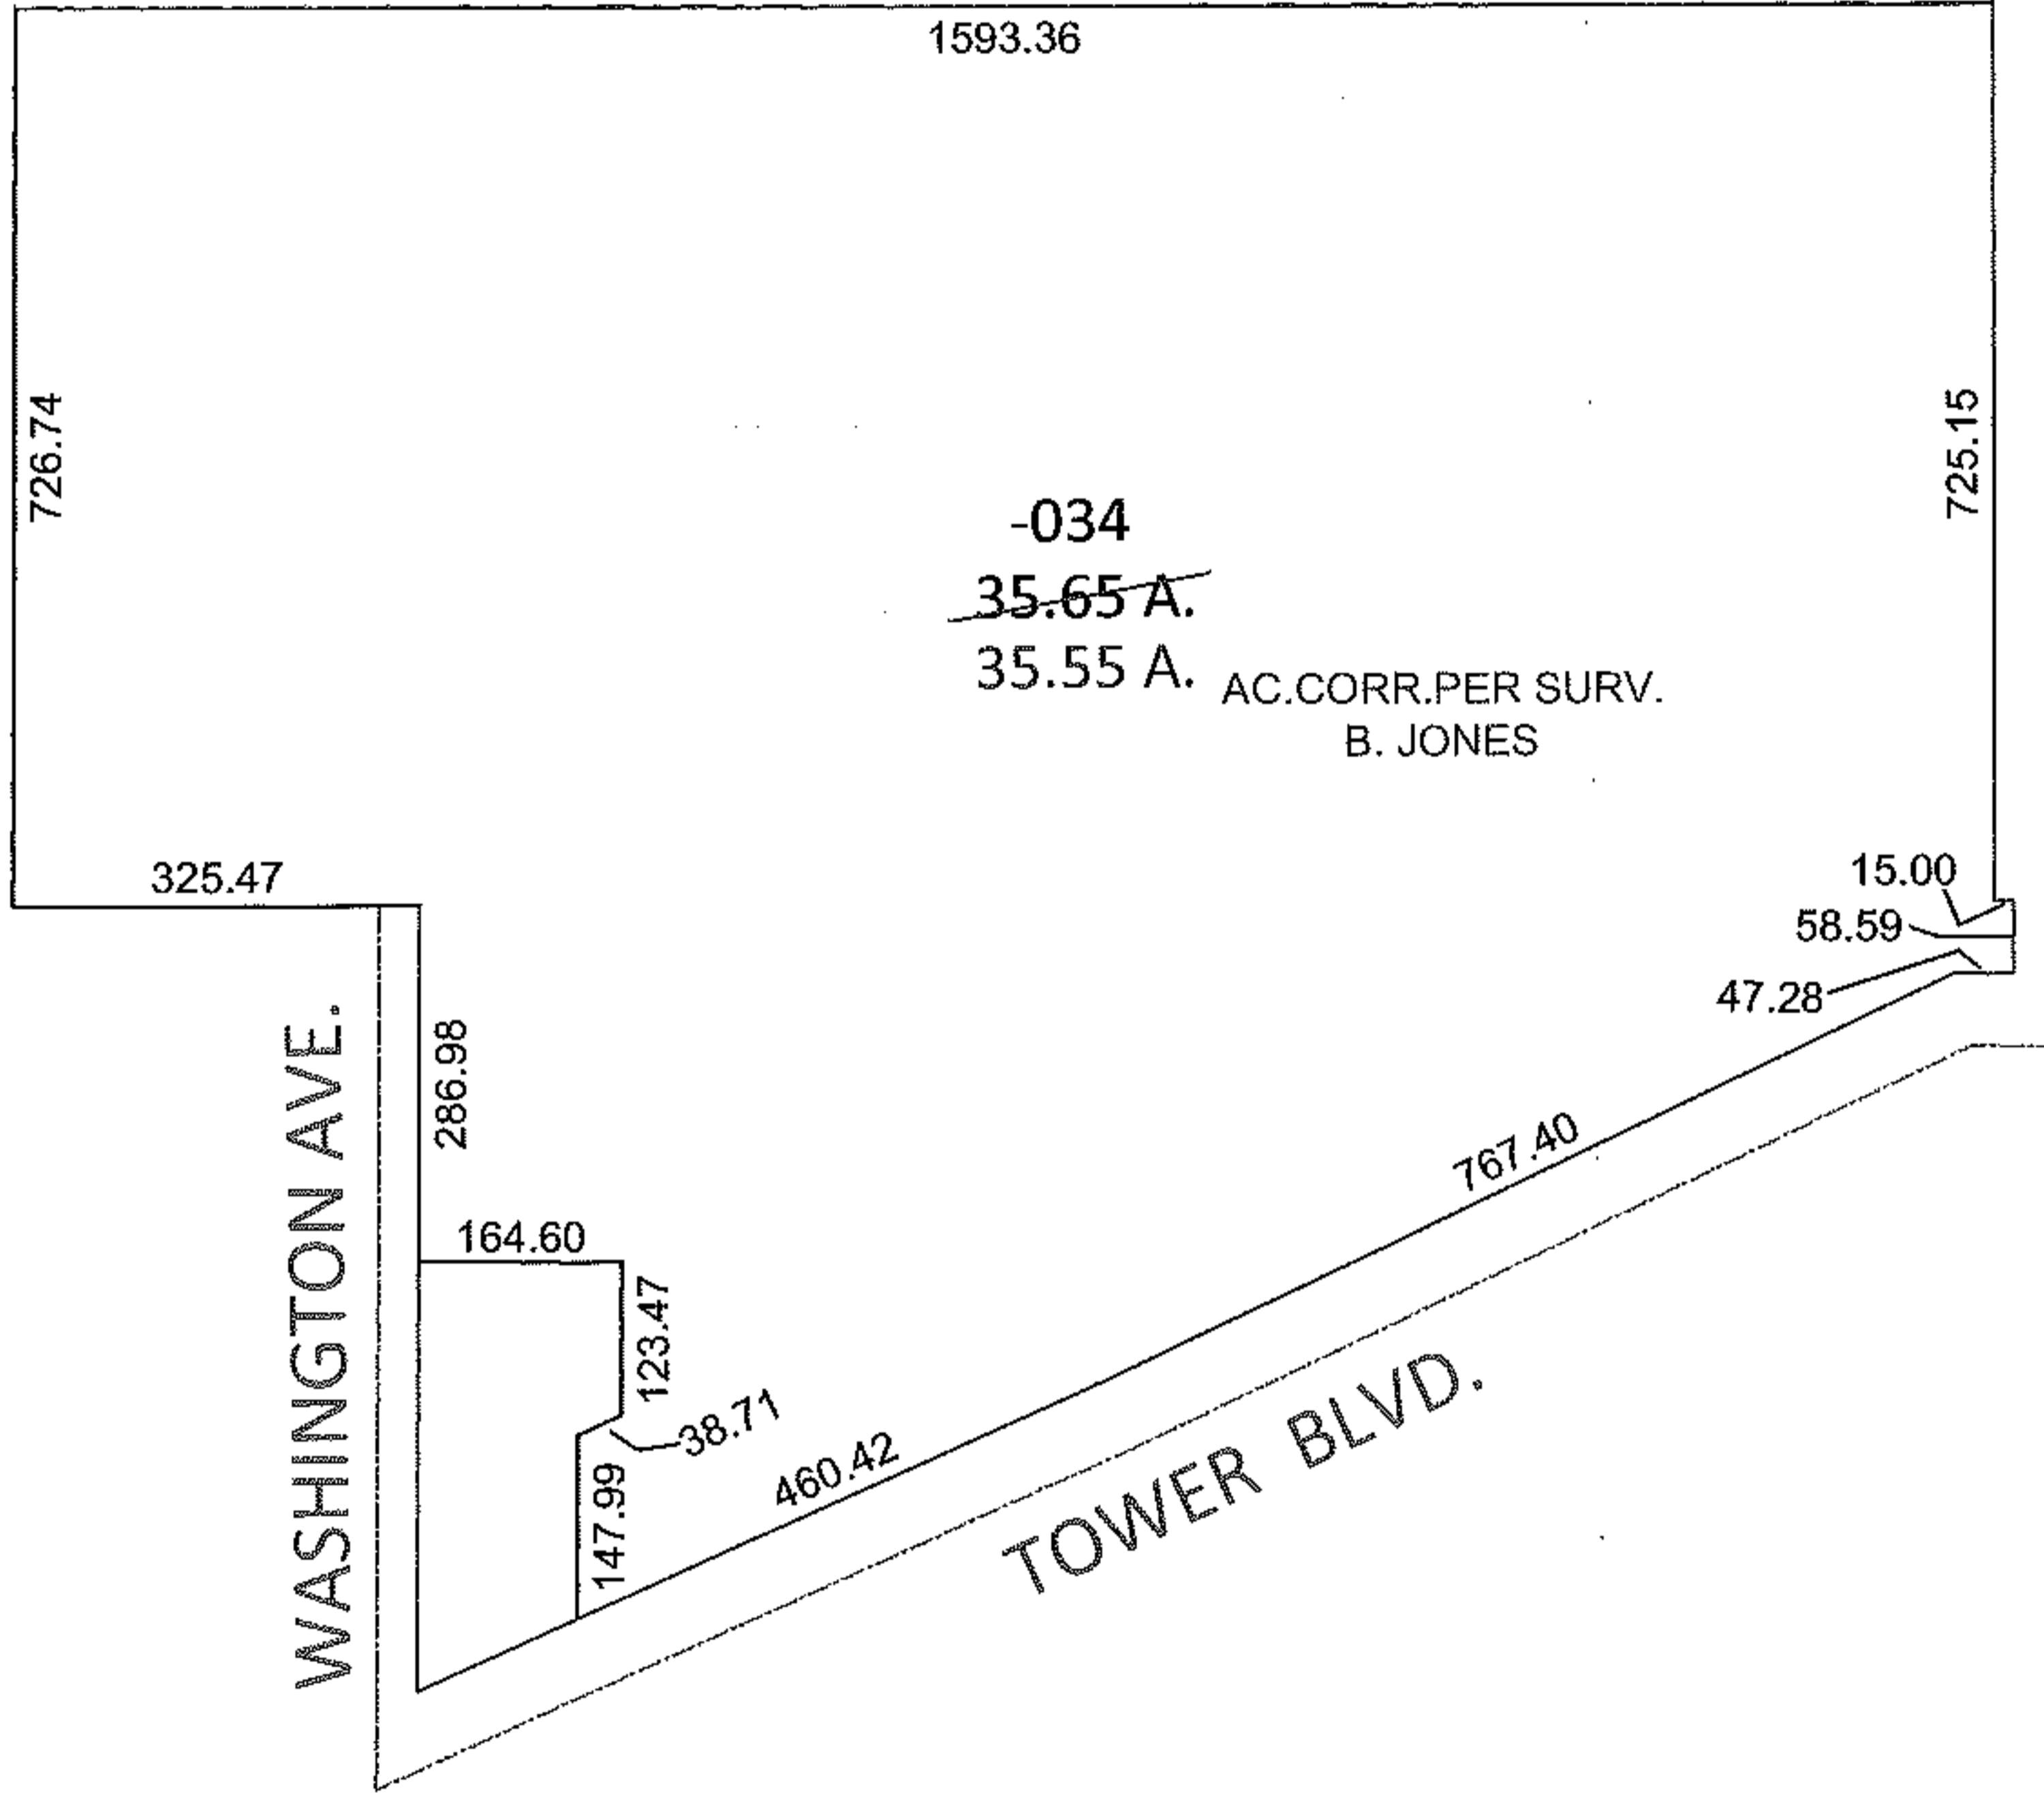

SPLITS/DEEDS PROCESSED

LORAIN COUNTY TAX MAP DEPARTMENT  
226 MIDDLE AVE. ELYRIA, OHIO

SURVEYED BY: BEMBA K. JONES

CLOSURE: .01:10,000

MAP PAGE(S): 2-01-006-G & H

APPROVED BY: RRM DATE: 11-30-11

SCALE: 1"= 300 PRIOR INST.: 20080238384