
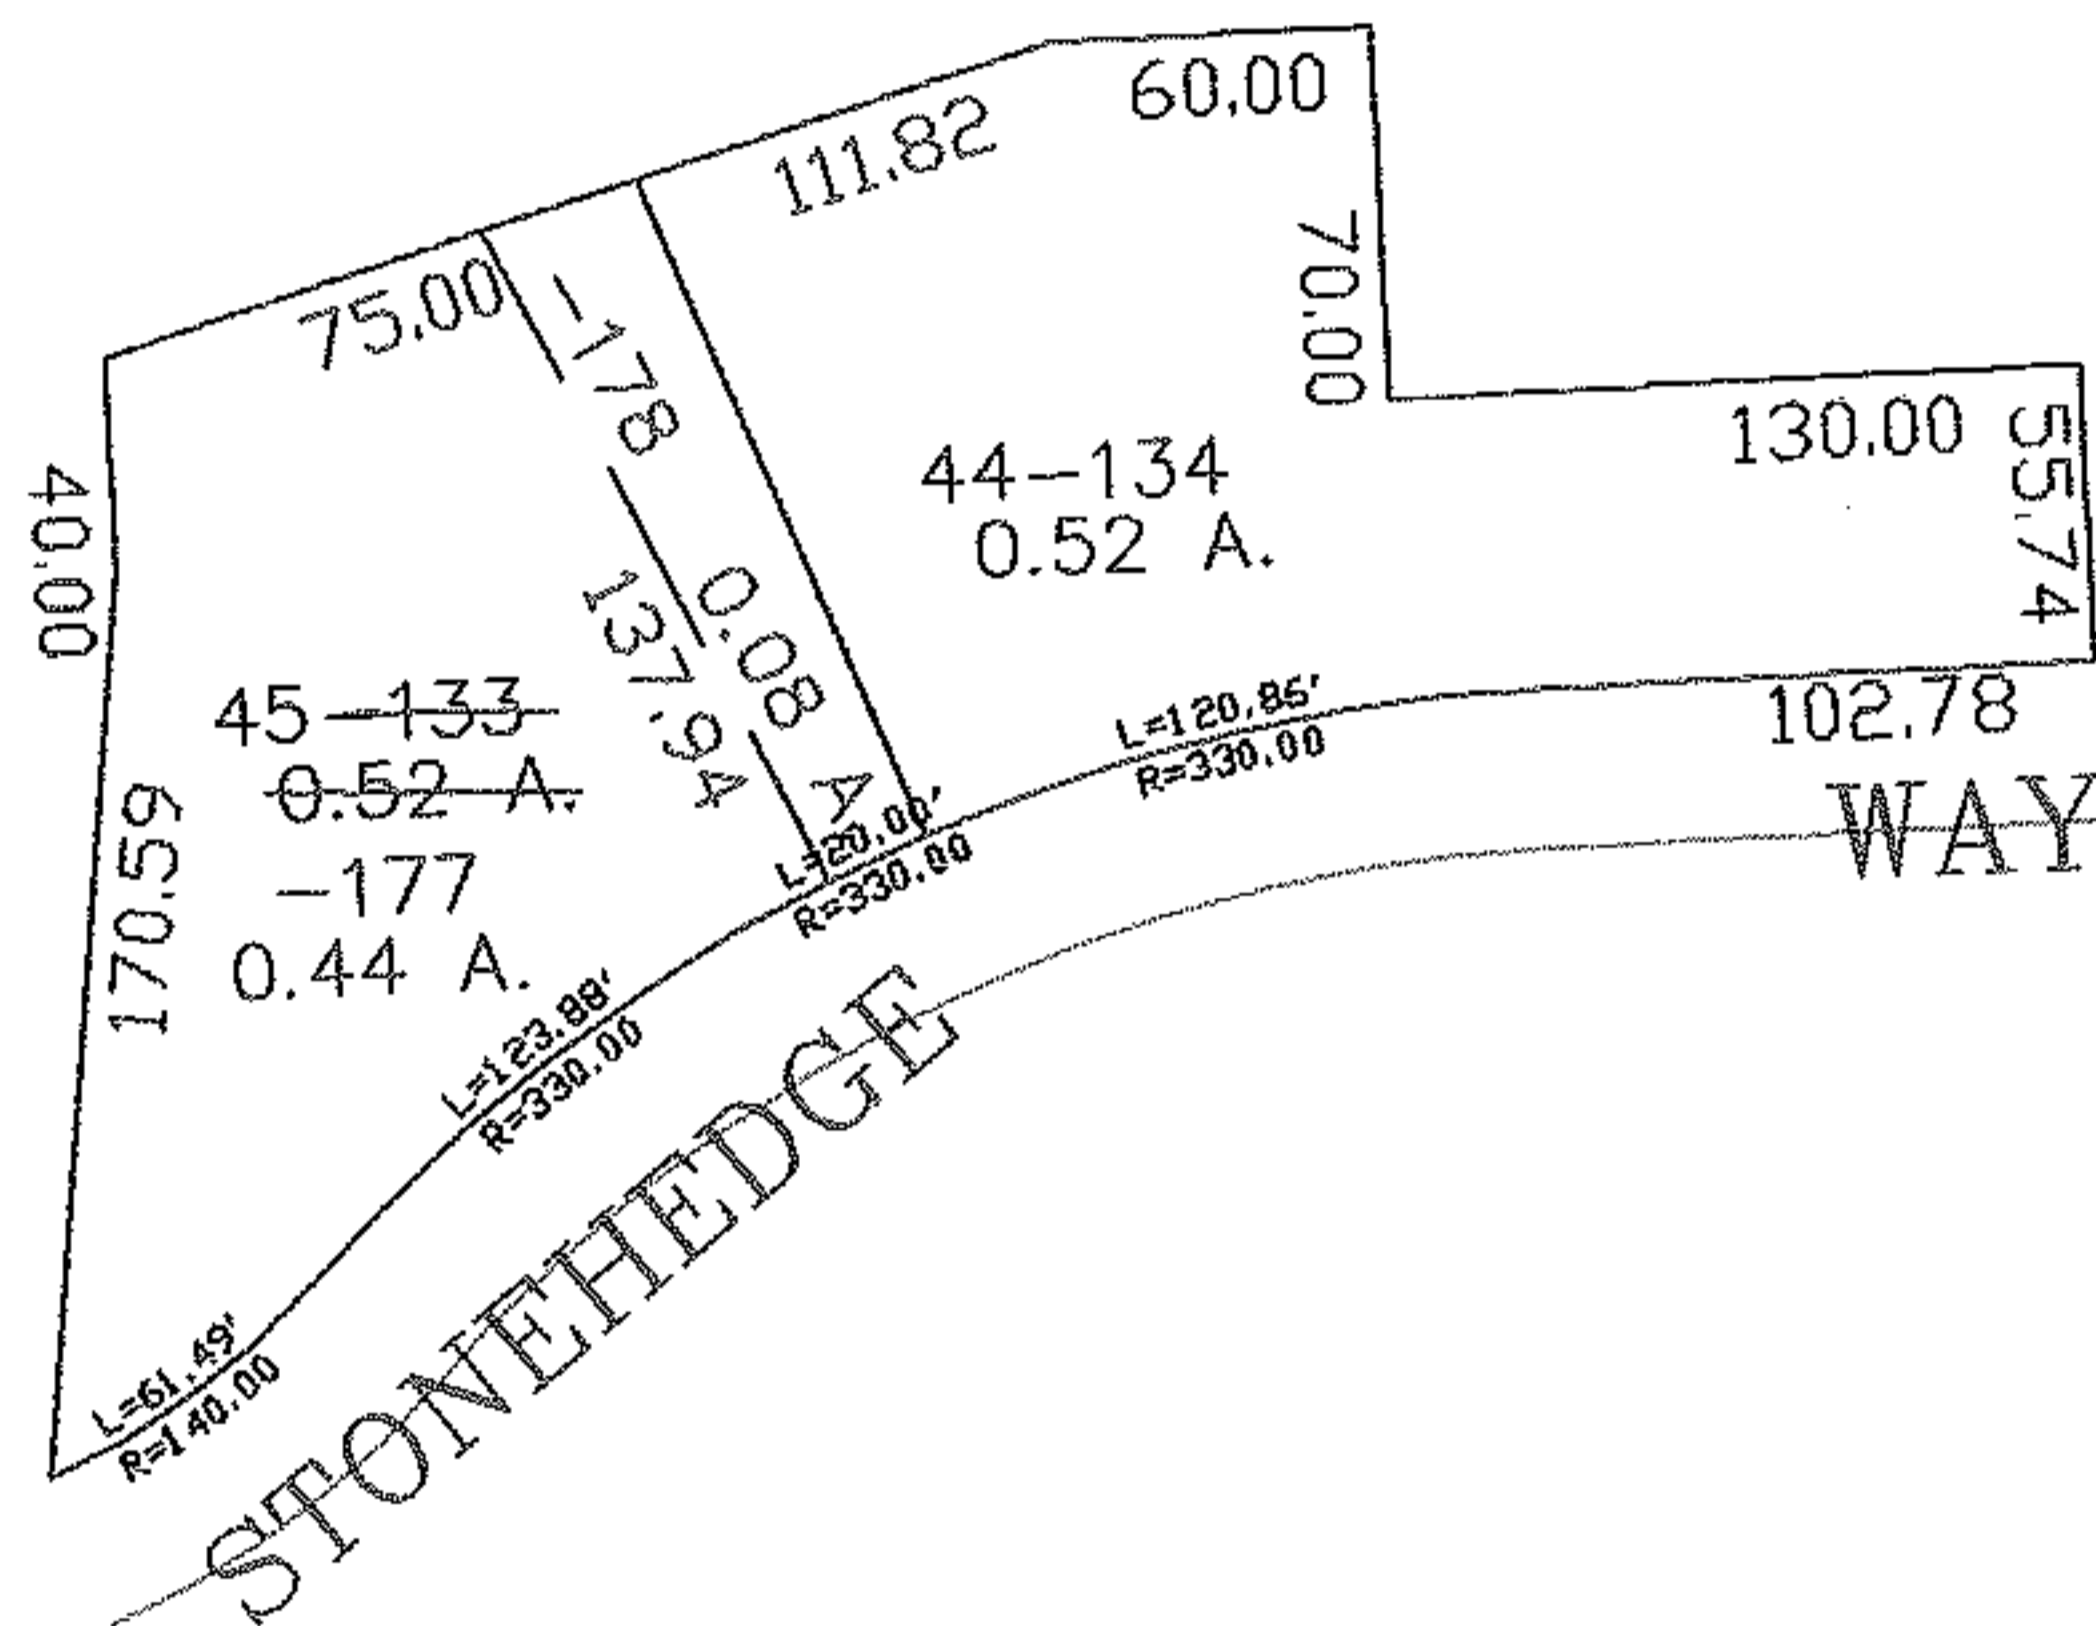


PARENT PARCEL: 05-00-016-101-133

CHILD PARCEL: 05-00-016-101-177, -178

STARTING POINT: SOUTHEAST CORNER OF S/L 46 IN KEMPTON WOODS EST

07-02399

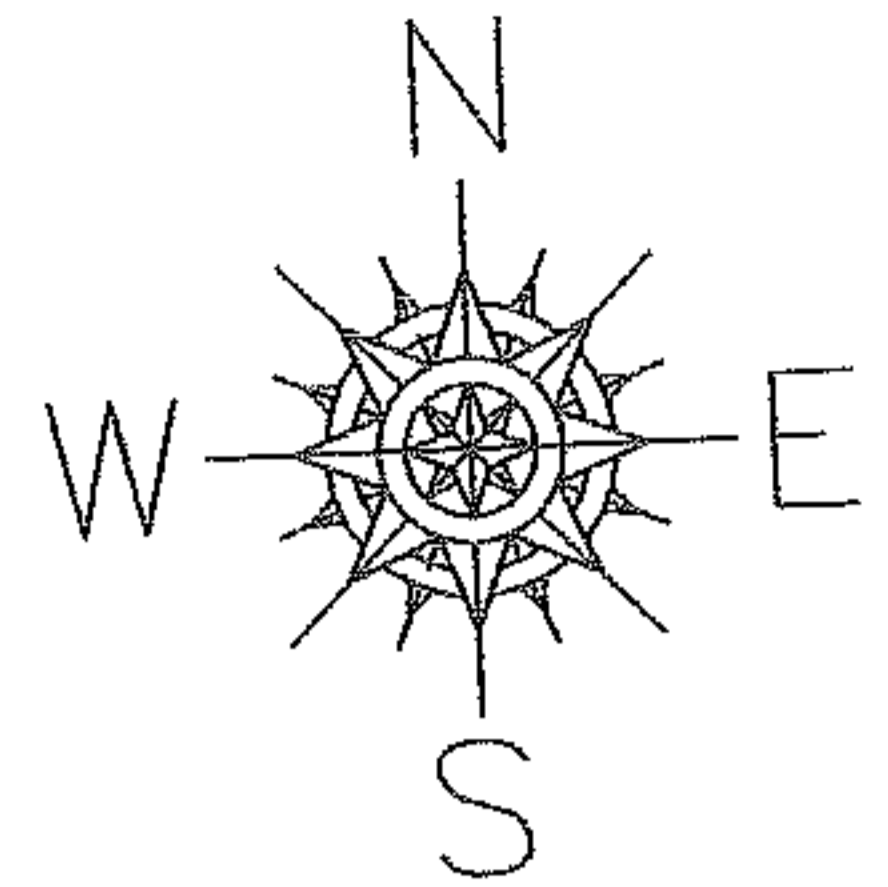

SPLITS/DEEDS PROCESSED

LORAIN COUNTY TAX MAP DEPARTMENT
226 MIDDLE AVE. ELYRIA, OHIO

SURVEYED BY: JAMES ROOT

CLOSURE: 0.00 : 10.000

MAP PAGE(S): 05-00-016-A

APPROVED BY: JAH DATE: 6-18-07

SCALE: 1" = 100 PRIOR INSTRUMENT: 20010784457