



MASTER

PARENT PARCEL: 04-00-004-101-049, -037, -045, -043

CHILD PARCEL: 04-00-004-101-065 THRU -072

STARTING POINT: CENTERLINE OF MILLER RD & O.L. 4

07-02400

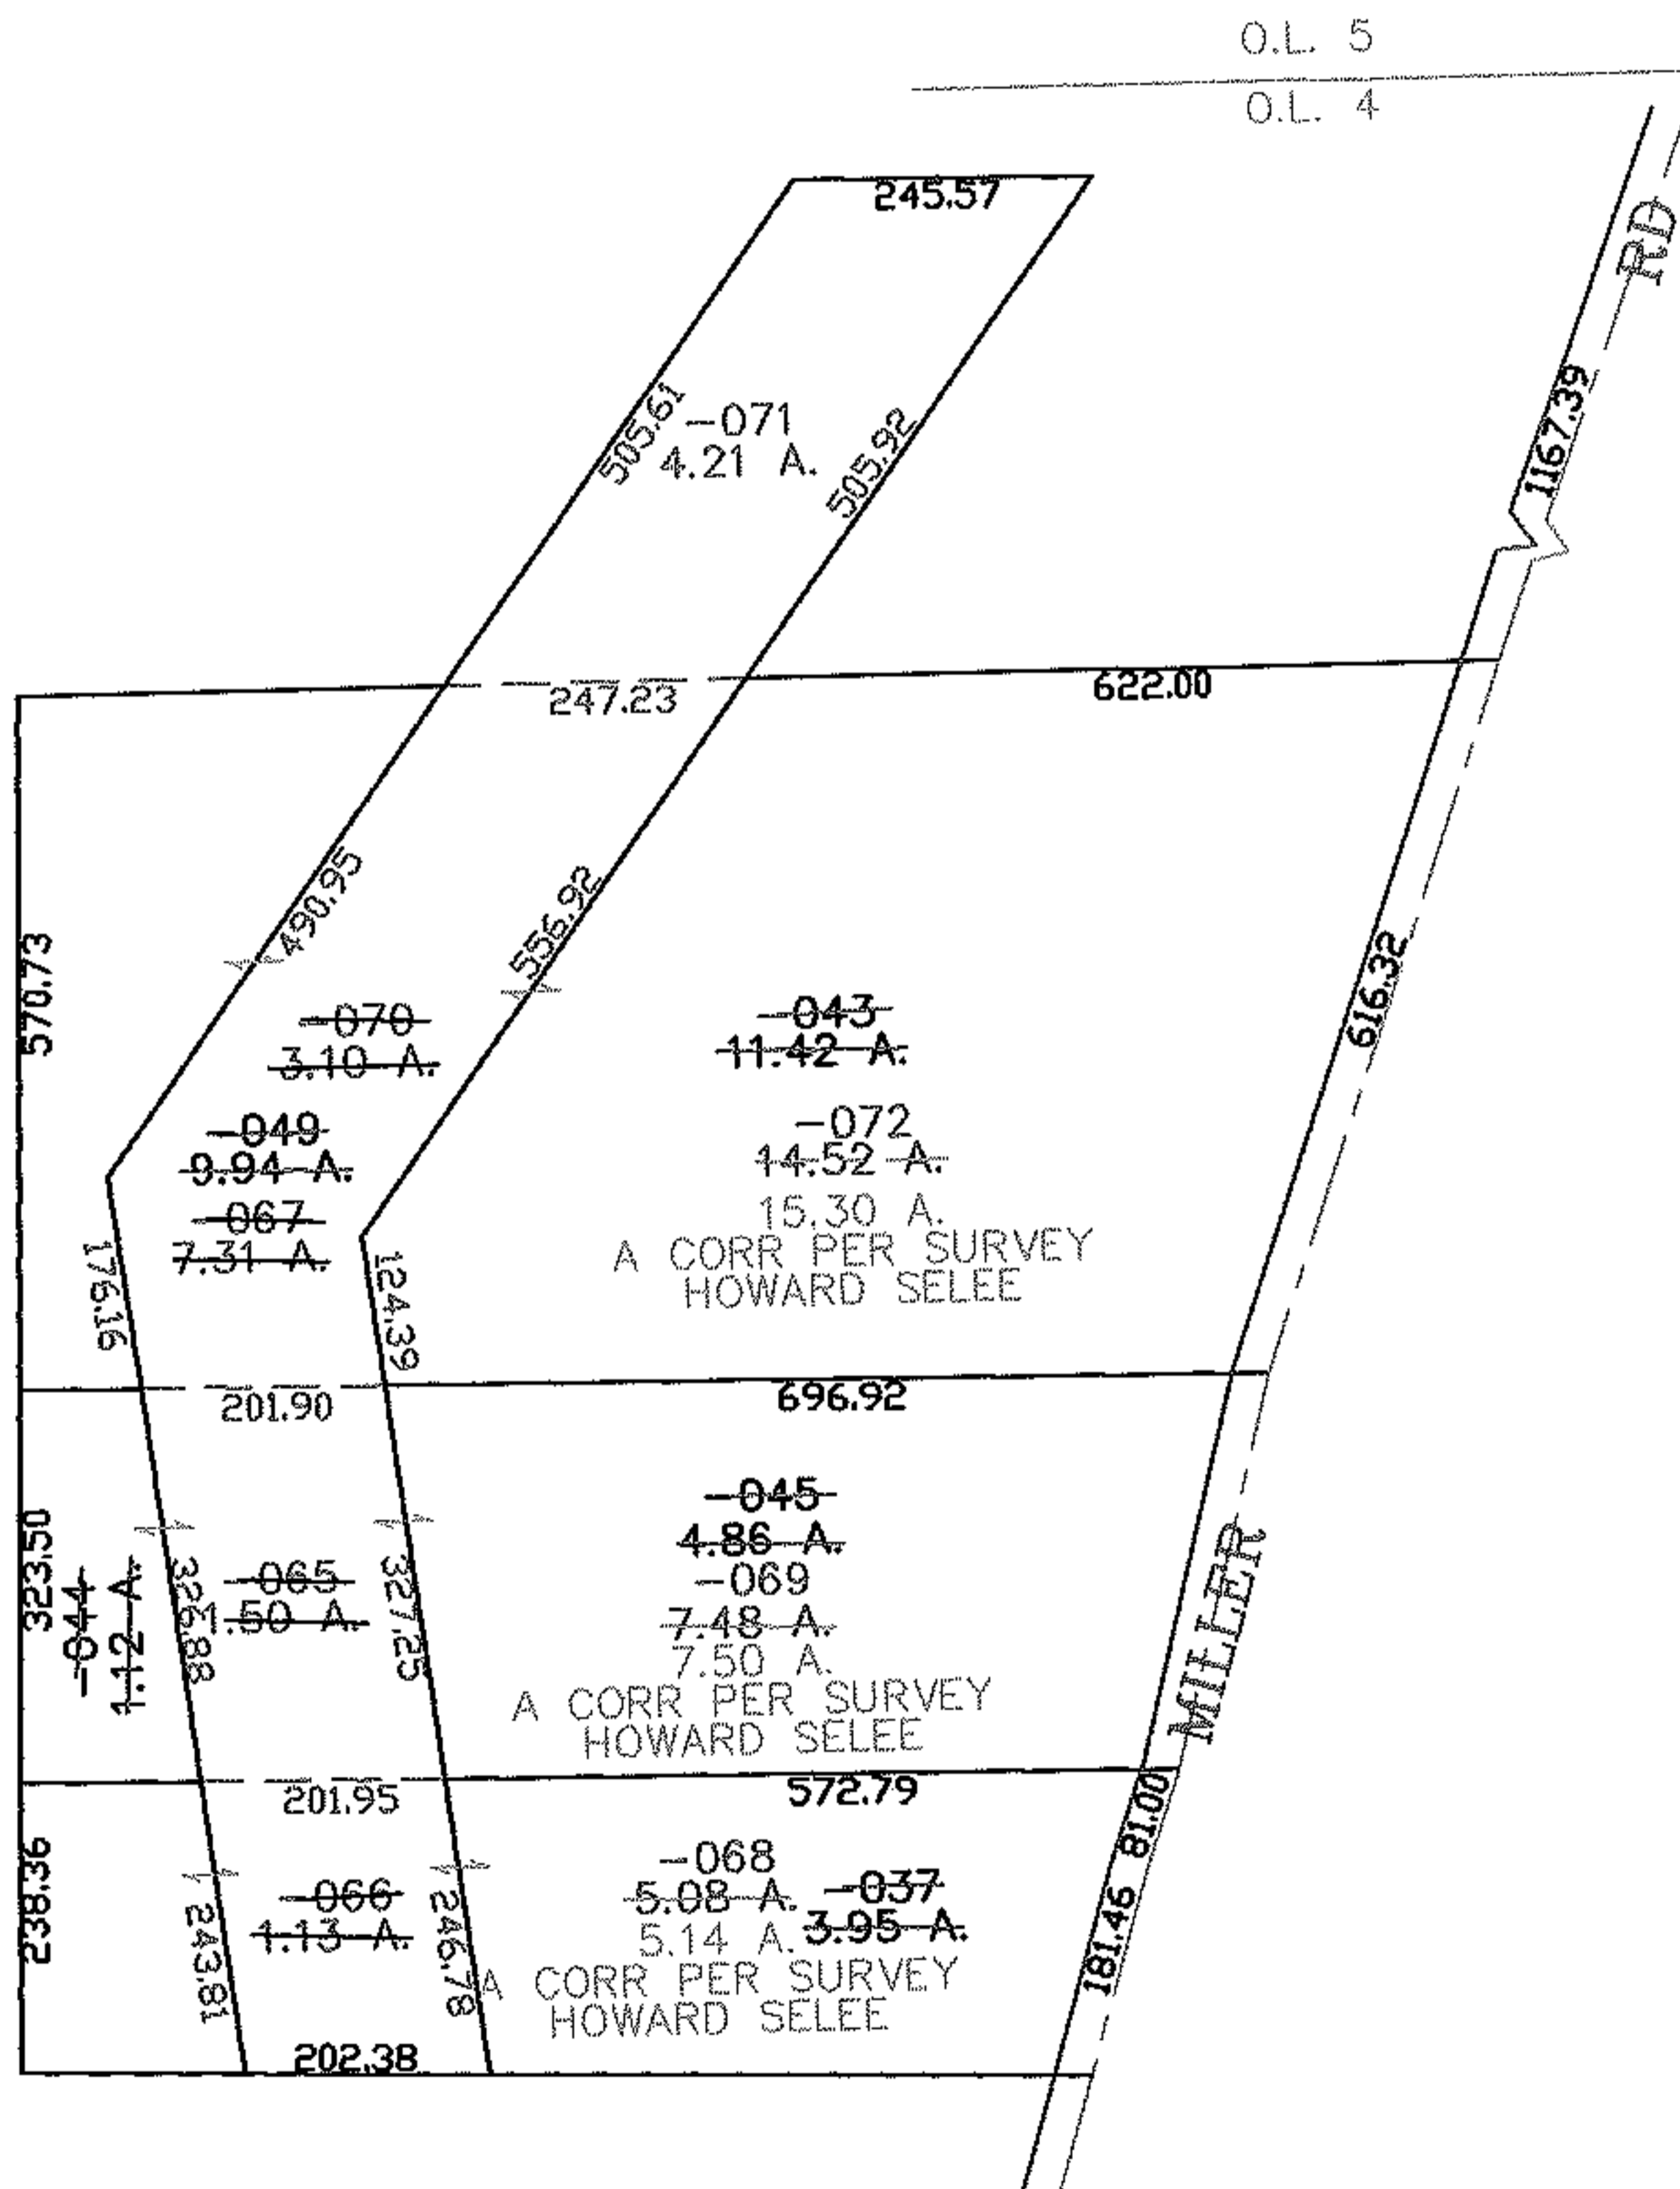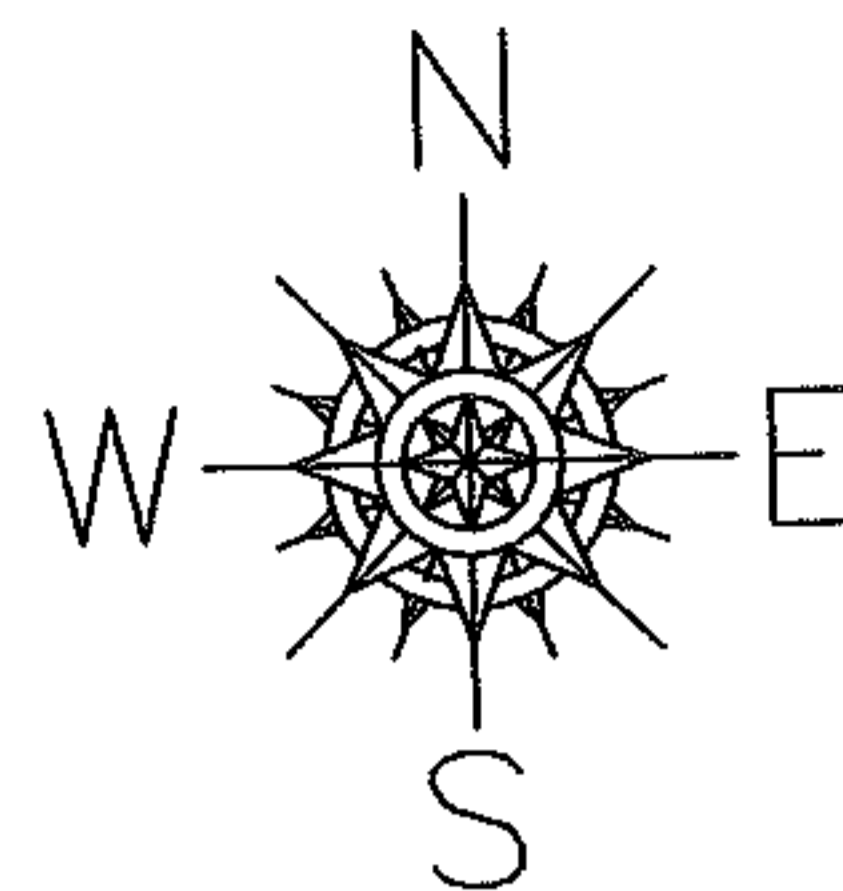

SPLITS/DEEDS PROCESSED

LORAIN COUNTY TAX MAP DEPARTMENT
226 MIDDLE AVE. ELYRIA, OHIO

SURVEYED BY: HOWARD SELEE
 CLOSURE: 0.00 : 10.000
 MAP PAGE(S): 04-00-004-A
 APPROVED BY: JAH DATE: 8-7-07
 SCALE: 1" = 300 PRIOR INSTRUMENT: DV 959/249